


NOTE
 ALL EMERGENCY LIGHTS LOCATED WITHIN THE AREAS ILLUMINATED BY TYPE D3 FITTINGS ARE TO BE PROVIDED WITH A RUN-ON TIMER SUCH THAT UPON THE RETURN OF POWER THEY RUN ON FOR A FURTHER 15 MINUTES.

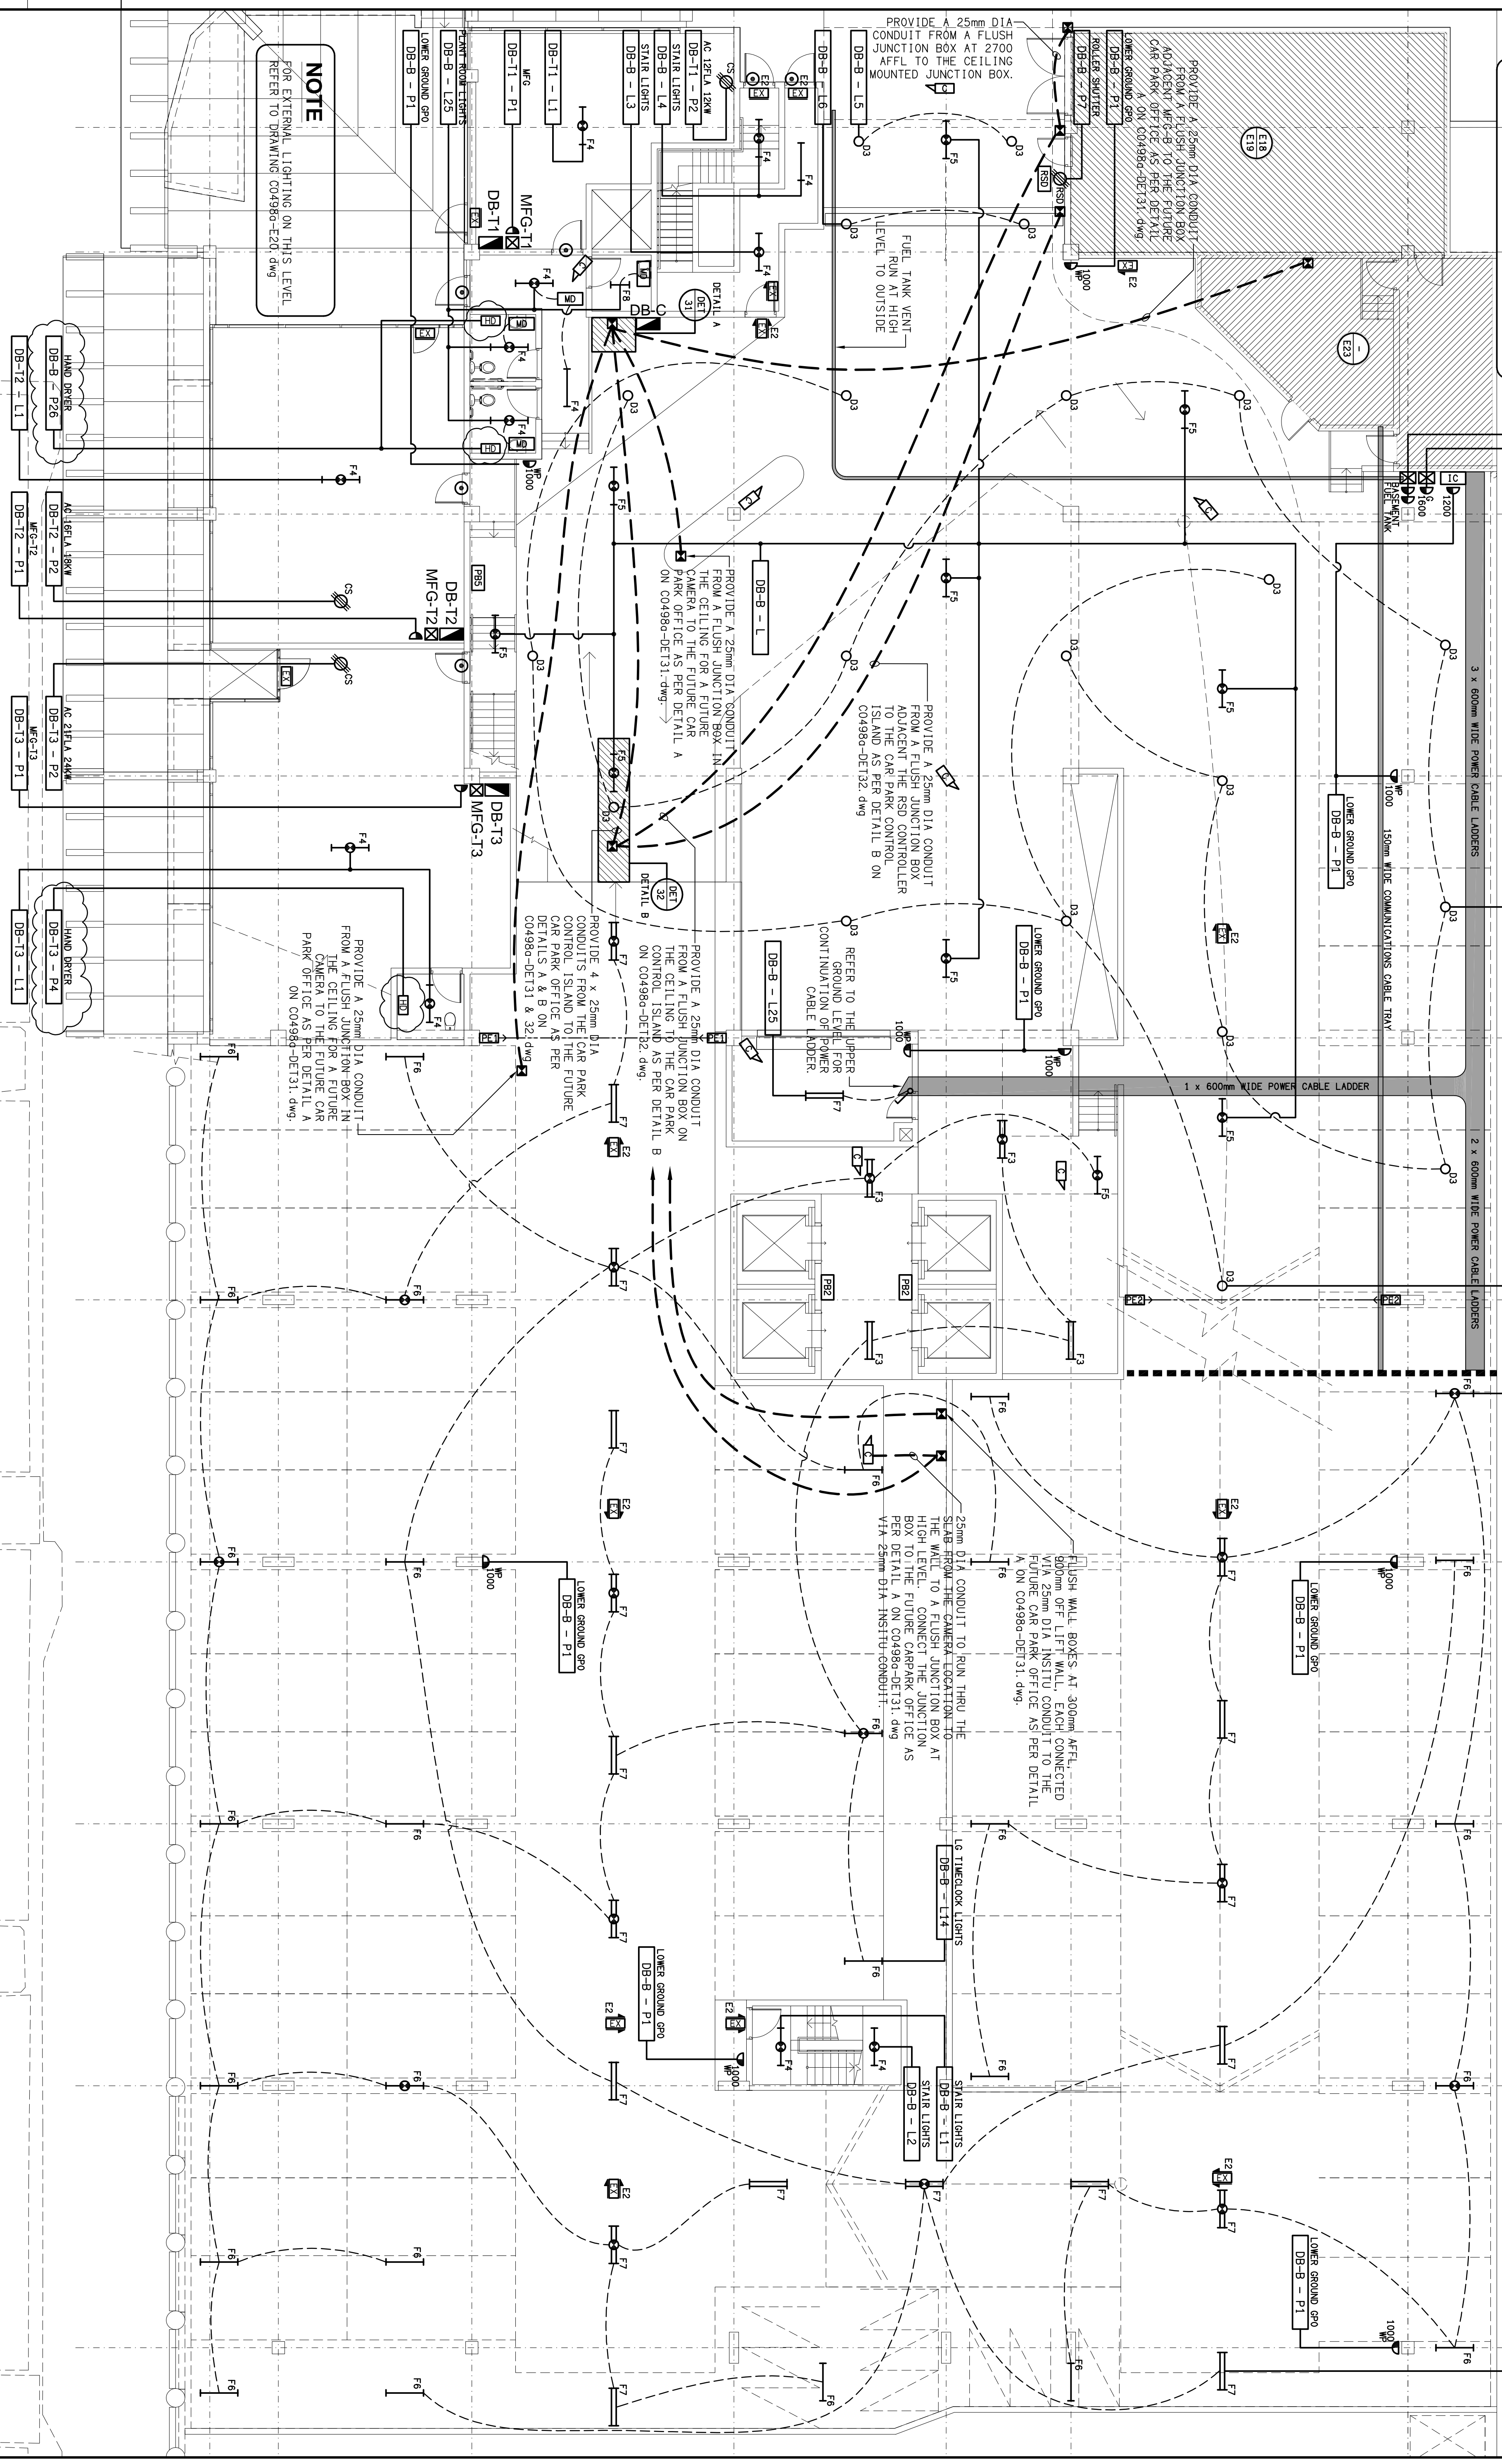

NOTE
 FOR EXTERNAL LIGHTING ON THIS LEVEL REFER TO DRAWING C04986-E20.dwg

OFFICE USE ONLY:
 MARKUP: _____ DRAFT: _____ CHECK: _____
 ELECTRICAL DESIGN GROUP BRISBANE
 PIV LTD
 ADV 052 710 793
 TRADING AS
 ELECTRICAL DESIGN GROUP

THE COPYRIGHT OF THIS DRAWING REMAINS THE PROPERTY OF THE ELECTRICAL DESIGN GROUP.
 USE FIGURED DIMENSIONS IN PREFERENCE TO SCALE.
 ALL DIMENSIONS TO BE VERIFIED ON SITE.

ELECTRICAL DESIGN GROUP
 ELECTRICAL COMMUNICATIONS FIRE SYSTEMS DESIGNERS
 BRISBANE
 P.O. Box 15, Sharnwood Q.4075
 Phone: (07) 3278 4375
 Fax: (07) 3716 0222

Product: **SYNERGY**
 LOTS 30 & 31 MUSK AVENUE, KELVIN GROVE URBAN VILLAGE

REV: _____
 G.1 CONSTRUCTION
 DATE: 05/08/2008
 DRAWING NO: **E05**
 PROJECT NO: **C04982**
 SCALE: 1:100
 AT A1
 REVISION: **G**