

OFFICE USE ONLY:  
 MARKUP:      DRAFT:      CHECK:

ELECTRICAL DESIGN GROUP BRISBANE  
 PTV LTD  
 10/10/10  
 TRADING AS  
 ELECTRICAL DESIGN GROUP


THE COPYRIGHT OF THIS DRAWING  
 REMAINS THE PROPERTY OF THE  
 ELECTRICAL DESIGN GROUP.  
 USE FIGURED DIMENSIONS  
 IN PREFERENCE TO SCALE.  
 ALL DIMENSIONS TO BE  
 VERIFIED ON SITE.

**ELECTRICAL DESIGN GROUP**  
 ELECTRICAL COMMUNICATIONS FIRE SYSTEMS DESIGNERS  
 BRISBANE  
 P.O. Box 15, Sherwood Q.4075  
 Phone: (07) 3278 4375  
 Fax: (07) 3716 0222

**ELECTRICAL DESIGN GROUP**  
 GOLD COAST  
 P.O. Box 4249, Almona Q.4214  
 Phone: (07) 5597 7551  
 Fax: (07) 5597 7552

PROJECT:  
**SYNERGY**  
 LOTS 30 & 31 MUSK AVENUE, KELVIN GROVE URBAN VILLAGE

SCALE:  
 1:50 UNO  
 AT A1  
 PROJECT NO:  
**C0498a**  
 DRAWING NO:  
**E21**  
 REVISION:  
**D**

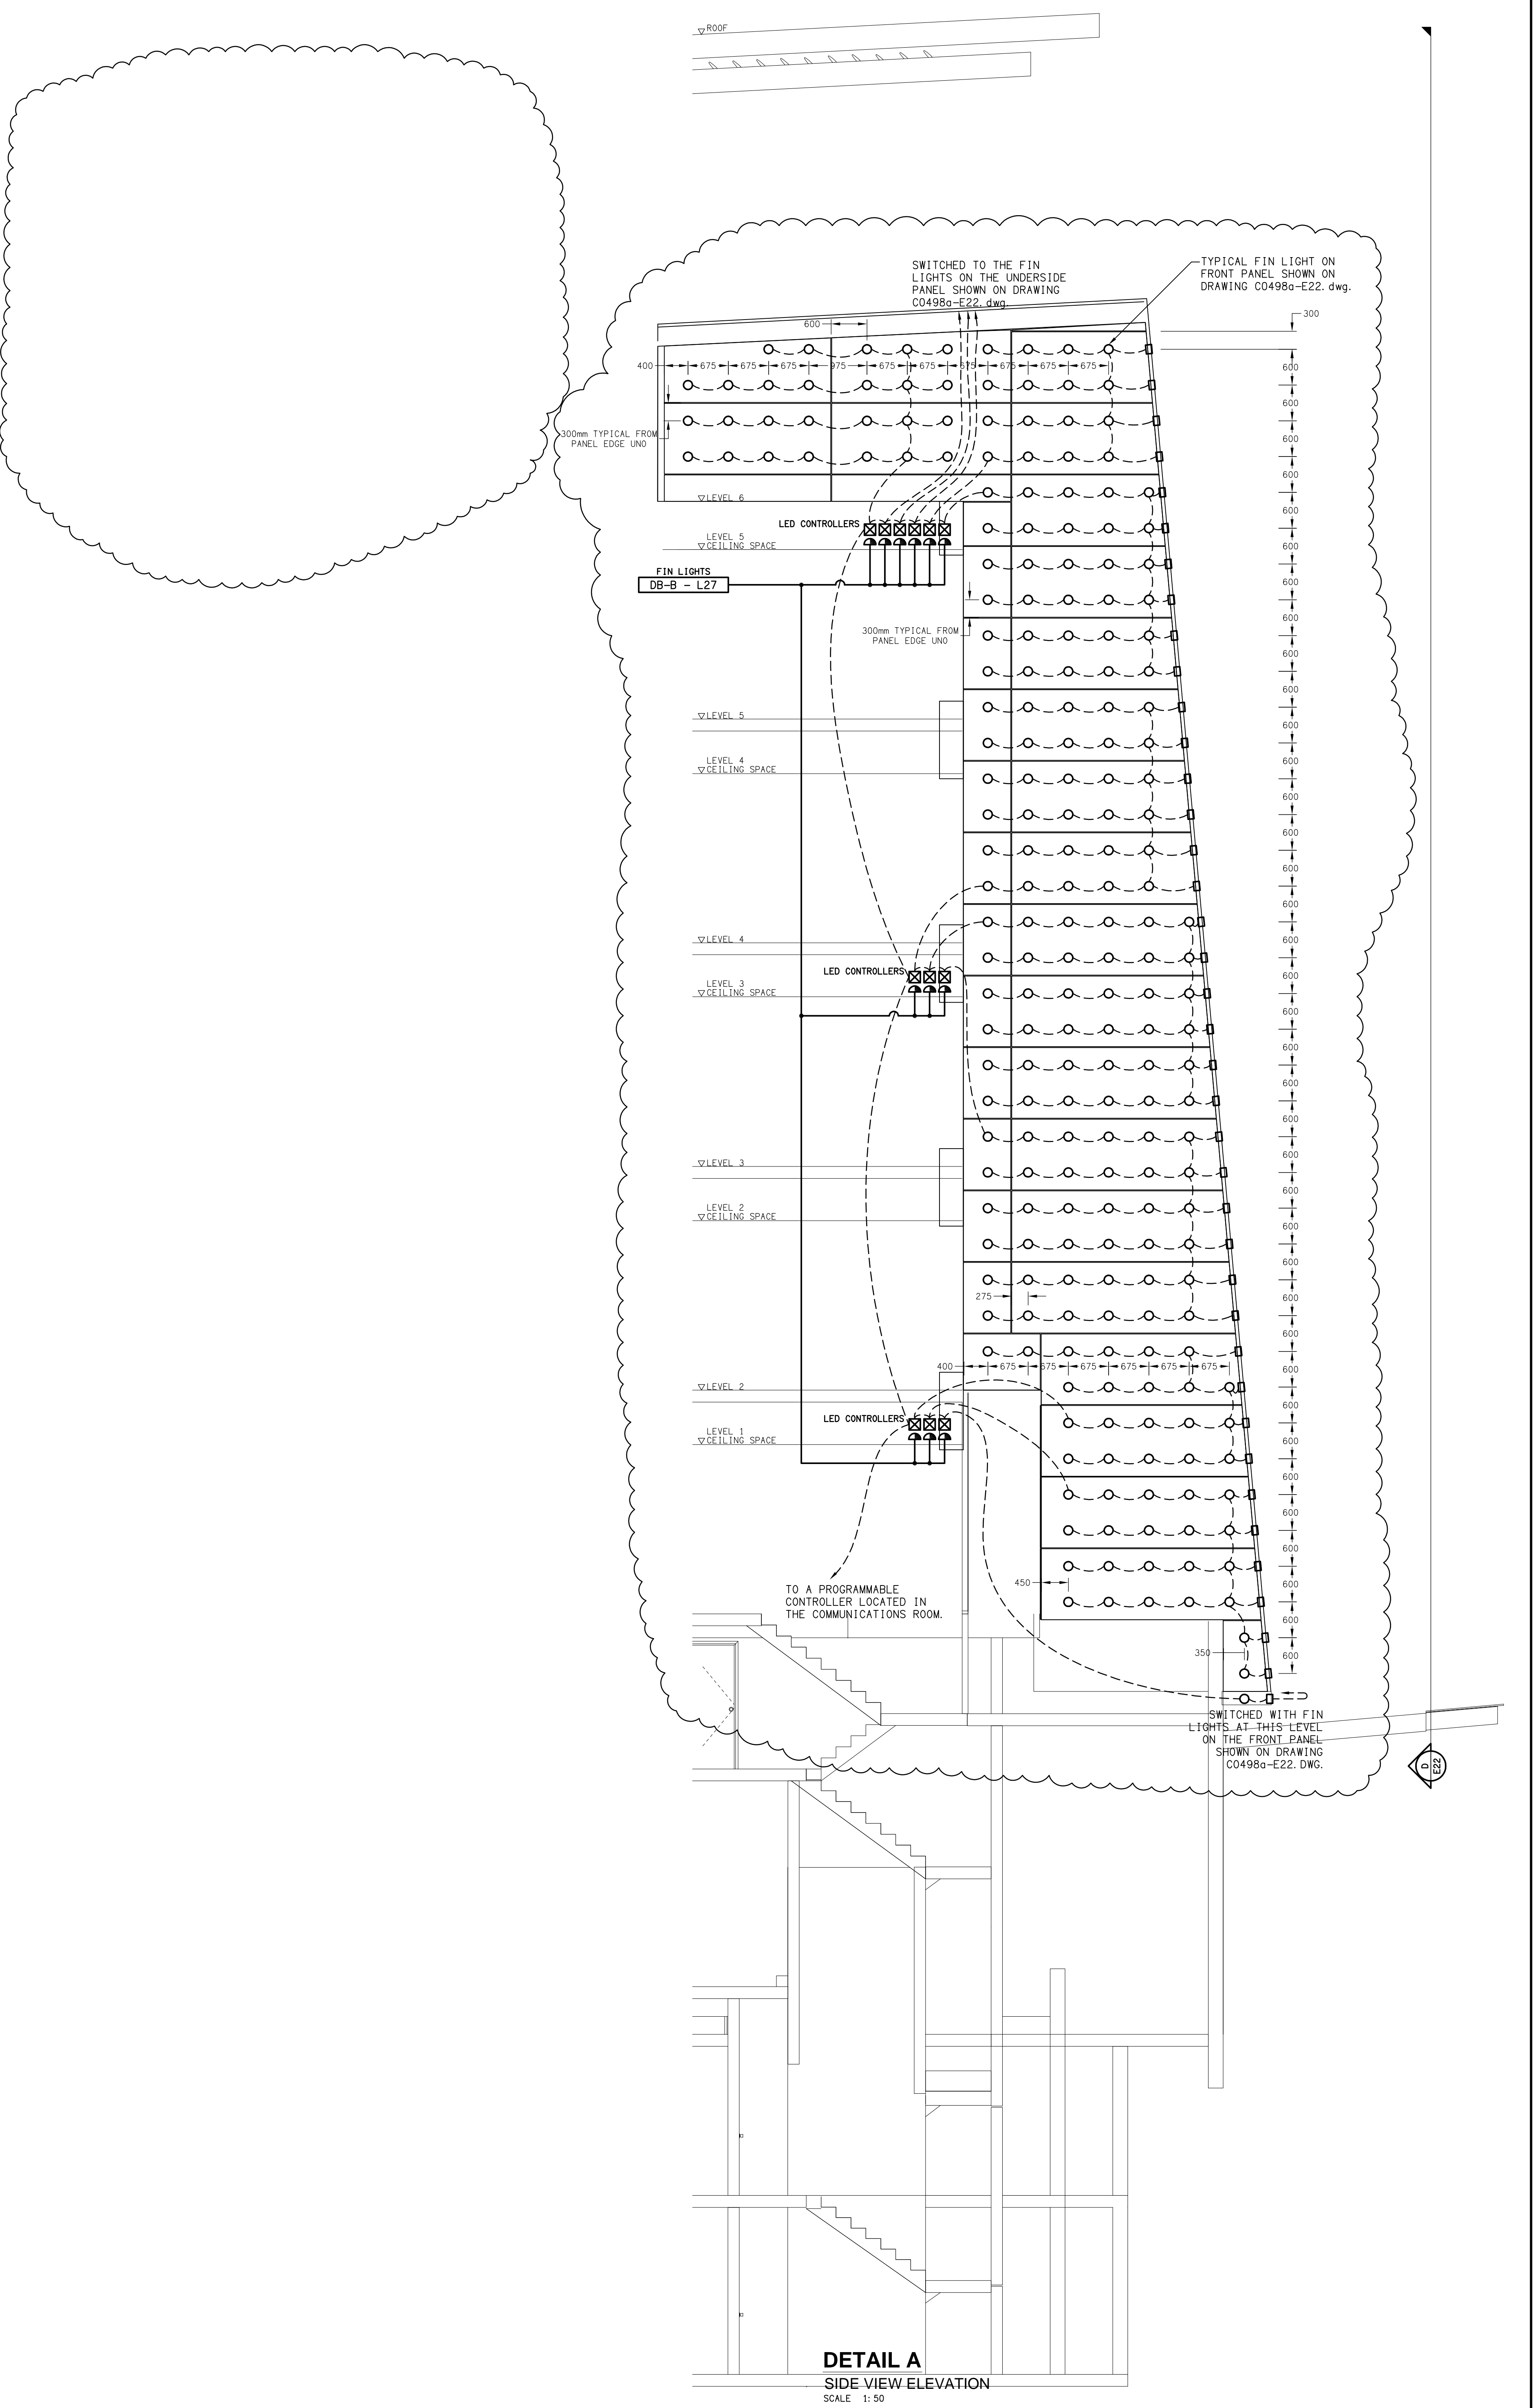

REV.	DESCRIPTION	DATE
D	CONSTRUCTION	23/04/2008