

OFFICE USE ONLY:  
 MARKUP:      DRAFT:      CHECK:

ELECTRICAL DESIGN GROUP BRISBANE  
 PTV LTD  
 1/10 7/93  
 TRADING AS  
 ELECTRICAL DESIGN GROUP

THE COPYRIGHT OF THIS DRAWING  
 REMAINS THE PROPERTY OF THE  
 ELECTRICAL DESIGN GROUP.  
 USE FIGURED DIMENSIONS  
 IN PREFERENCE TO SCALE.  
 ALL DIMENSIONS TO BE  
 VERIFIED ONSITE.

**ELECTRICAL DESIGN GROUP**  
 BRISBANE  
 P.O. Box 15, Sherwood Q.4075  
 Phone: (07) 5597 4375  
 Fax: (07) 5716 0222

**ELECTRICAL DESIGN GROUP**  
 ELECTRICAL COMMUNICATIONS FIRE SYSTEMS DESIGNERS  
 BRISBANE  
 P.O. Box 15, Sherwood Q.4075  
 Phone: (07) 5597 4375  
 Fax: (07) 5716 0222


Product:  
**SYNERGY**  
 LOTS 30 & 31 MUSK AVENUE, KELVIN GROVE URBAN VILLAGE

SCALE:  
 1:50 UNO      AT A1

PROJECT NO:  
**C0498a**

DRAWING NO:  
**E22**

REVISION:  
**E**

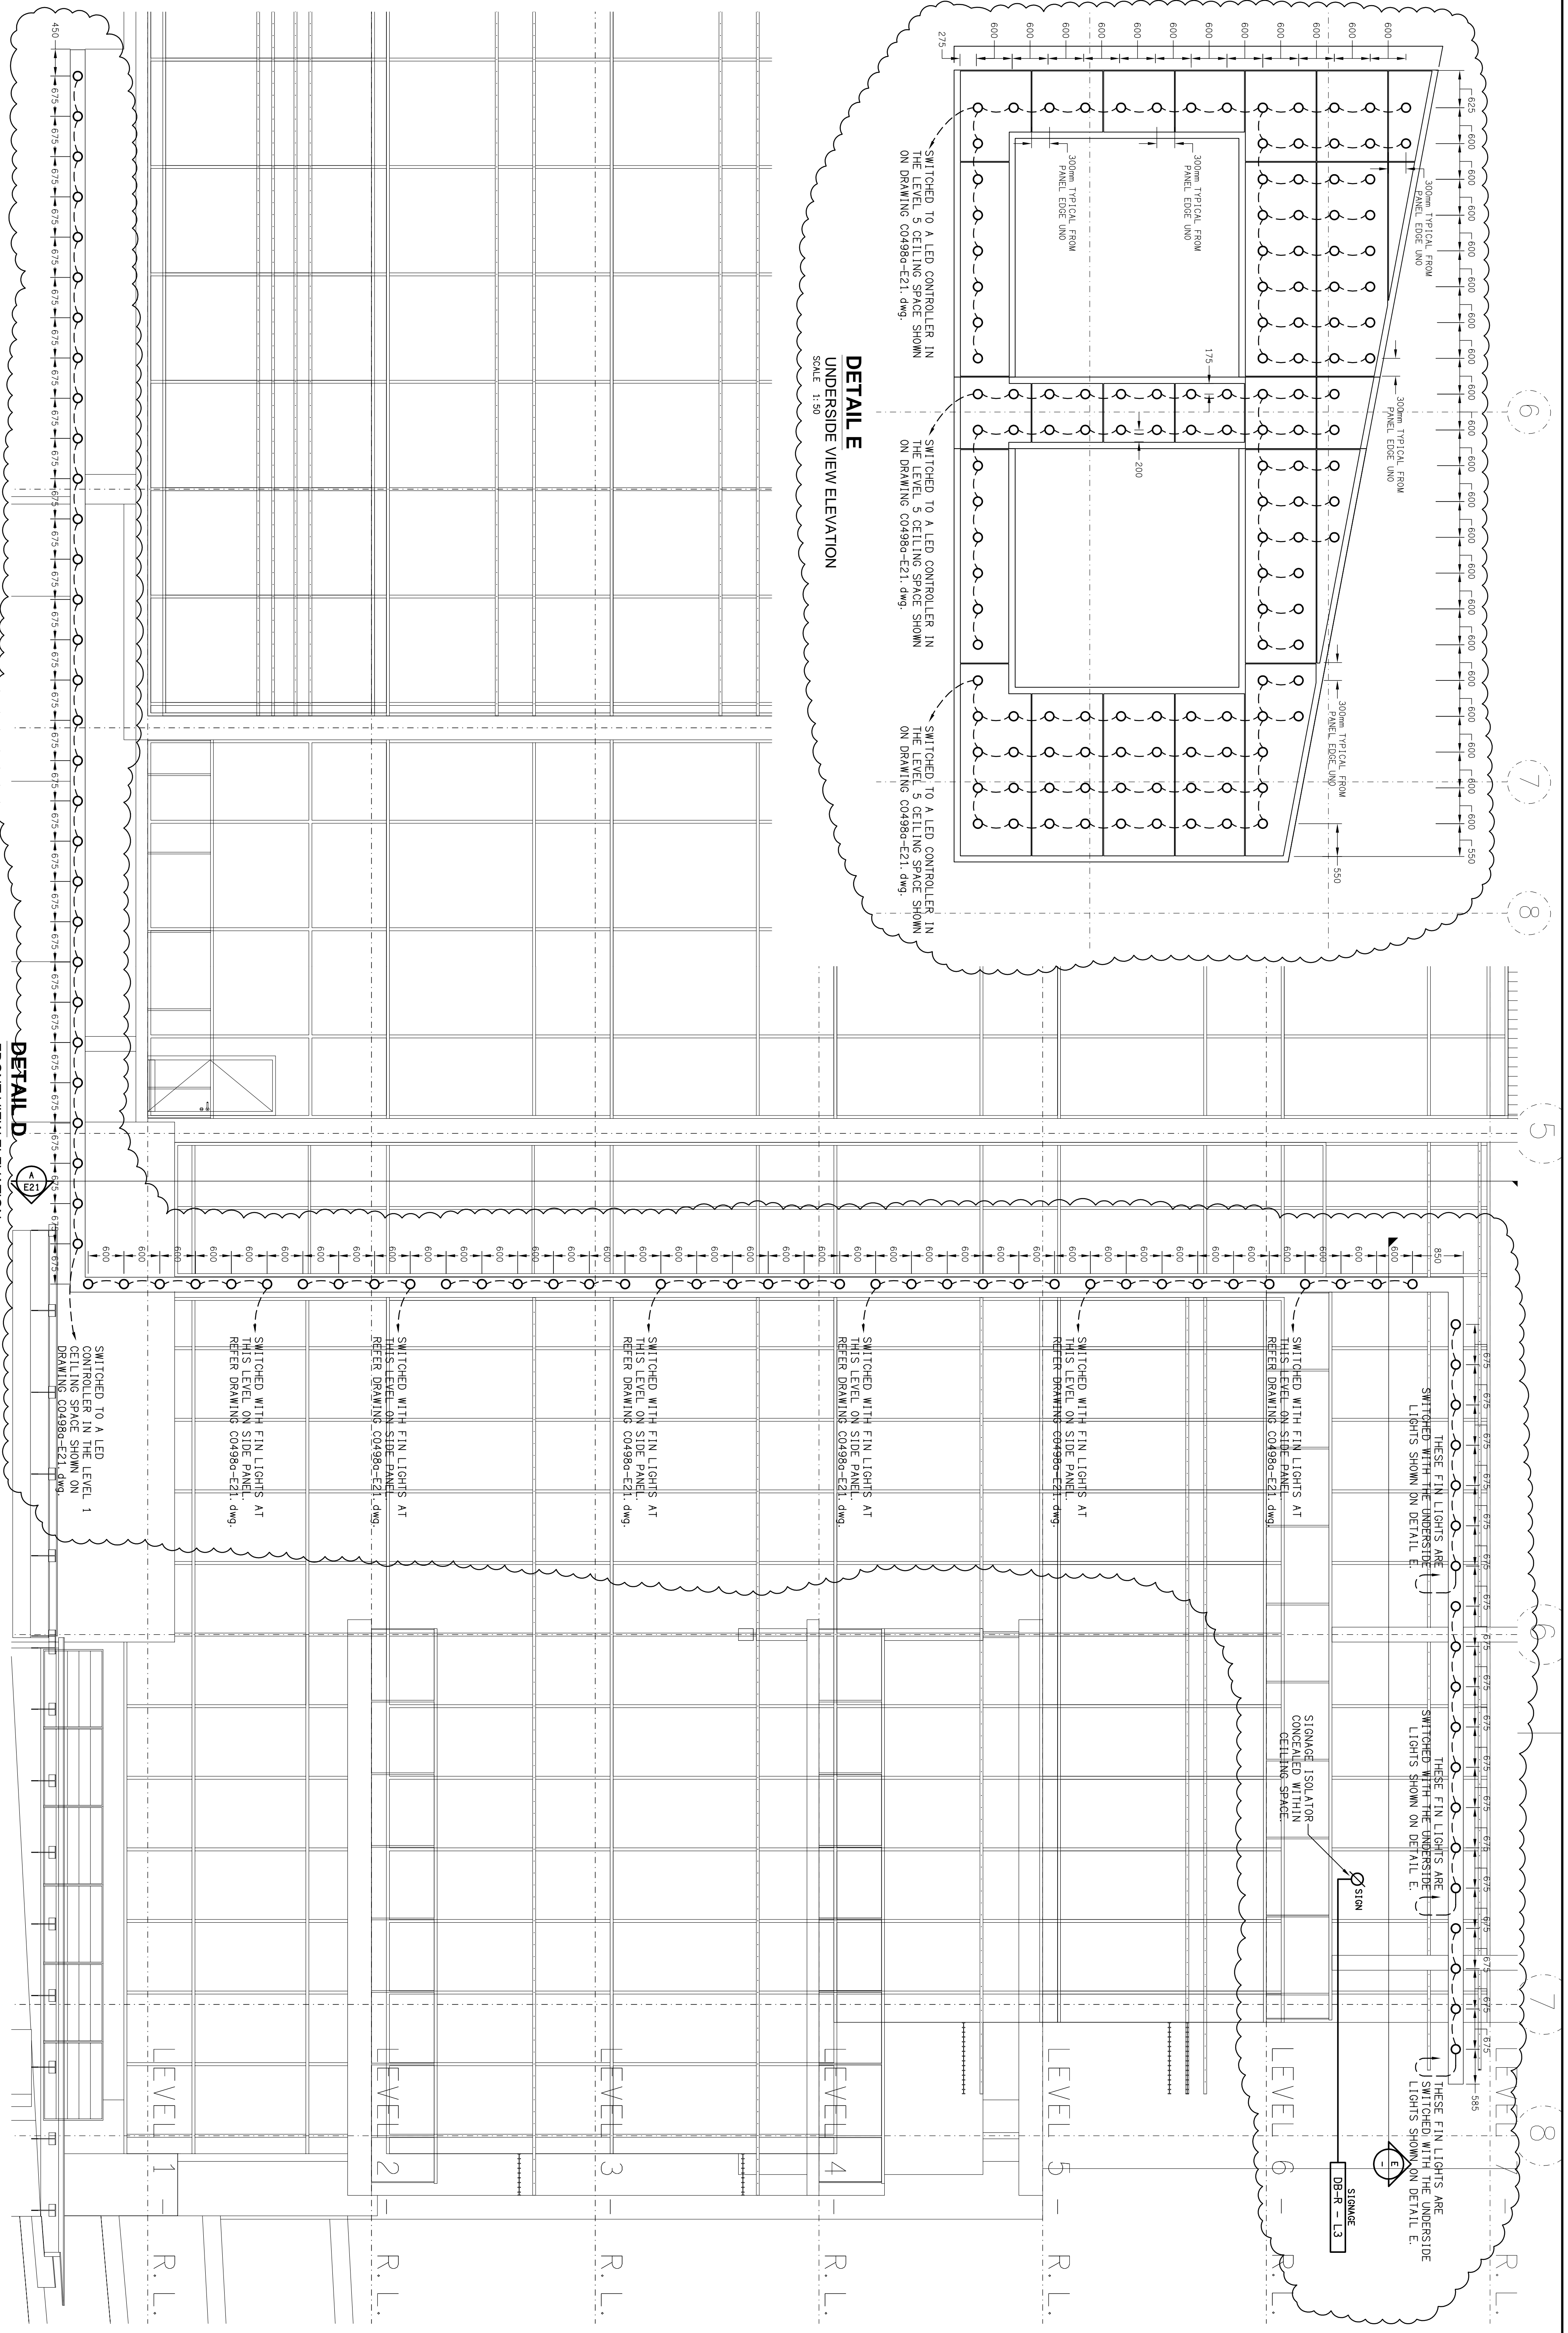

**DETAIL E**  
 UNDERSIDE VIEW ELEVATION  
 SCALE 1:50

**DETAIL D**  
 FRONT VIEW ELEVATION  
 SCALE 1:50

REV.	DESCRIPTION	DATE
E	CONSTRUCTION	23/04/2008