

OFFICE USE ONLY:
 MARKUP: _____ DRAFT: _____ CHECK: _____







ELECTRICAL DESIGN GROUP BRISBANE
 P.O. Box 15, Seawood Q.4075
 Phone: (07) 5597 7751
 Fax: (07) 5597 7752

THE COPYRIGHT OF THIS DRAWING
 REMAINS THE PROPERTY OF THE
 ELECTRICAL DESIGN GROUP.
 USE FIGURED DIMENSIONS
 IN PREFERENCE TO SCALE.
 ALL DIMENSIONS TO BE
 VERIFIED ONSITE.

ELECTRICAL DESIGN GROUP
 ELECTRICAL BUILDING SERVICES CONSULTANTS
 BRISBANE
 P.O. Box 15, Seawood Q.4075
 Phone: (07) 5597 7751
 Fax: (07) 5597 7752

PROJECT:
RSPCA - WACOL
 WACOL STATION ROAD, WACOL

SCALE: 1:100
 AT A1
C0677a E05
 PROJECT NO. DRAWING NO. REVISION:
J

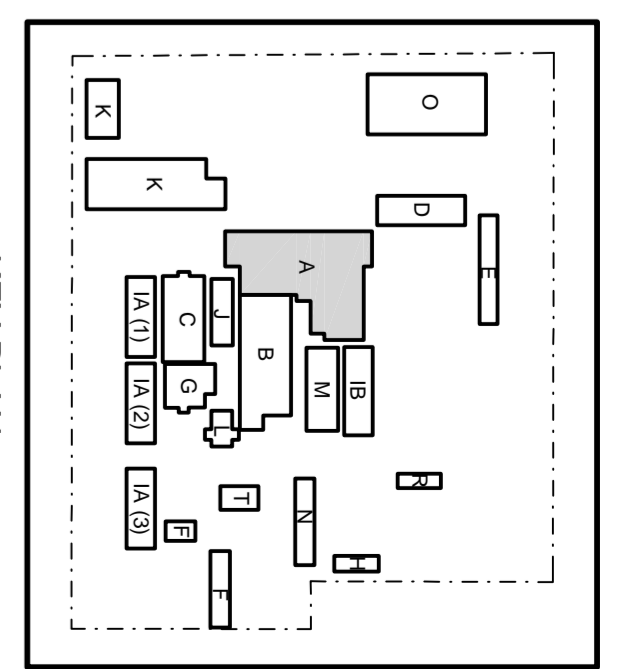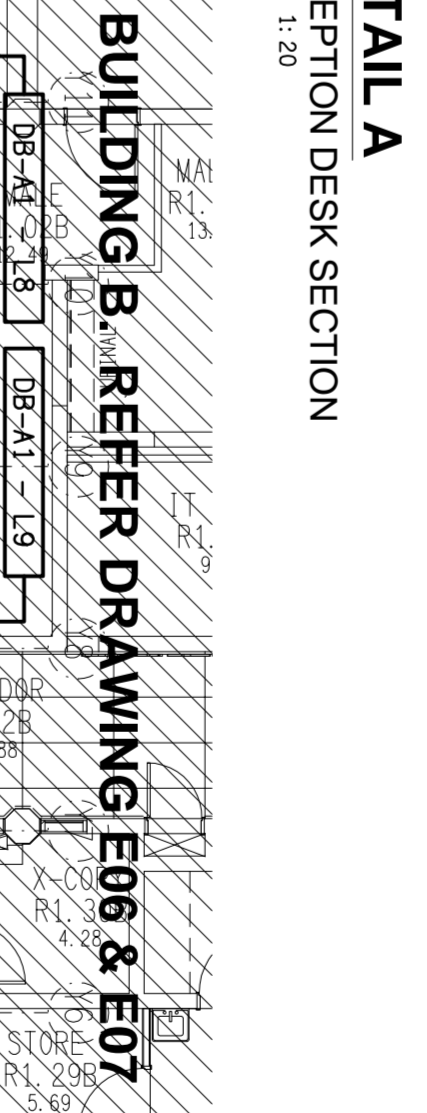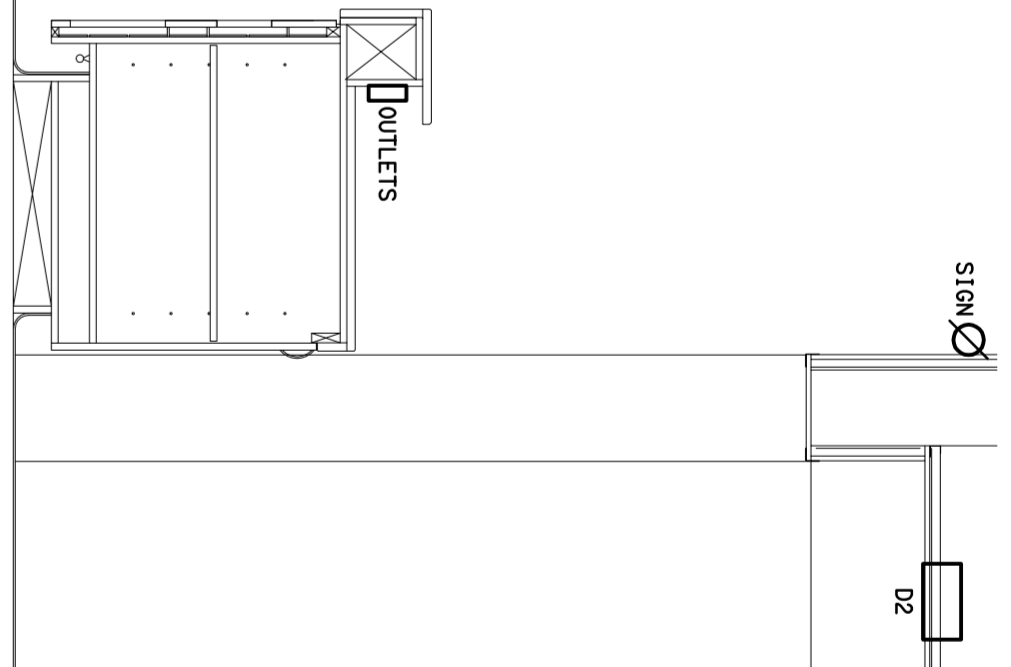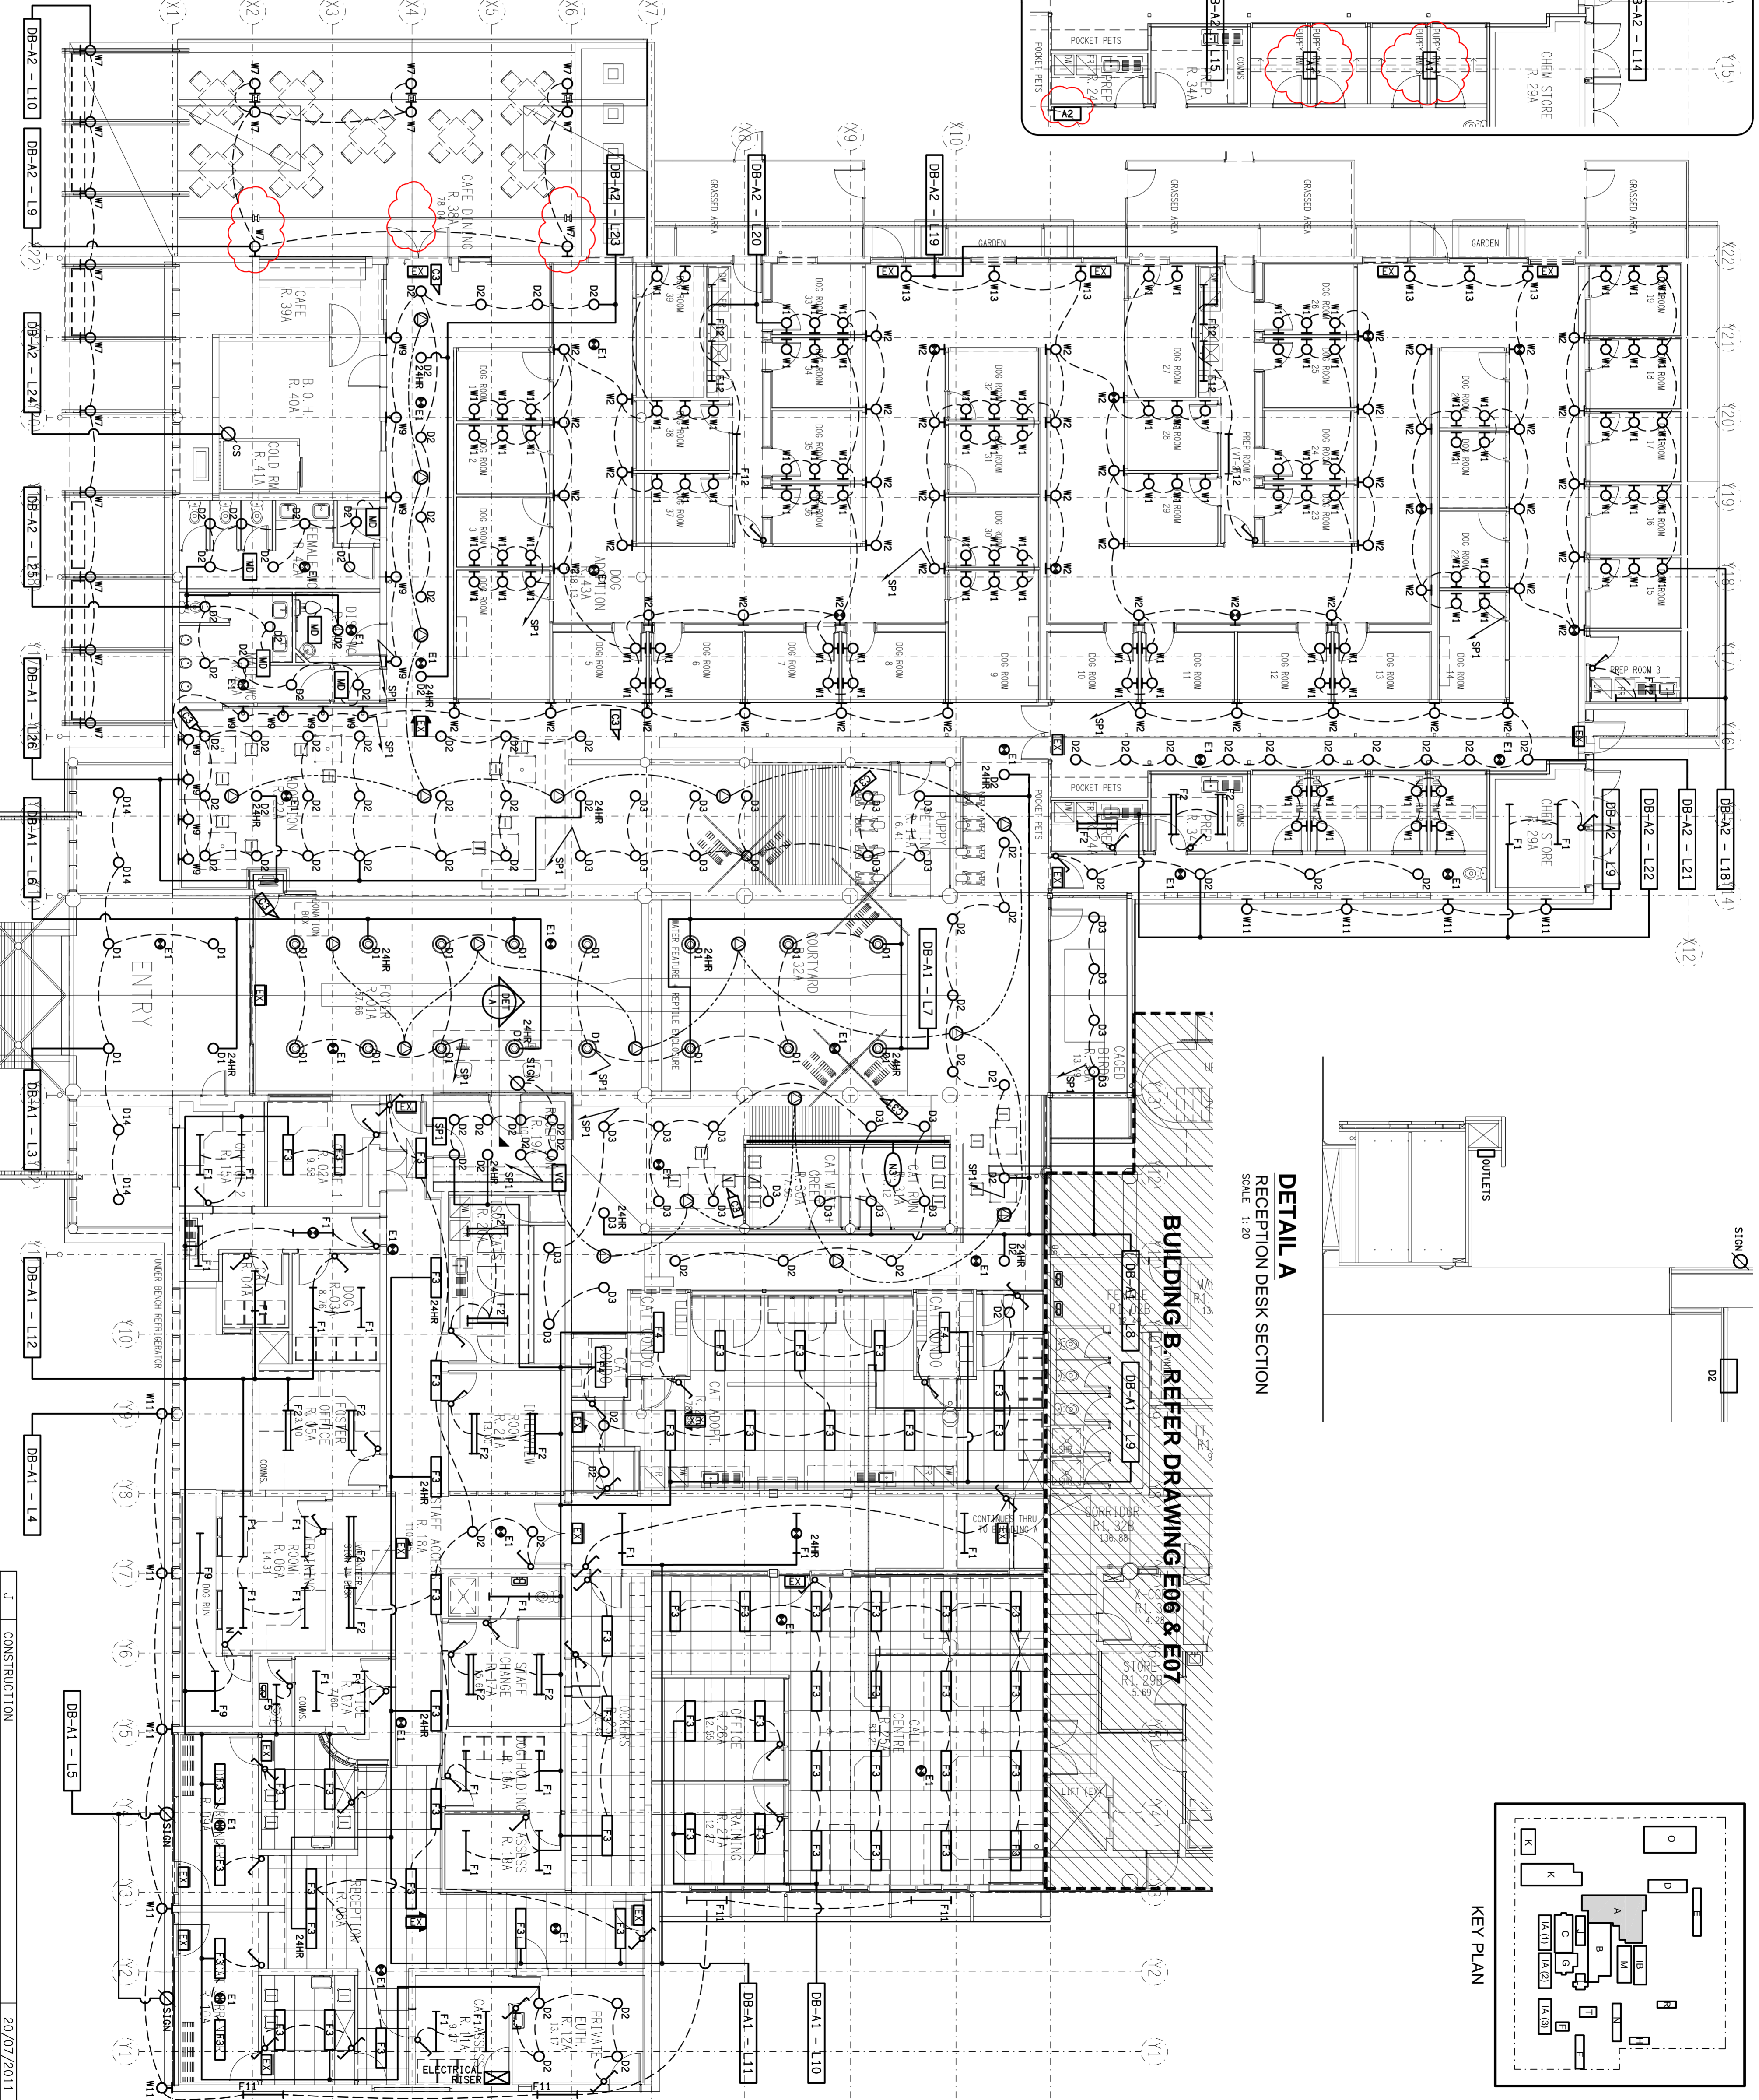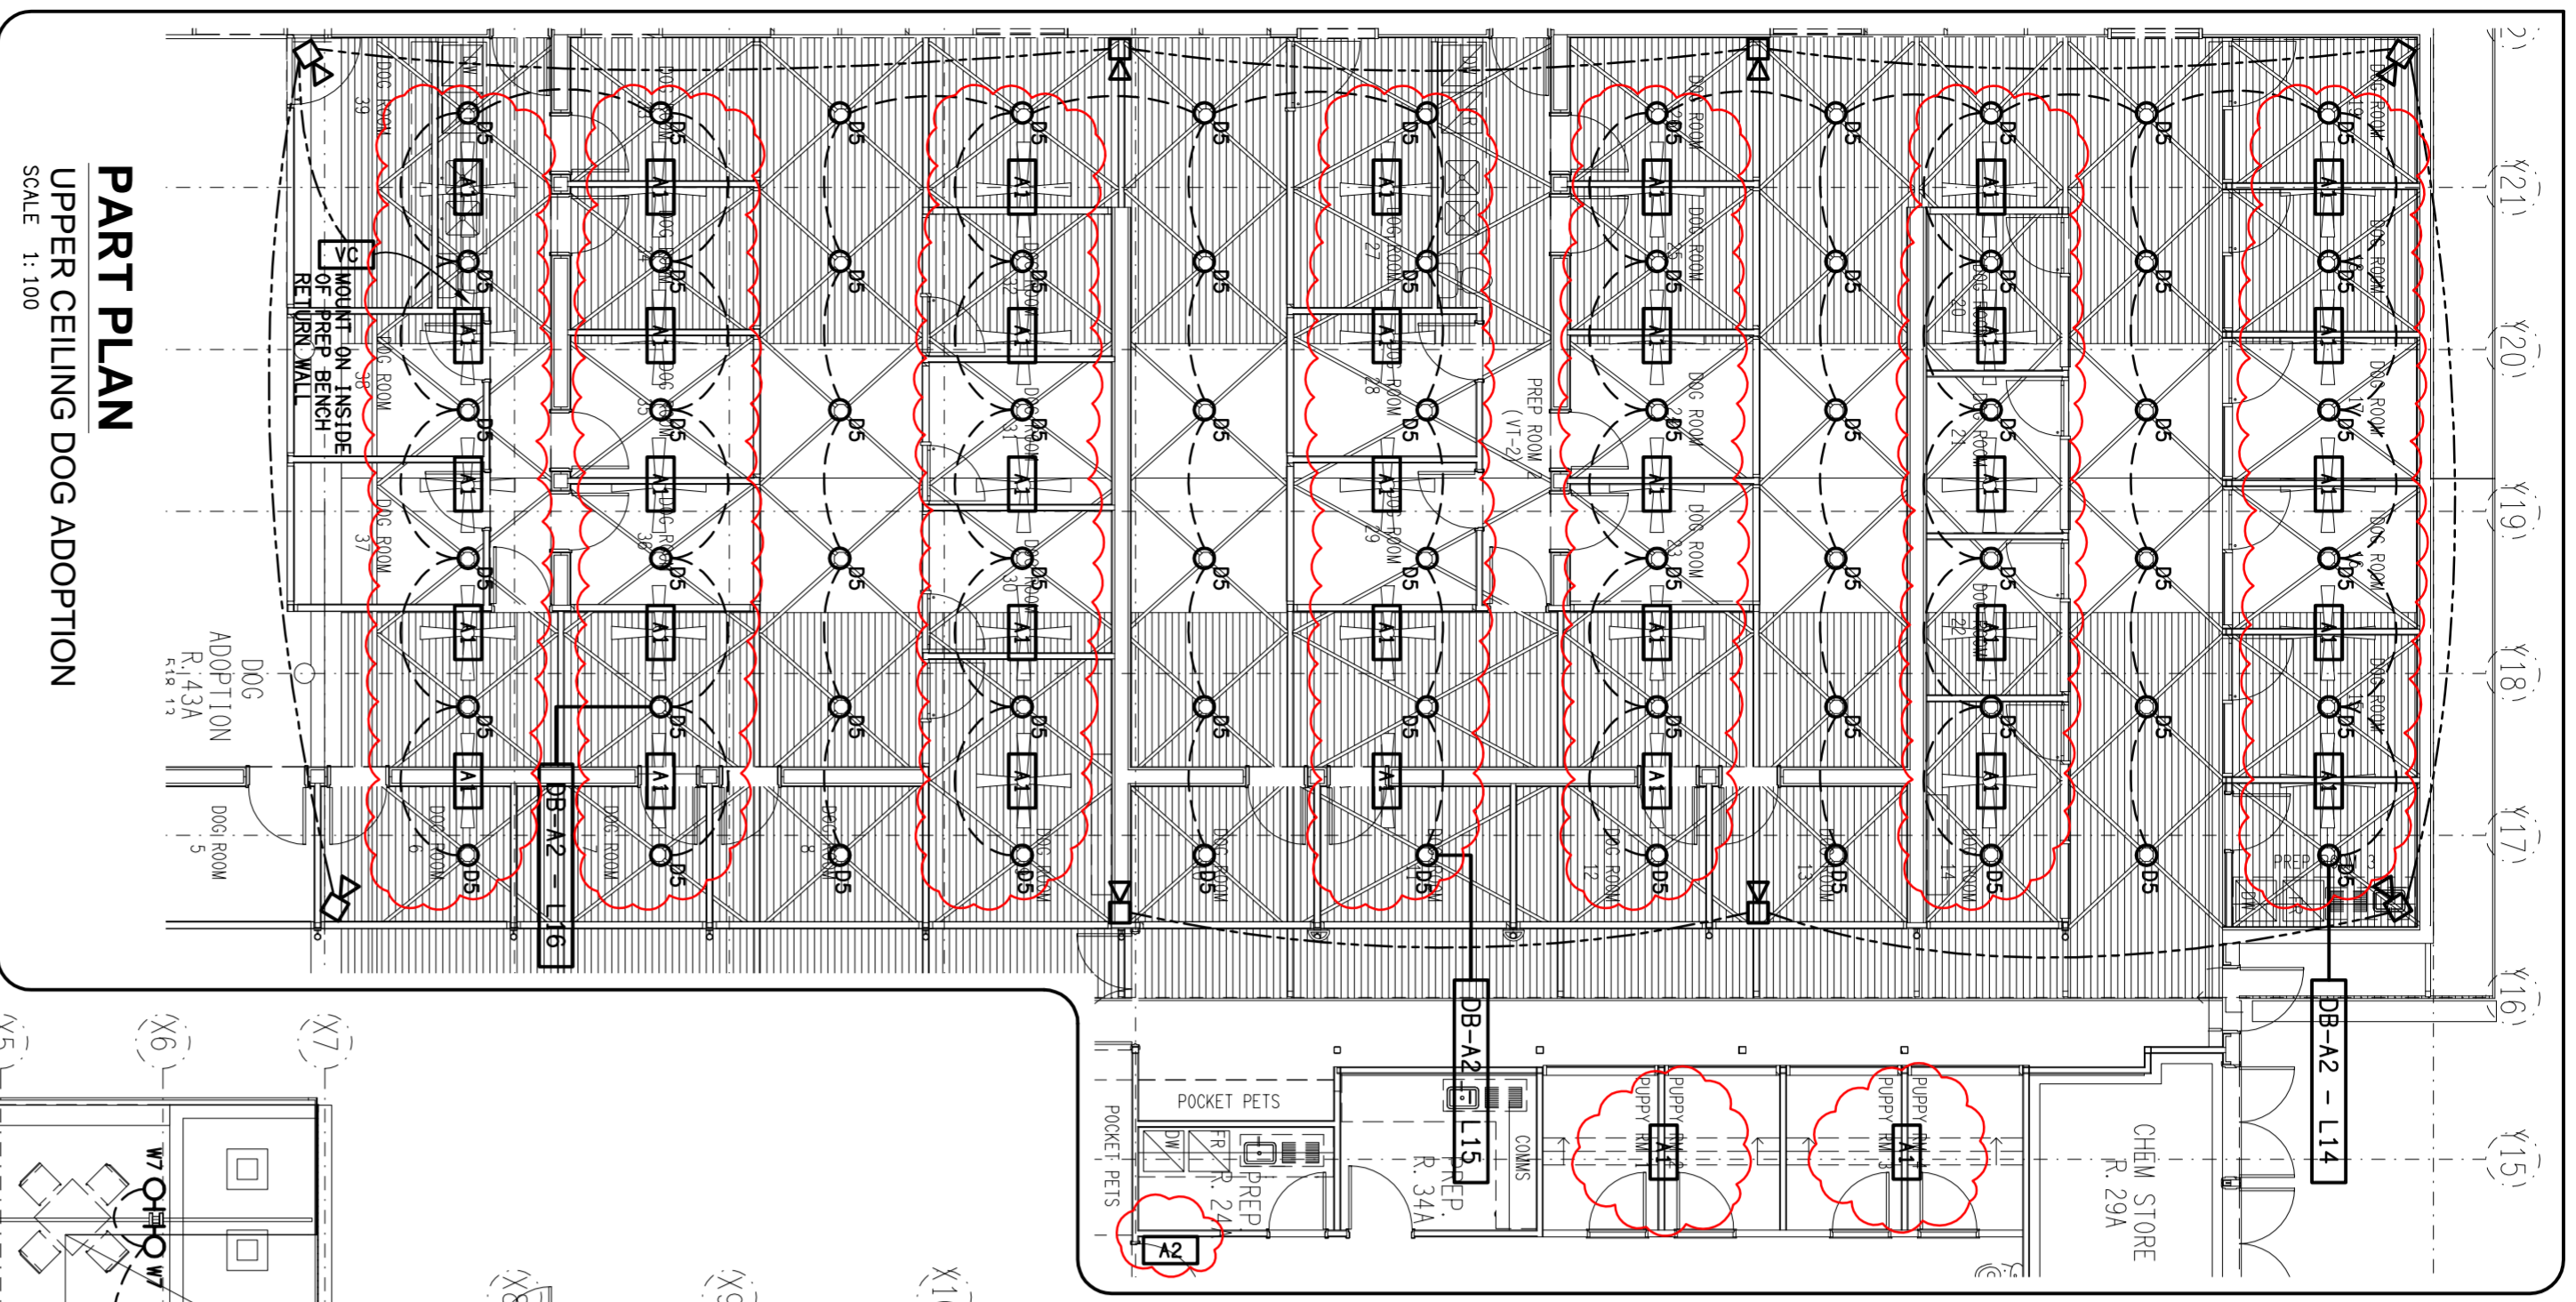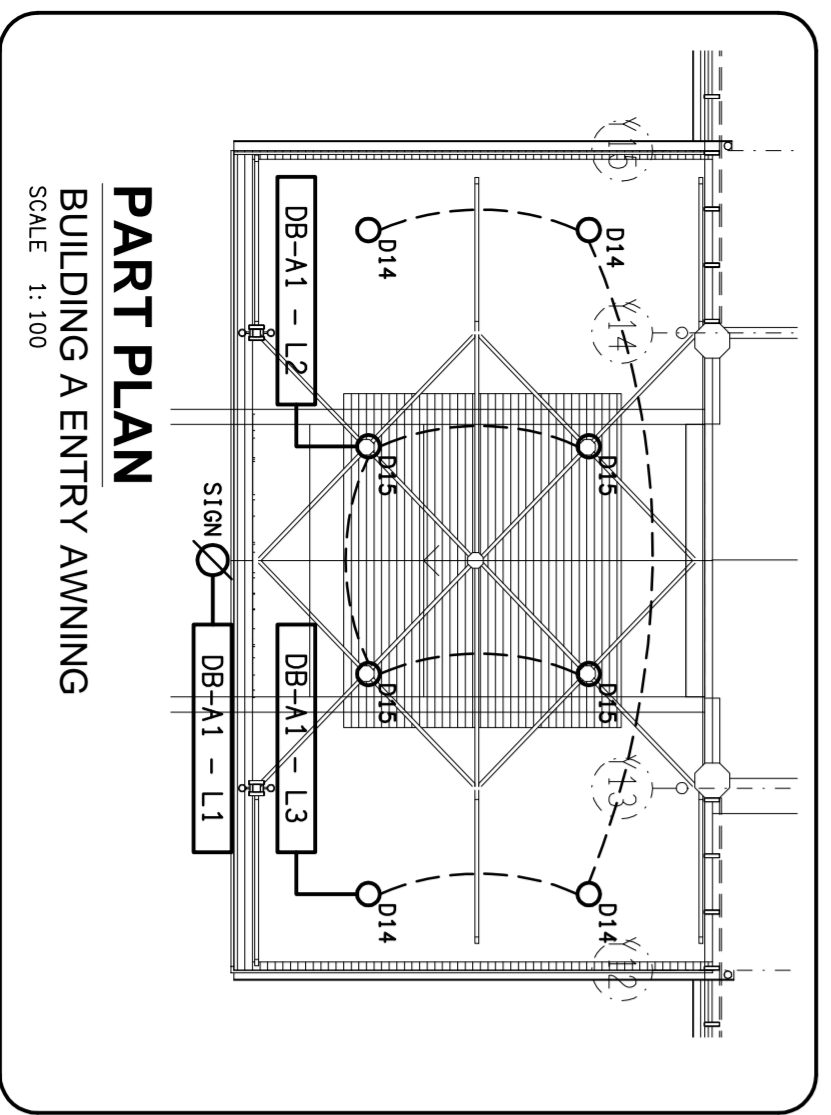

REV.	DESCRIPTION	DATE
J	CONSTRUCTION	20/07/2011