



ELECTRICAL DESIGN GROUP

ELECTRICAL BUILDING SERVICES CONSULTANTS

P.O. Box 15, SHERWOOD Q. 4075

Phone: (07) 3278 4375

Website: www.edg.net.au Email: brisbane@edg.net.au

C3144a - ST JOHNS ANGLICAN COLLEGE, FOREST LAKE - HEALTH & WELLBEING CENTRE

C3144a-0001(B).xls

ELECTRICAL SERVICES CONTRACT DOCUMENT SCHEDULE

REVISION B - 06 NOVEMBER 2023

ISSUING INFORMATION					DATE OF ISSUE									
					DAY	20	06							
					MONTH	10	11							
					YEAR	23	23							
					REASON FOR ISSUE	T	T							
A = APPROVAL					C = CONSTRUCTION					N = COORDINATION				
										P = PRELIMINARY				
										T = TENDER				

DISTRIBUTION					NUMBER OF COPIES									
WWW.EDG.NET.AU					1E	1E								
BSPN ARCHITECTURE					1E	1E								
ST JOHNS ANGLICAN COLLEGE					1E	1E								
P = PRINT					T = TRACING					D = DISC				
										E = EMAIL				
										F = FAX				

DOCUMENTS					REVISION									
C3144a-E01.dwg	LEGEND & SITE PLAN				A	B								
C3144a-E02.dwg	FLOOR PLAN				A	B								
C3144a-E03.dwg	REFLECTED CEILING PLAN				A									
C3144a-0001.xls	CONTRACT DOCUMENT SCHEDULE				A	B								
C3144a-0002.xls	EQUIPMENT SCHEDULE				A									
C3144a-0001.zip	FITTING & OUTLET DATASHEETS				A									



ELECTRICAL DESIGN GROUP

ELECTRICAL BUILDING SERVICES CONSULTANTS

P.O. Box 15, SHERWOOD Q. 4075

Phone: (07) 3278 4375 Fax: (07) 3716 0222

Web Site: www.edg.net.au Email: brisbane@edg.net.au


C3144a - ST JOHNS ANGLICAN COLLEGE, FOREST LAKE - HEALTH & WELLBEING CENTRE C3144a-0002(A).xls

ELECTRICAL EQUIPMENT SCHEDULE

REVISION A - 20 OCTOBER 2023

THE LIGHT FITTING SUPPLIER CONTACT DETAILS MAY BE AVAILABLE ON THE EDG WEBSITE VIA THE FOLLOWING LINK
www.edg.net.au/Links/Lighting.htm

TYPE	LAMPS	DESCRIPTION	COLOUR / ACCESSORY	CATALOGUE No	REV
L1	40W WHITE LED	600 X 600 LAY IN FLAT PLATE LED FITTING C/W REMOTE DRIVER MOUNTED IN THE CEILING T BAR	WHITE TRIM	GAMMA ILLUMINATION PHANTOM 884502-4K	A
L2	13W 3000K LED	RECESSED 52 DEG BEAM DOWNLIGHT C/W REMOTE DRIVER	WHITE TRIM	GAMMA ILLUMINATION COBALT 1402-4K-13W	A
L3	A SINGLE HORIZONTAL RUN OF LED STRIP LIGHT 4000K WHITE LEDS AT 12MM SPACING WITH REMOTE CONTROL GEAR. MOUNT THE FITTING HARD AGAINST THE SPLASHBACK UNDER THE OVERHEAD CUPBOARD THE SUPPLIER IS TO CUT / JOIN THE LED STRIPS TO SUIT THE SITE DIMENSIONS. DO NOT CUT THE LED STRIPS ON SITE SCREW FIX THE ALUMINIUM SUPPORT IN PLACE.			NEON PRODUCTS AUSTRALIA LF-DFB-NW-300-12 + PR-LINR-172153-F	A
L4	8W 4000K LED	RECESSED 47 DEG BEAM DOWNLIGHT C/W REMOTE DRIVER	WHITE TRIM	GAMMA ILLUMINATION MYLO 1004-WFL-4K-8W	A
E1	LED	EMERGENCY LIGHT: RECESSED NON-MAINTAINED EMERGENCY LIGHT. AS2293 CLASSIFICATION C0-D40 - C90-D40.	WHITE	CLEVERTRONICS CLIFE	A
EX	LED	EXIT LIGHT SURFACE MOUNTED MAINTAINED 24M VIEWING DISTANCE EXIT LIGHT C/W DIFFUSERS & DIRECTIONAL ARROWS AS SHOWN AS2293 CLASSIFICATION C0-D3.2 - C90-E2.	WHITE LOGO, GREEN BACKGROUND, WHITE BODY	CLEVERTRONICS LUB PRO SM	A
PRESENCE DETECTOR SWITCH (PD)		ADJUSTABLE FLUSH RECESSED 360 DEGREE TRIPLE PYRO PIR PRESENCE DETECTOR TO OPERATE THE ASSOCIATED LIGHTS FOR A PRE-SET AMOUNT OF TIME. ADJUST THE TIME AND SENSITIVITY ON SITE AS DIRECTED BY THE ENGINEER.	WHITE	CLIPSAL. SELECTION BY THE CONTRACTOR. SUBMIT DETAILS OF THE PROXIMITY DETECTOR SWITCH FOR APPROVAL PRIOR TO ORDERING	A
ONE-WAY SWITCH		ONE-WAY SWITCH MOUNTED AT 1000mm AFFL UNLESS NOTED OTHERWISE.	WHITE	CLIPSAL C2000 SERIES FACEPLATE	A
ONE-WAY ARCHITRAVE SWITCH		ONE-WAY ARCHITRAVE SWITCH MOUNTED AT 1000mm AFFL UNLESS NOTED OTHERWISE.	WHITE	CLIPSAL C2000 SERIES ARCHITRAVE FACEPLATE	A
SMOKE DETECTOR		AS1670 SMOKE DETECTOR TO BE CONNECTED TO THE FIRE INDICATING PANEL			A
FIRE EVACUATION SPEAKER		FIRE EVACUATION SPEAKER TO BE CONNECTED TO THE FIRE INDICATING PANEL			A

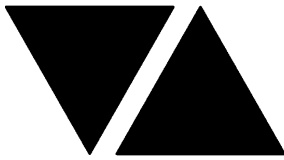

ELECTRICAL DESIGN GROUP

ELECTRICAL BUILDING SERVICES CONSULTANTS

P.O. Box 15, SHERWOOD Q. 4075

Phone: (07) 3278 4375 Fax: (07) 3716 0222

Web Site: www.edg.net.au Email: brisbane@edg.net.au

C3144a - ST JOHNS ANGLICAN COLLEGE, FOREST LAKE - HEALTH & WELLBEING CENTRE C3144a-0002(A).xls

ELECTRICAL EQUIPMENT SCHEDULE

REVISION A - 20 OCTOBER 2023

THE LIGHT FITTING SUPPLIER CONTACT DETAILS MAY BE AVAILABLE ON THE EDG WEBSITE VIA THE FOLLOWING LINK
www.edg.net.au/Links/Lighting.htm

TYPE	LAMPS	DESCRIPTION	COLOUR / ACCESSORY	CATALOGUE No	REV
SCHOOL BELL SPEAKER		NEW 15W MULTI TAP RECESSED COAXIAL CONE SPEAKER C/E WHITE GRILL CONNECTED TO THE NEW SCHOOL BELL AMPLIFIER			A
SINGLE POWER OUTLET		SINGLE POWER OUTLET C/W CIRCUIT IDENTIFICATION ON THE FACEPLATE BEHIND THE SURROUND MOUNT AT 300mm AFFL U.N.O. RATING 10A U.N.O.	WHITE	CLIPSAL C2000 SERIES	A
DOUBLE POWER OUTLET		DOUBLE POWER OUTLET C/W CIRCUIT IDENTIFICATION ON THE FACEPLATE BEHIND THE SURROUND MOUNT AT 300mm AFFL U.N.O. RATING 10A U.N.O.	WHITE	CLIPSAL C2000 SERIES	A
DOUBLE POWER OUTLET C/W USB CHARGERS		DOUBLE POWER OUTLET C/W DUAL USB A AND USB C CHARGING PORTS CIRCUIT IDENTIFICATION ON THE FACEPLATE BEHIND THE SURROUND MOUNT ABOVE BENCH U.N.O. RATING 10A U.N.O.	WHITE	CLIPSAL C2000 SERIES	A
HAND DRYER CONNECTION (HD)		20A ISOLATING SWITCH WALL MOUNTED AT 2400mm AFFL AND CONNECTED TO THE HAND DRYER UNIT AS PER DETAIL.	WHITE	CLIPSAL C2000 SERIES	A
SINGLE-PHASE ISOLATOR		SINGLE-PHASE WEATHERPROOF ISOLATOR. MOUNT AT 1350mm AFFL U.N.O. RATING 20A U.N.O. CONNECT TO EQUIPMENT VIA FLEXIBLE CONDUIT.	-	CLIPSAL WHT20	A
THREE-PHASE ISOLATOR		THREE-PHASE WEATHERPROOF ISOLATOR. MOUNT AT 1350mm AFFL U.N.O. RATING 40A U.N.O. CONNECT TO EQUIPMENT VIA FLEXIBLE CONDUIT.	-	CLIPSAL WHT35	A
RECESS KIT (RK)		VERTICALLY ORIENTATED WALL BOX TO ALLOW THE OUTLET TO BE RECESSED WITHIN THE WALL CAVITY	WHITE	REPELEC RECWP1WH	A
COMMUNICATIONS RACK CR-CG		UPDATE THE RACK AS NECESSARY TO ACCOMMODATE THE COMMUNICATIONS OUTLETS MADE REDUNDANT BY AND THOSE PROVIDED AS PART OF THE NEW WORKS.			A
CAT 6 COMMUNICATIONS OUTLET		RJ45 CAT-6 COMMUNICATIONS OUTLET, CABLED BACK TO COMMUNICATIONS RACK CR-CG TERMINATED ONTO FACILITY PATCH PANELS VIA 4-PAIR CAT-6 UTP CABLE. MOUNT UP TO 3 RJ45 OUTLETS PER MULTI-GANG FACEPLATE WITH SEPARATE PERMANENT LABELLING FOR EACH OUTLET.	WHITE UNLESS NOTED AS BLACK (BK)	CLIPSAL C2000 SERIES	A
DB-CG		EXISTING DISTRIBUTION BOARD DB-CG TO BE PROVIDED WITH ADDITIONAL SWITCHGEAR AS NECESSARY TO ACCOMMODATE THE NEW CIRCUITS. REFER TO THE DISTRIBUTION BOARD SCHEDULE FOR THE DETAILS OF THE NEW CIRCUITS. UPDATE THE SWITCHBOARDS SCHEDULE CARD TO REFLECT THE AS BUILT INSTALLATION.			A
SECURITY EQUIPMENT		EXISTING SECURITY EXPANDER PANEL TO BE UPGRADED AS NECESSARY TO ACCOMMODATE THE REVISED / ADDITIONAL DETECTORTS.			A
KEY PAD		RELOCATE THE EXISTING SECURITY KEY PADE			A



ELECTRICAL DESIGN GROUP

ELECTRICAL BUILDING SERVICES CONSULTANTS

P.O. Box 15, SHERWOOD Q. 4075

Phone: (07) 3278 4375 Fax: (07) 3716 0222

Web Site: www.edg.net.au Email: brisbane@edg.net.au

C3144a - ST JOHNS ANGLICAN COLLEGE, FOREST LAKE - HEALTH & WELLBEING CENTRE C3144a-0002(A).xls

ELECTRICAL EQUIPMENT SCHEDULE

REVISION A - 20 OCTOBER 2023

THE LIGHT FITTING SUPPLIER CONTACT DETAILS MAY BE AVAILABLE ON THE EDG WEBSITE VIA THE FOLLOWING LINK
www.edg.net.au/Links/Lighting.htm

TYPE	LAMPS	DESCRIPTION	COLOUR / ACCESSORY	CATALOGUE No	REV
SECURITY INTRUDER DETECTOR		SECURITY INTRUDER DETECTOR TO BE MATCH THE EXISTING			A

NOTES

1. EXTENT OF WORKS

THE ELECTRICAL SERVICES SUB-CONTRACT INCLUDES BUT IS NOT LIMITED TO THE FOLLOWING:

- SUPPLY AND INSTALLATION OF ALL COMPONENTS FORMING PART OF THE ELECTRICAL SERVICES.
- CO-ORDINATION.
- INSPECTIONS.
- TESTING AND COMMISSIONING.
- MAINTENANCE.
- CABLING, CABLE SUPPORT SYSTEMS AND ACCESS.
- POWER DISTRIBUTION.
- LIGHTING.
- COMMUNICATIONS CABLING.
- SCHOOL BELL.
- FIRE DETECTION AND ALARM SYSTEM.
- SECURITY.
- ALL MINOR COMPONENTS AND INCIDENTAL WORKS NOT SPECIFICALLY REFERRED TO, HOWEVER NECESSARY TO COMPLETE THE ELECTRICAL SERVICES INSTALLATION SUCH THAT IT IS HANDED OVER COMPLETE, OPERATIONAL AND FIT FOR THE INTENDED USE.

SUPPLY ALL LABOUR, MATERIALS, EQUIPMENT, AND ALL OTHER ITEMS, WHETHER MENTIONED IN DETAIL OR NOT, REQUIRED FOR THE SATISFACTORY COMPLETION OF THE ELECTRICAL SERVICES INSTALLATION, LEAVING IN FULL WORKING ORDER TO THE SATISFACTION OF THE PROJECT MANAGER.

ACCEPT FULL RESPONSIBILITY FOR LIASING, ARRANGING AND CO-ORDINATION ALL WORKS THAT HAVE AN EFFECT ON OR WILL BE AFFECTED BY THE ELECTRICAL SERVICES.

REMOVE ALL OF THE EXISTING ELECTRICAL SERVICES THAT BECOME REDUNDANT DUE TO THE WORKS.

MODIFY THE EXISTING PITS LOCATED WITHIN THE WORKS AREA TO MATCH THE NEW LEVELS AND FINISHES. THE MODIFICATIONS ARE TO INCLUDE THOUGH NOT BE LIMITED TO THE FOLLOWING AS REQUIRED:

- NEW RISERS.
- NEW SURROUNDS.
- NEW IN FILL LIDS.

2. WORKMANSHIP

ENSURE THAT THE WORK IS PERFORMED BY THE HOLDER OF A CURRENT ELECTRICAL SUB CONTRACTOR LICENSE. ENSURE THE INSTALLATION AND ALL COMPONENTS, FIXTURES, FITTINGS, OUTLETS AND CABLES ARE SUPPLIED AND INSTALLED TO A HIGH STANDARD THROUGHOUT, AND INSTALLED IN A NEAT AND TRADESMAN LIKE MANNER, TO THE CURRENT INDUSTRY STANDARDS. ENSURE ALL MATERIALS AND COMPONENTS OF A SIMILAR TYPE ARE OF THE SAME MANUFACTURER AND INSTALLED IN A UNIFORM MANNER.

IT IS THE ELECTRICAL SUB CONTRACTOR’S RESPONSIBILITY TO ENSURE THAT THE INSTALLATION IS FIT FOR PURPOSE AND IS PROVIDED AS A COMPLETE WORKING INSTALLATION. IT IS THE ELECTRICAL SUB CONTRACTOR’S RESPONSIBILITY TO PROVIDE ALL COMPONENTS, FITTINGS, FIXTURES, SYSTEMS, PROGRAMMING ETC IRRESPECTIVE OF THE LEVEL DETAILED IN THE DOCUMENTS SUCH THAT THE INSTALLATION IS PROVIDED AS A COMPLETE WORKING INSTALLATION.

CONCEAL ALL WIRING AND CONDUITS. EXPOSED CABLING OR CONDUITS ARE GENERALLY NOT ACCEPTABLE. IT IS NOTED THAT CHASING AND REINSTATEMENT WILL BE REQUIRED. ENSURE ALL COMPONENTS, EQUIPMENT AND MATERIALS SUPPLIED ARE NEW, UNUSED, DESIGNED AND SELECTED TO ENSURE SATISFACTORY OPERATION UNDER VARYING ATMOSPHERIC, CLIMATIC, HUMID TROPICAL CONDITIONS WITHOUT DISTORTION AND DETERIORATION IN ANY PART AFFECTING EFFICIENCY AND RELIABILITY OF THE SYSTEMS. DESIGN AND SELECT ALL EQUIPMENT TO PROVIDE THE NECESSARY SAFETY TO HUMAN LIFE AND PROPERTY DURING OPERATION AND MAINTENANCE WITH PARTICULAR ATTENTION GIVEN TO ELECTRICAL SAFETY AND SEGREGATION PRECAUTIONS.

CHECK THE FINISHED PAINTWORK AROUND THE AREA OF EACH INSTALLATION AND TOUCH UP ALL DAMAGED PARTS AND FINISHES AFTER THE INSTALLATION OF THE ELECTRICAL SERVICES.

ALL WORKS ARE TO BE CARRIED OUT IN ACCORDANCE WITH THE BUILDER’S PROGRAM. ENSURE ALL FINAL LOCATIONS OF OUTLETS AND FITTINGS ARE CO-ORDINATED ONSITE WITH THE ARCHITECT AND ALL OTHER SERVICES, TO THE APPROVAL OF THE PROJECT MANAGER. ALLOW TO CO-ORDINATE THE FINAL LOCATION OF ALL EQUIPMENT, FITTINGS, & OUTLETS, SUCH THAT THEY ARE INSTALLED IN ACCORDANCE WITH THE AS3000 RESTRICTED ZONES, AND ARE NOT COVERED INAPPROPRIATELY.

ENSURE THAT ALL METAL SURFACES ARE SUITABLY PROTECTED AGAINST CORROSION, AND THAT ALL PLASTIC MATERIALS ARE UV STABILISED.

PROVIDE ALL MATERIALS AS NEW, AND OF THE HIGHEST CLASS AVAILABLE FOR THEIR RESPECTIVE TYPES. ENSURE ALL ASPECTS OF THE WORK ARE OF A HIGH STANDARD THROUGHOUT, AND INSTALLED IN A NEAT AND TRADESMAN LIKE MANNER, TO THE CURRENT INDUSTRY STANDARDS.

3. STANDARDS

IRRESPECTIVE OF INFORMATION CONTAINED IN THE ELECTRICAL SERVICES DOCUMENTS OR IN INSTRUCTIONS, IT IS THE ELECTRICAL SUB CONTRACTOR’S RESPONSIBILITY TO ENSURE ALL ELECTRICAL SERVICES WORKS ARE INSTALLED IN ACCORDANCE WITH THE REQUIREMENTS OF THE FOLLOWING. REFER ANY DISCREPANCIES BETWEEN THE REQUIREMENTS OF THE FOLLOWING AND/OR THE ELECTRICAL SERVICES DOCUMENTS AND INSTRUCTIONS TO THE ARCHITECT FOR CLARIFICATION PRIOR TO THE PLACING OF ORDERS, FABRICATION OR INSTALLATION OF THE ITEMS/METHODS IN DISCREPANCY.

- NCC BUILDING CODE OF AUSTRALIA.
- ELECTRICITY ACT.
- ELECTRICAL SAFETY ACT.
- AS/NZS3000.
- AS3008.
- WORKPLACE HEALTH AND SAFETY ACT.
- TELECOMMUNICATIONS ACT.
- ACMA REQUIREMENTS.

4. AUTHORITIES

ENSURE ALL OF THE ELECTRICAL SERVICES COMPLY WITH THE REQUIREMENTS OF ALL REGULATORY AUTHORITIES HAVING JURISDICTION OVER THE SITE INCLUDING BUT NOT LIMITED TO THE FOLLOWING:

- ACMA.
- LOCAL COUNCIL.
- LOCAL SUPPLY AUTHORITY.
- STATE GOVERNMENT DEPARTMENT OF ENVIRONMENT AND HERITAGE.
- QLD GOVERNMENT, DIVISION OF WORKPLACE, HEALTH AND SAFETY.
- QLD FIRE AND RESCUE AUTHORITY.

5. CABLES

UNLESS OTHERWISE SPECIFIED, INSTALL AND TERMINATE CABLES IN ACCORDANCE WITH THE MANUFACTURERS’ RECOMMENDATIONS. DETERMINE THE FINAL ROUTES TO SUIT THE BUILDING STRUCTURE AND SITE CONDITIONS. UNLESS NOTED OTHERWISE, PROVIDE ALL 240 VOLT POWER AND LIGHTING WIRING AS 2.5mm² TWIN & EARTH STRANDED COPPER CONDUCTORS, PVC INSULATED 0.6/1kV V75 GRADE TO AS3174, PROTECTED BY A 20 AMP CIRCUIT BREAKER. ALL CONDUIT AND FITTINGS TO BE RIGID UPVC TO AS2053, UNLESS NOTED OTHERWISE.

NOTES

6. POWER DISTRIBUTION

THE POWER DISTRIBUTION COMPONENT OF THIS CONTRACT INCLUDES THE PROVISION OF NEW SWITCHGEAR AS REQUIRED IN DB-CG TO ACCOMMODATE THE PROPOSED WORKS. ALL OF THE EXISTING CIRCUITS THAT BECOME REDUNDANT ARE TO BE REMOVED AND THE LABELLING UPDATED. REDUNDANT SERVICES WITHIN THE EXISTING DISTRIBUTION BOARDS IS TO BE REMOVED. AT PRACTICAL COMPLETION UPDATE THE DISTRIBUTION BOARD SCHEDULES.

THE POWER DISTRIBUTION COMPONENT OF THIS CONTRACT INCLUDES, BUT IS NOT LIMITED TO THE FOLLOWING EXTENT OF WORK:

- POWER DISTRIBUTION.
- EARTHING.
- REMOVAL OF EXISTING REDUNDANT CIRCUITS.
- CIRCUITS.
- ISOLATORS AND OUTLETS.
- TESTING AND COMMISSIONING.

7. LIGHTING

ALL OF THE LIGHT FITTINGS, LAMPS AND ACCESSORIES ARE TO BE PROVIDED AS PART OF THIS CONTRACT. THE LIGHTING COMPONENT OF THIS CONTRACT INCLUDES, BUT IS NOT LIMITED TO THE FOLLOWING EXTENT OF WORK:

- LIGHTING.
- LIGHT FITTINGS AND ACCESSORIES.
- LAMPS.
- EARTHING OF THE LIGHTING INSTALLATION.
- LIGHTING CONTROL.
- LIGHTING SUBCIRCUITS.
- TESTING AND COMMISSIONING.

RECOVER ALL OF THE EXISTING LIGHT FITTINGS FROM THE SPACES TO BE RENOVATED AND RETURN THEM TO THE SCHOOL.

8. COMMUNICATIONS

THE COMMUNICATIONS CABLING COMPONENT OF THIS CONTRACT INCLUDES NEW CAT 6 OUTLETS CABLED VIA CAT 6 CABLE TO THE LOCAL EXISTING COMMUNICATIONS RACK CR-CG.

ALL OF THE EXISTING COMMUNICATION CABLES THAT BECOME REDUNDANT ARE TO BE REMOVED. THE COMMUNICATIONS CABLING COMPONENT OF THIS CONTRACT INCLUDES, BUT IS NOT LIMITED TO THE FOLLOWING EXTENT OF WORK:

- REMOVAL OF EXISTING REDUNDANT CABLING.
- COMMUNICATIONS OUTLETS AND CABLING.
- PATCH PANELS WITHIN CR-CG AS REQUIRED.
- TESTING AND COMMISSIONING.

9. FIRE ALARM AND DETECTION.

EVERSAFE FIRE (07) 3399 8988 IS TO BE ENGAGED AS NOMINATED SUB CONTRACTOR TO UNDERTAKE ALL FIRE ALARM AND DETECTION WORKS. THE FIRE ALARM AND DETECTION COMPONENT OF THIS CONTRACT INCLUDES THE MODIFICATION OF THE EXISTING FIRE ALARM AND DETECTION SERVICES.

UPDATE THE FIP ZONE DIAGRAM TO REFLECT THE CURRENT ZONES ACROSS THE ENTIRE SITE.

ALL OF THE EXISTING FIRE ALARM AND DETECTION THAT BECOME REDUNDANT ARE TO BE REMOVED. THE FIRE ALARM AND DETECTION COMPONENT OF THIS CONTRACT INCLUDES, BUT IS NOT LIMITED TO THE FOLLOWING EXTENT OF WORK:

- REMOVAL OF EXISTING REDUNDANT CABLING AND SERVICES.
- DETECTORS.
- SPEAKERS.
- TESTING AND COMMISSIONING.
- UPDATE THE FIP ZONE DIAGRAM.

10. SCHOOL BELL

SEQFS THOMAS BUXTON 0422 488 621 tom@seqfs.com.au IS TO BE ENGAGED AS NOMINATED SUB CONTRACTOR TO UNDERTAKE ALL SCHOOL BELL WORKS.

THE SCHOOL BELL COMPONENT OF THIS CONTRACT INCLUDES NEW SPEAKERS THROUGHOUT THE AREA OF THE WORKS CONNECTED TO THE EXISTING SCHOOL BELL AMPLIFIER.

THE SCHOOL BELL COMPONENT OF THIS CONTRACT INCLUDES, BUT IS NOT LIMITED TO THE FOLLOWING EXTENT OF WORK:

- SPEAKERS AND CABLING.
- TESTING AND COMMISSIONING.

11. SECURITY

PACIFIC SECURITY 1300 859 141 IS TO BE ENGAGED AS NOMINATED SUB CONTRACTOR TO UNDERTAKE ALL SECURITY WORKS. THE SECURITY COMPONENT OF THIS CONTRACT INCLUDES MODIFICATIONS TO THE EXISTING INTRUDER DETECTION SYSTEM.












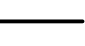

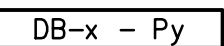



ALL OF THE EXISTING DETECTORS AND CABLES THAT BECOME REDUNDANT ARE TO BE REMOVED. THE INTRUDER DETECTION COMPONENT OF THIS CONTRACT INCLUDES, BUT IS NOT LIMITED TO THE FOLLOWING EXTENT OF WORK:

- RELOCATION OF THE EXISTING SECURITY KEY PANEL.
- REMOVAL OF EXISTING REDUNDANT DETECTORS AND CABLING.
- DETECTORS AND CABLING.
- TESTING AND COMMISSIONING.




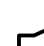







 
12. ABBREVIATIONS

- A - AMP CURRENT RATING
- AB - MOUNT ABOVE BENCH.
- AFFL - ABOVE FINISHED FLOOR LEVEL.
- BB - MOUNT BELOW BENCH.
- BH - MOUNT ON BULKHEAD.
- CEIL - MOUNT ON CEILING.
- CS - MOUNT WITHIN CEILING SPACE.
- C/W - COMPLETE WITH.
- DW - DISHWASHER.
- HP - HOT PLATE.
- MCB - MINIATURE CIRCUIT BREAKER.
- MSB - MAIN SWITCHBOARD.
- MSSB - MECHANICAL SERVICES SWITCHBOARD.
- MW - MICROWAVE.
- N - NEON / LED INDICATOR WHEN ON.
- NTS - NOT TO SCALE.
- OV - OVEN.
- RCD - CIRCUIT PROTECTED VIA A 30mA RESIDUAL CURRENT DEVICE INTEGRAL TO THE CIRCUIT BREAKER.
- REF - REFRIGERATOR.
- UNO - UNLESS NOTED OTHERWISE.
- WP - WEATHERPROOF TO IP56 UNO.
- 500 - NUMBER DENOTES MOUNTING HEIGHT AFFL.

LEGEND

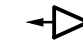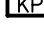
-  ELECTRICAL SERVICES SWITCHBOARD.
-  SWITCHBOARD / CONTROL PANEL NOT PROVIDED AS PART OF THE ELECTRICAL SUBCONTRACT.
-  SINGLE POWER OUTLET.
-  DOUBLE POWER OUTLET.
-  DOUBLE POWER OUTLET C/W USB CHARGING PORTS.
-  SPECIAL PURPOSE POWER OUTLET.
-  HAND DRYER CONNECTION.
-  SINGLE PHASE ISOLATOR.
-  THREE PHASE ISOLATOR.
-  ONE-WAY LIGHT SWITCH.
-  ONE-WAY LIGHT SWITCH, ARCHITRAVE STYLE.
-  CIRCUIT LINE.
-  SWITCH LINE.
-  POWER CIRCUIT DESIGNATION. DENOTES DB AND CIRCUIT.
-  ELECTRICAL EQUIPMENT AS NOTED.
-  OUTLETS TO BE MOUNTED WITHIN A RECESS KIT.
-  RJ45 COMMUNICATIONS OUTLET.

LEGEND

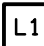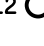-  SECURITY DIRECTIONAL MOTION DETECTOR.
-  SECURITY KEY PAD.
-  SCHOOL BELL SPEAKER.
-  FIRE EVACUATION SPEAKER.
-  SMOKE DETECTOR.
-  PRESENCE DETECTOR.
-  E1: GENERAL RECESSED LED NON-MAINTAINED EMERGENCY LIGHT. WHITE.
-  EX: EXIT LIGHT. WHITE.
-  L1: 600 x 600 T-BAR MOUNTED LED FLAT PANEL.
-  L2: 13W RECESSED DOWNLIGHT.
-  L3: LED STRIP LIGHT MOUNTED BELOW OVERHEAD CUPBOARD.
-  L4: 8W RECESSED DOWNLIGHT.

DB-CG DISTRIBUTION BOARD SCHEDULE

PROVIDE THE FOLLOWING CIRCUITS TO DB-CG REMOVE ALL EXISTING REDUNDANT SWITCHGEAR AND UPDATE THE SCHEDULE						
CIRC	PH	CIRCUIT BREAKER (amps)	CONTROL EQUIPMENT	CABLE SIZE (mm2)	LOCATION	CIRCUIT USE
P1	1	20	RCBO	2.5	HEALTH & WELLBEING	MEETINGS
P2	1	20	RCBO	2.5	HEALTH & WELLBEING	WAITING
P3	1	20	RCBO	2.5	HEALTH & WELLBEING	OFFICES
P4	1	20	RCBO	2.5	STAFF ROOM	GPOs
P5	1	20	RCBO	2.5	STAFF ROOM	GPOs
P6	1	20	RCBO	2.5	STAFF ROOM	GPOs
P7	1	20	RCBO	2.5	AMENITY	HAND DRYER
P8	1	20	RCBO	2.5	KITCHEN	GPOs
P9	1	20	RCBO	2.5	KITCHEN	REF
P10	3	40	RCBO	6.0	EXTERNAL	AC
P11	1	20	RCBO	2.5	KITCHEN	SUPATAP
P12	1	20	RCBO	2.5	KITCHEN	SUPATAP
P13	3	40	RCBO	6.0	KITCHEN	HWS
P14						
P15						
L1	1	20	RCBO	2.5	HEALTH & WELLBEING	LIGHTS
L2	1	20	RCBO	2.5	HEALTH & WELLBEING	LIGHTS
L3	1	20	RCBO	2.5	STAFF ROOM	LIGHTS

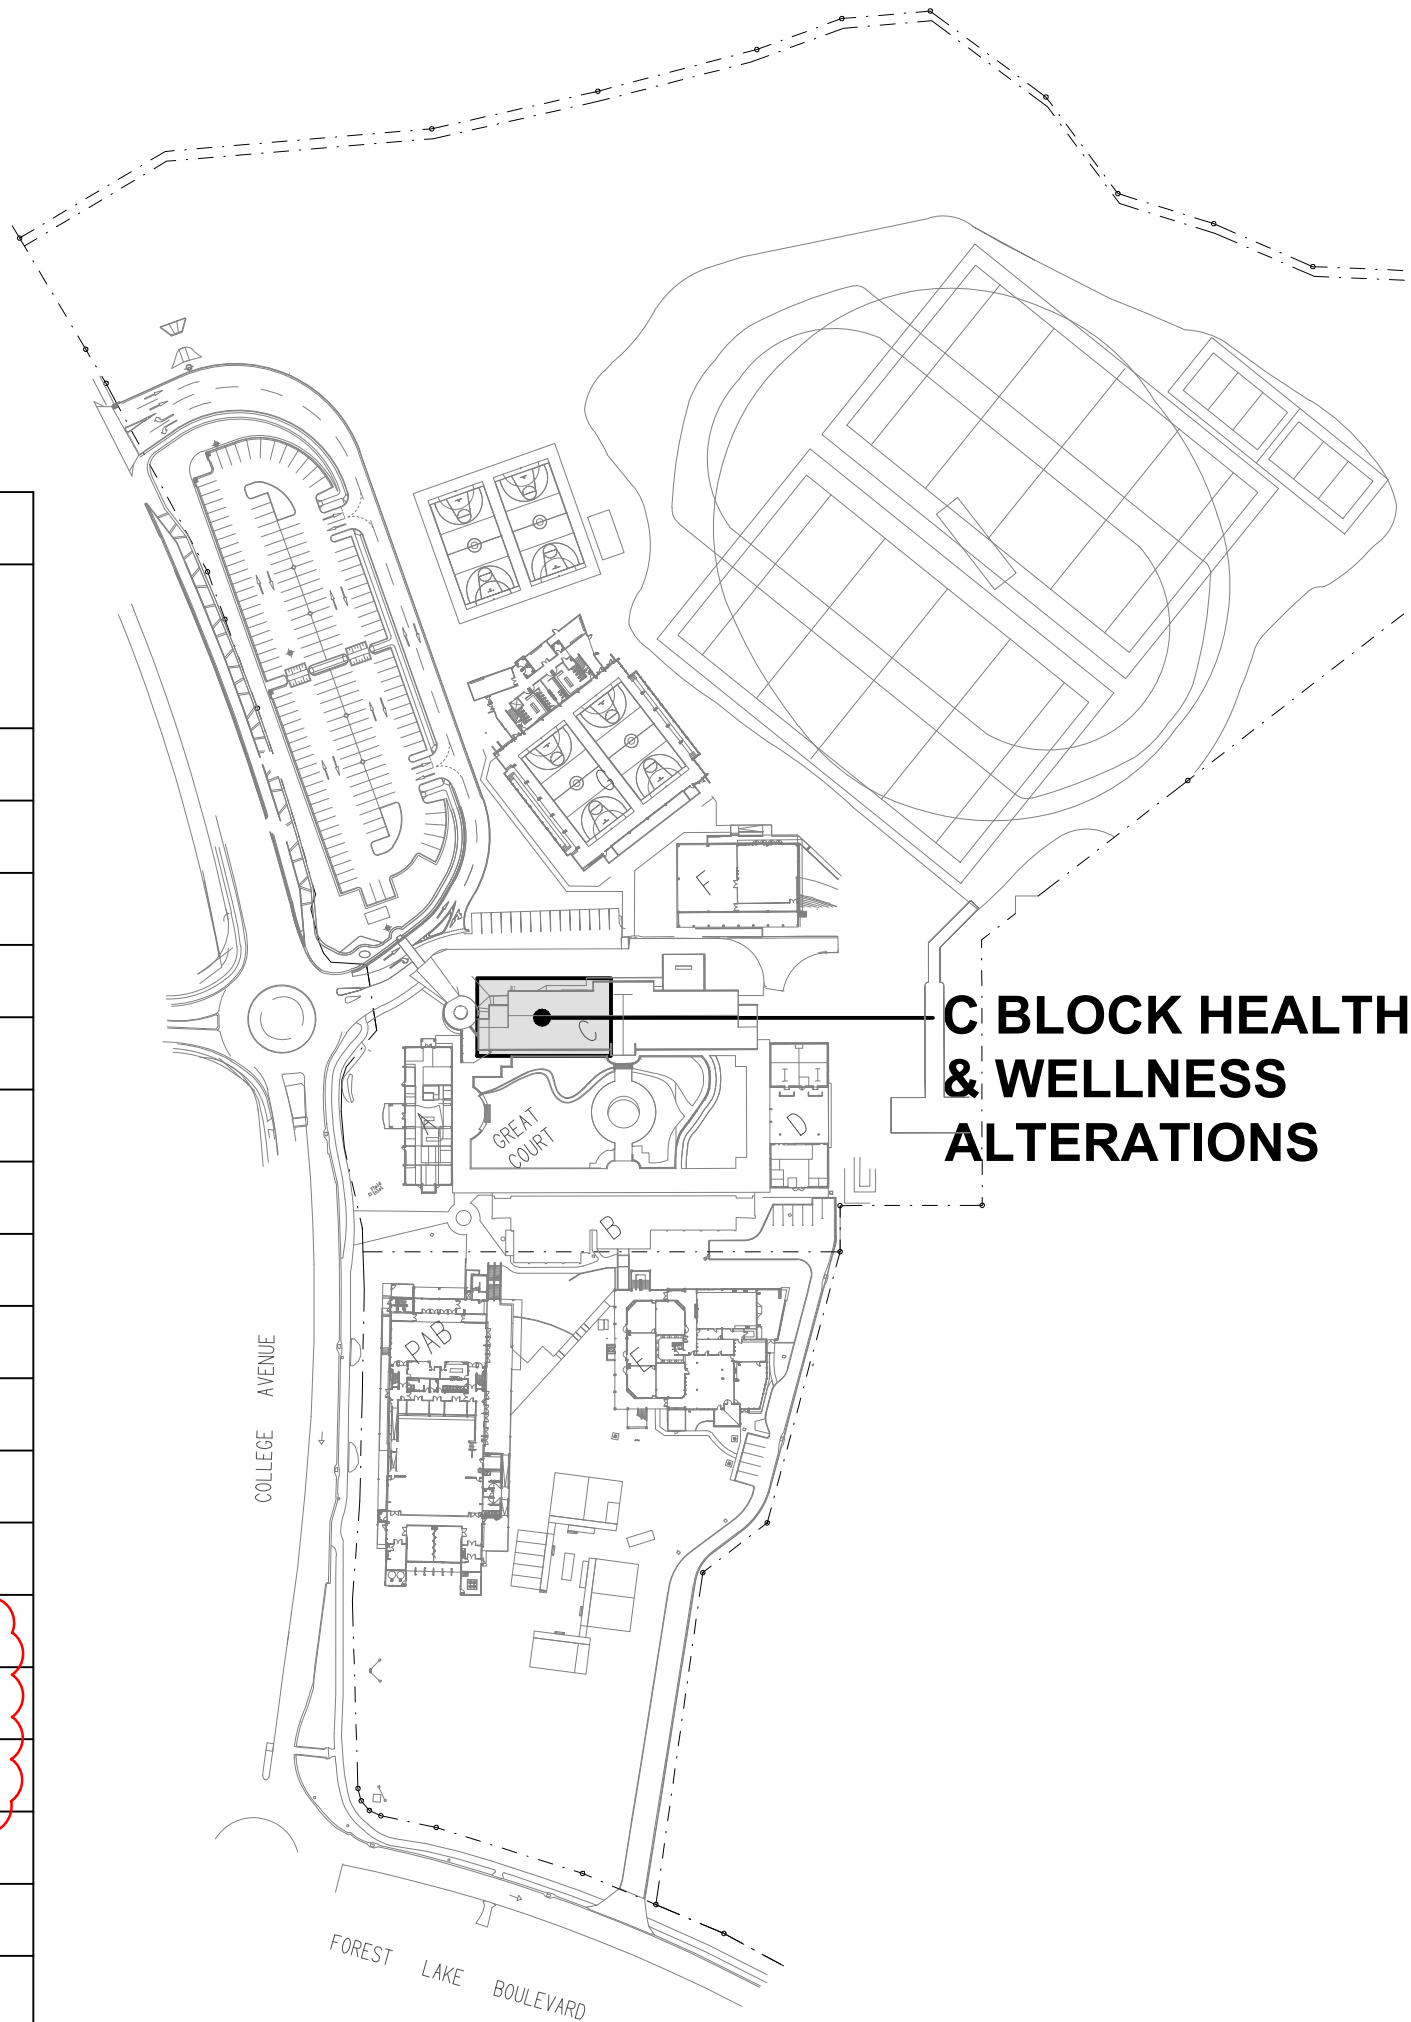

SITE PLAN

C BLOCK ALTERATIONS LOCATION
SCALE 1: 2000

B	TENDER	06/11/2023
REV.	DESCRIPTION:	DATE:
DRAWING: ELECTRICAL SERVICES LEGEND & SITE PLAN		
SCALE: 1:2000	AT A1	PROJECT NO: C3144a DRAWING NO: E01 REVISION: B

ELECTRICAL DESIGN GROUP BRISBANE
PTY LTD
ACN 092 710 793

TRADING AS:
ELECTRICAL DESIGN GROUP

THE COPYRIGHT OF THIS DRAWING
REMAINS THE PROPERTY OF THE
ELECTRICAL DESIGN GROUP.

USE FIGURED DIMENSIONS
IN PREFERENCE TO SCALE.


ALL DIMENSIONS TO BE
VERIFIED ONSITE.

 **ELECTRICAL DESIGN GROUP**
ELECTRICAL BUILDING SERVICES CONSULTANTS
BRISBANE GOLD COAST


P.O.Box 15, Sherwood Q.4075
Phone: (07) 3278 4375
Email: brisbane@edg.net.au
Web: www.edg.net.au

PROJECT:
**ST JOHNS ANGLICAN COLLEGE
FOREST LAKE - HEALTH & WELLBEING**


COLLEGE AVENUE, FOREST LAKE

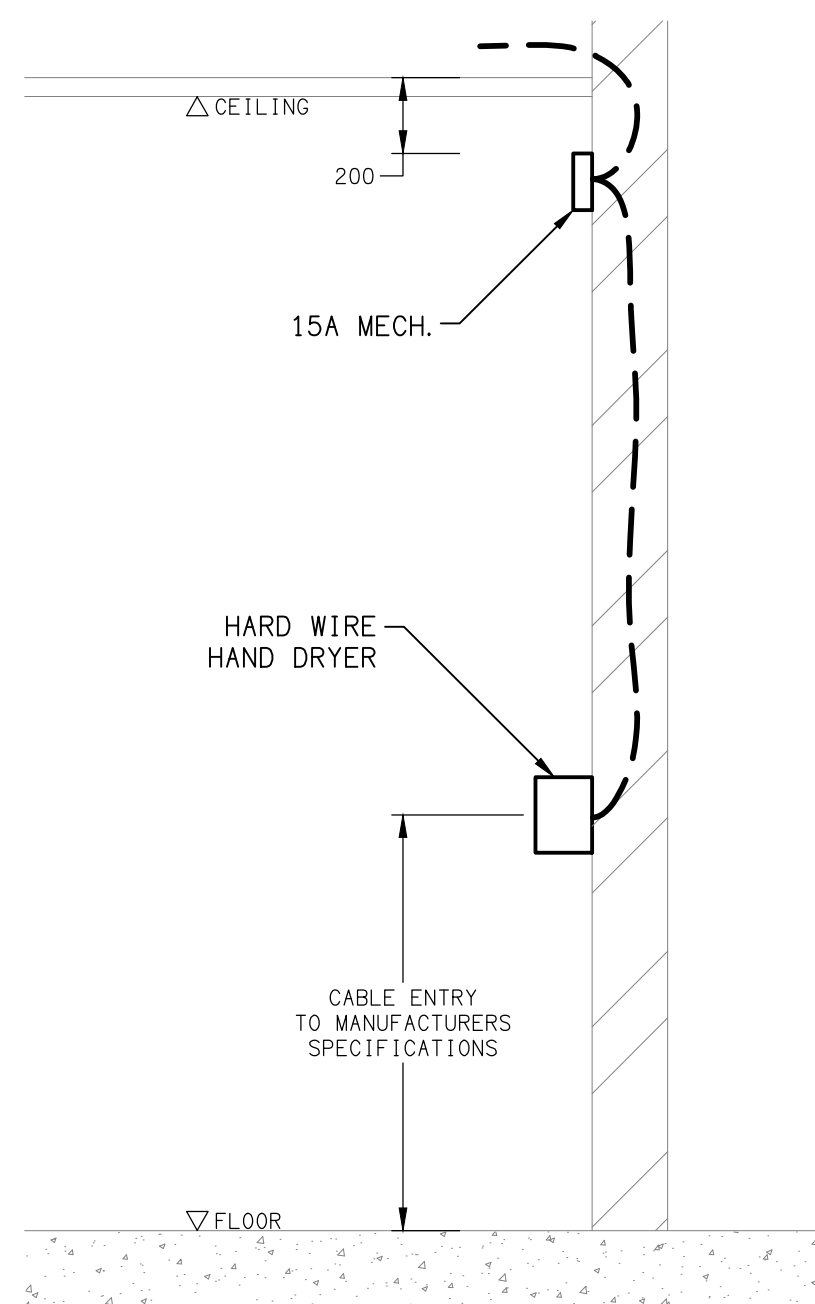

DETAIL B
HAND DRYER CONNECTION
NOT TO SCALE

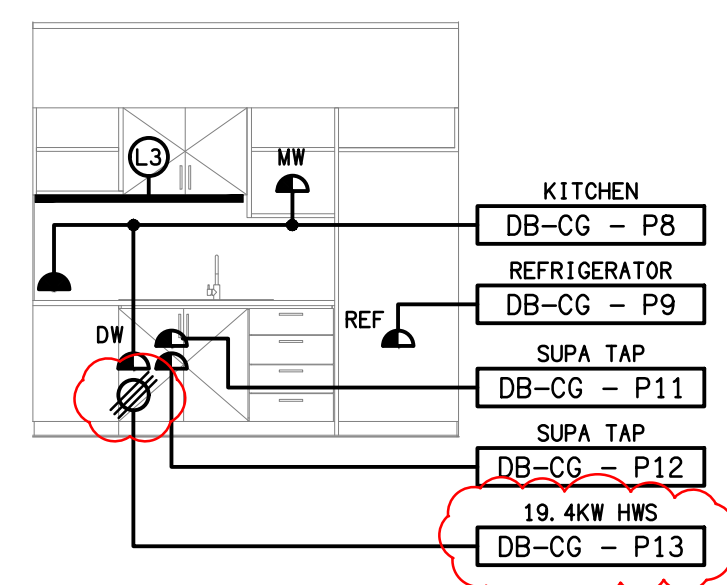

DETAIL A
ENTRY KITCHENETTE ELEVATION
NOT TO SCALE

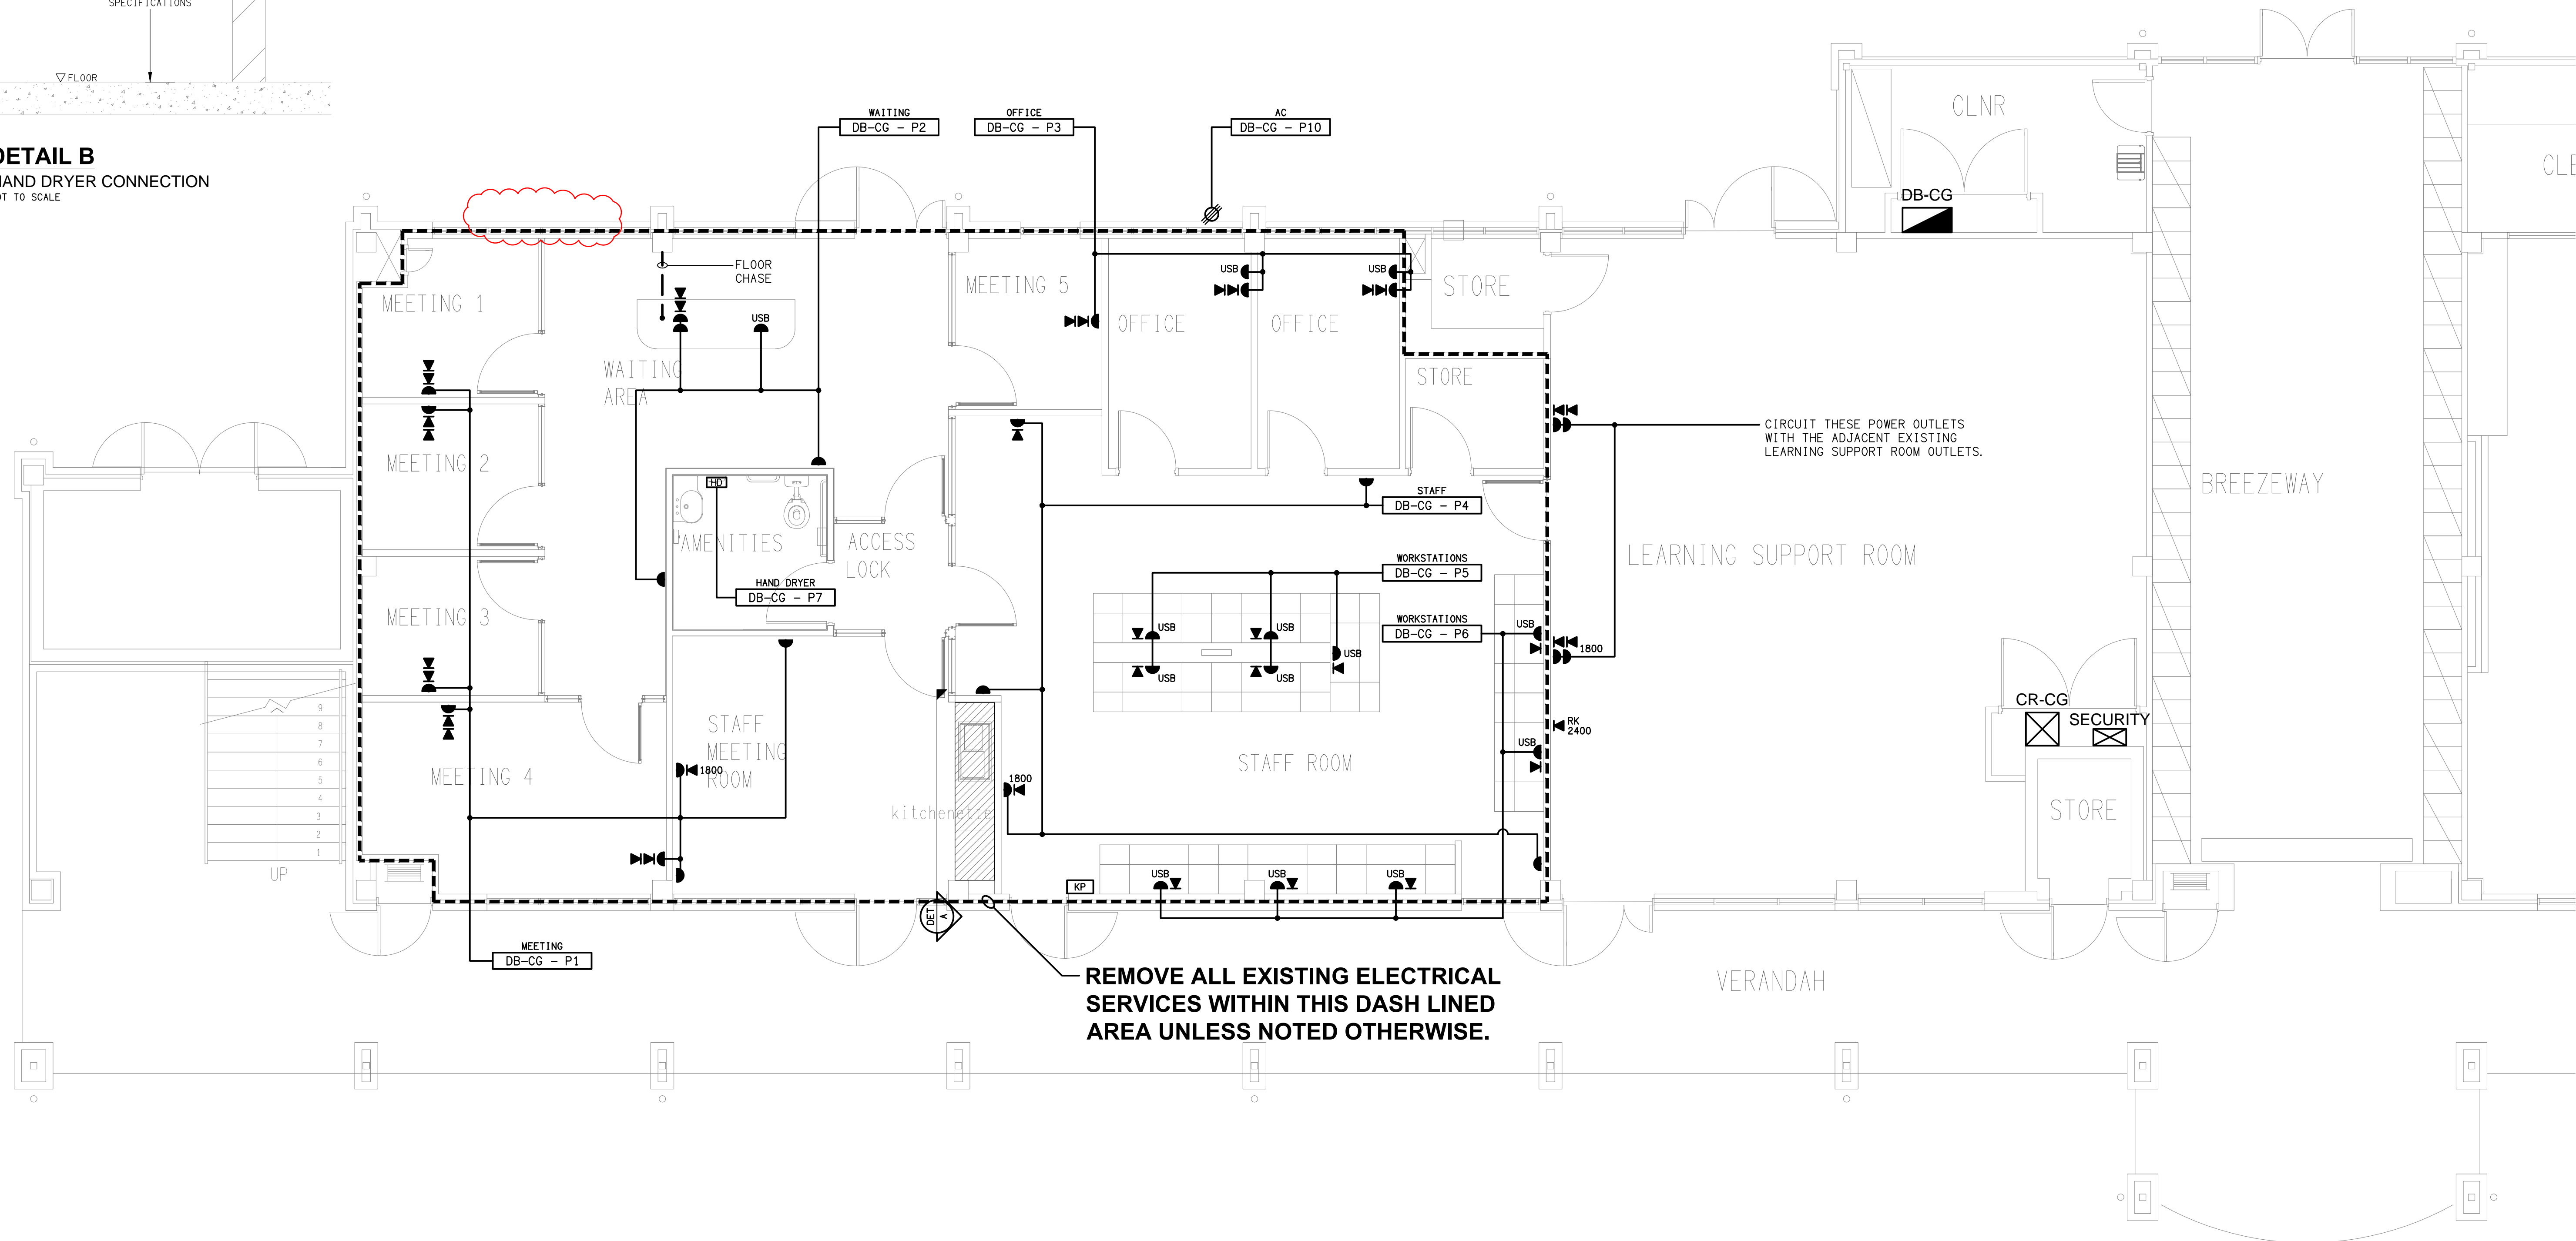

REMOVE ALL EXISTING ELECTRICAL
SERVICES WITHIN THIS DASH LINED
AREA UNLESS NOTED OTHERWISE.

ELECTRICAL DESIGN GROUP BRISBANE
PTY LTD
ACN 092 710 793
TRADING AS:
ELECTRICAL DESIGN GROUP

THE COPYRIGHT OF THIS DRAWING
REMAINS THE PROPERTY OF THE
ELECTRICAL DESIGN GROUP.
USE FIGURED DIMENSIONS
IN PREFERENCE TO SCALE.
ALL DIMENSIONS TO BE
VERIFIED ONSITE.

ELECTRICAL DESIGN GROUP
ELECTRICAL BUILDING SERVICES CONSULTANTS
BRISBANE GOLD COAST

P.O. Box 15, Sherwood Q.4075
Phone: (07) 3278 4375
Email: brisbane@edg.net.au
Web: www.edg.net.au

PROJECT:
**ST JOHNS ANGLICAN COLLEGE
FOREST LAKE - HEALTH & WELLBEING**

COLLEGE AVENUE, FOREST LAKE

B	TENDER	06/11/2023
REV:	DESCRIPTION:	DATE:

DRAWING:
**ELECTRICAL SERVICES
FLOOR PLAN**

SCALE:
1:50

AT A1

PROJECT NO:
C3144a

DRAWING NO:
E02

REVISION:
B

