



ELECTRICAL DESIGN GROUP

ELECTRICAL BUILDING SERVICES CONSULTANTS

P.O. Box 15, SHERWOOD Q. 4075

Phone: (07) 3278 4375

Website: www.edg.net.au Email: brisbane@edg.net.au

C3743a - COOLUM BEACH HOTEL

C3743a-0001(D).xls

ELECTRICAL SERVICES CONTRACT DOCUMENT SCHEDULE

REVISION D - 29 MAY 2026

ISSUING INFORMATION					DATE OF ISSUE				
	DAY	11	22	27	29				
	MONTH	05	05	05	05				
	YEAR	26	26	26	26				
	REASON FOR ISSUE	P	T	T	T				
A = APPROVAL C = CONSTRUCTION N = COORDINATION P = PRELIMINARY T = TENDER									

DISTRIBUTION					NUMBER OF COPIES				
WWW.EDG.NET.AU					1E	1E	1E	1E	
CAYAS & WARD ARCHITECTS					1E	1E	1E	1E	
P = PRINT T = TRACING D = DISC E = EMAIL F = FAX									

DOCUMENTS		REVISION							
C3743a-E01.dwg	LEGEND	A	B	C					
C3743a-E02.dwg	NOTES	A	B						
C3743a-E03.dwg	SITE PLAN	A	B						
C3743a-E04.dwg	FLOOR PLAN	A	B	C					
C3743a-E05.dwg	REFLECTED CEILING PLAN	A	B	C	D				
C3743a-E06.dwg	CANTEEN PLANS	A	B	C					
C3743a-E07.dwg	BAR FLOOR PLANS	A	B	C					
C3743a-E08.dwg	JOINERY & WALL LIGHTING PLAN	A	B	C	D				
C3743a-E09.dwg	JOINERY & WALL LIGHTING DETAILS	A	B	C					
C3743a-0001.xls	CONTRACT DOCUMENT SCHEDULE	A	B	C	D				
C3743a-0002.xls	EQUIPMENT SCHEDULE	A	B	C	D				
C3743a-0004.xls	LIGHTING CONTROL SCHEDULE		A	B	C				
C3743a-0005.xls	DISTRIBUTION BOARD DB-1 SCHEDULE		A	B					
C3743a-0006.xls	DISTRIBUTION BOARD DB-3 SCHEDULE		A	B					
C3743a-0007.xls	DISTRIBUTION BOARD DB-4 SCHEDULE		A						
C3743a-0001.zip	FITTING & OUTLET DATASHEETS			A					



ELECTRICAL DESIGN GROUP

ELECTRICAL BUILDING SERVICES CONSULTANTS

P.O. Box 15, SHERWOOD Q. 4075

Phone: (07) 3278 4375 Fax: (07) 3716 0222

Web Site: www.edg.net.au Email: brisbane@edg.net.au

C3743a - COOLUM BEACH HOTEL

C3743a-0002(D).xls

ELECTRICAL EQUIPMENT SCHEDULE

REVISION D - 29 MAY 2026

THE LIGHT FITTING SUPPLIER CONTACT DETAILS MAY BE AVAILABLE ON THE EDG WEBSITE VIA THE FOLLOWING LINK
www.edg.net.au/Links/Lighting.htm

TYPE	LAMPS	DESCRIPTION	COLOUR / ACCESSORY	CATALOGUE No	REV
S1	14.4W/M 2700K LED	LED STRIP IN A RECTANGULAR CONFIGURATION (FOUR SIDES) WITHIN A SCREW FIXED EXTRUSION C/W DIFFUSER BEHIND THE TV AS PER THE ARCHITECTURAL DETAIL. PROVIDE THE STRIP WITH REMOTE DALI DIMMABLE POWER SUPPLIES AS REQUIRED LOCATE THE POWER SUPPLIES IN A CONCEALED ACCESSIBLE POSITION NOTED ON THE AS CONSTRUCTED DOCUMENTS.	WHITE	RAPID LED R2334 2700K PLUS R2380 ALUMINIUM EXTRUSION OPAL DIFFUSER AND POWER SUPPLY & DALI CONTROLLER	B
S2	14.4W/M 2700K LED	LED STRIP WITHIN A SCREW FIXED EXTRUSION C/W DIFFUSER WITHIN THE BAR FRONT FEATURE AS PER THE ELEVATION. MOUNT AS PER THE ARCHITECTURAL DETAIL. PROVIDE THE STRIP WITH REMOTE DALI DIMMABLE POWER SUPPLIES AS REQUIRED LOCATE THE POWER SUPPLIES IN A CONCEALED ACCESSIBLE POSITION NOTED ON THE AS CONSTRUCTED DOCUMENTS.	NATURAL	RAPID LED R2334 2700 K PLUS ALUMINIUM EXTRUSION OPAL DIFFUSER AND POWER SUPPLY & DALI CONTROLLER	A
S3	10W/M 2700K LED	IP67 LED FLEX SCREW FIXED RECESSED ONTO THE REAR BAR JOINERY AS PER THE ELEVATION. MOUNT AS PER THE ARCHITECTURAL DETAIL. PROVIDE THE STRIP WITH REMOTE DALI DIMMABLE POWER SUPPLIES AS REQUIRED LOCATE THE POWER SUPPLIES IN A CONCEALED ACCESSIBLE POSITION NOTED ON THE AS CONSTRUCTED DOCUMENTS. CONFIRM THE BEND PLANE (TOP OR SIDE) ON SITE WITH THE ARCHITECT.	WHITE	RAPID LED R2321 OR R2322 - 2700K + POWER SUPPLY & DALI CONTROLLER	A
S4	14.4W/M 2700K LED	LED STRIP WITHIN A SCREW FIXED EXTRUSION C/W DIFFUSER MOUNTED ON TOP OF THE SUSPENDED SHELF AS PER THE ARCHITECTIAL DETAIL. PROVIDE THE STRIP WITH REMOTE DALI DIMMABLE POWER SUPPLIES AS REQUIRED LOCATE THE POWER SUPPLIES IN A CONCEALED ACCESSIBLE POSITION NOTED ON THE AS CONSTRUCTED DOCUMENTS.	NATURAL	RAPID LED R2334 PLUS ALUMINIUM EXTRUSION AND POWER SUPPLY & DALI CONTROLLER	A
S5	14.4W/M 2700K LED	THREE PARRALL RUNS OF LED STRIP WITHIN A SCREW FIXED EXTRUSION C/W DIFFUSER MOUNTED ON UNDERSIDE OF THE GAMING BAR BULKHEAD AS PER THE ARCHITECTIAL DETAIL. PROVIDE THE STRIP WITH REMOTE DALI DIMMABLE POWER SUPPLIES AS REQUIRED LOCATE THE POWER SUPPLIES IN A CONCEALED ACCESSIBLE POSITION NOTED ON THE AS CONSTRUCTED DOCUMENTS.	WHITE EXTRUSION	RAPID LED R2334 PLUS ALUMINIUM EXTRUSION AND POWER SUPPLY & DALI CONTROLLER	B
S6	10W/M 2700K LED	IP67 LED FLEX SCREW FIXED RECESSED ONTO THE REAR BAR JOINERY AS PER THE ELEVATION. MOUNT AS PER THE ARCHITECTURAL DETAIL. PROVIDE THE STRIP WITH REMOTE DALI DIMMABLE POWER SUPPLIES AS REQUIRED LOCATE THE POWER SUPPLIES IN A CONCEALED ACCESSIBLE POSITION NOTED ON THE AS CONSTRUCTED DOCUMENTS. CONFIRM THE BEND PLANE (TOP OR SIDE) ON SITE WITH THE ARCHITECT.	WHITE	RAPID LED R2321 OR R2322 - 2700K + POWER SUPPLY & DALI CONTROLLER	A



ELECTRICAL DESIGN GROUP

ELECTRICAL BUILDING SERVICES CONSULTANTS

P.O. Box 15, SHERWOOD Q. 4075

Phone: (07) 3278 4375 Fax: (07) 3716 0222

Web Site: www.edg.net.au Email: brisbane@edg.net.au

C3743a - COOLUM BEACH HOTEL

C3743a-0002(D).xls

ELECTRICAL EQUIPMENT SCHEDULE

REVISION D - 29 MAY 2026

THE LIGHT FITTING SUPPLIER CONTACT DETAILS MAY BE AVAILABLE ON THE EDG WEBSITE VIA THE FOLLOWING LINK
www.edg.net.au/Links/Lighting.htm

TYPE	LAMPS	DESCRIPTION	COLOUR / ACCESSORY	CATALOGUE No	REV
S7	14.4W/M 2700K LED	LED STRIP WITHIN A SCREW FIXED EXTRUSION C/W DIFFUSER BEHIND THE MIRROR AS PER THE ELEVATION. MOUNT AS PER THE ARCHITECTURAL DETAIL. PROVIDE THE STRIP WITH REMOTE DALI DIMMABLE POWER SUPPLIES AS REQUIRED LOCATE THE POWER SUPPLIES IN A CONCEALED ACCESSIBLE POSITION NOTED ON THE AS CONSTRUCTED DOCUMENTS.	NATURAL	RAPID LED R2334 PLUS ALUMINIUM EXTRUSION AND POWER SUPPLY & DALI CONTROLLER	A
S8	14.4W/M 2700K LED	LED STRIP WITHIN A SCREW FIXED EXTRUSION C/W DIFFUSER RECESSED INTO THE CEILING AS PER THE ARCHITECTURAL DETAIL. PROVIDE THE STRIP WITH REMOTE DALI DIMMABLE POWER SUPPLIES AS REQUIRED LOCATE THE POWER SUPPLIES IN A CONCEALED ACCESSIBLE POSITION NOTED ON THE AS CONSTRUCTED DOCUMENTS.	BLACK EXTRUSION	RAPID LED R2334 PLUS ALUMINIUM EXTRUSION AND POWER SUPPLY & DALI CONTROLLER	B
S9	14.4W/M 2700K LED	LED STRIP WITHIN A SCREW FIXED EXTRUSION C/W DIFFUSER MOUNTED WITHIN THE GAMING ROOM CURTAIN PELMET AS PER THE ELEVATION. MOUNT AS PER THE ARCHITECTURAL DETAIL. PROVIDE THE STRIP WITH REMOTE DALI DIMMABLE POWER SUPPLIES AS REQUIRED LOCATE THE POWER SUPPLIES IN A CONCEALED ACCESSIBLE POSITION NOTED ON THE AS CONSTRUCTED DOCUMENTS.	WHITE	RAPID LED R2334 PLUS ALUMINIUM EXTRUSION AND POWER SUPPLY & DALI CONTROLLER	A
S10	14.4W/M 2700K LED	LED STRIP WITHIN A SCREW FIXED EXTRUSION C/W DIFFUSER RISING VERTICALLY FROM THE FLOOR AND HORIZONALLY ACROSS THE DOORWAY IN THE GAMING ENTRY PORTAL Y AS PER THE ELEVATION. MOUNT AS PER THE ARCHITECTURAL DETAIL. PROVIDE THE STRIP WITH REMOTE DALI DIMMABLE POWER SUPPLIES AS REQUIRED LOCATE THE POWER SUPPLIES IN A CONCEALED ACCESSIBLE POSITION NOTED ON THE AS CONSTRUCTED DOCUMENTS.	WHITE	RAPID LED R2334 PLUS ALUMINIUM EXTRUSION AND POWER SUPPLY & DALI CONTROLLER	B
PD01	TRAILING EDGE DIMMABLE 240 VOLT 2700K E27 LED 1000 LUMENS +/- 10%	720 DIA X 220 HIGH DECORATIVE PENDANT. CONFIRM THE SUSPENSION HEIGHT ONSITE WITH THE ARCHITECT	WHITE	FAT SHACK VINTAGE HAMBLIN FABRIC PENDANT	B
PD02	TRAILING EDGE DIMMABLE 240 VOLT 2700K E27 LED 750 LUMENS +/- 10%	1000 DIA X 650 H DECORATIVE PENDANT. CONFIRM THE SUSPENSION HEIGHT ONSITE WITH THE ARCHITECT	RATTAN	THE STYLING REPUBLIC BETTY	B
PD03	TRAILING EDGE DIMMABLE 240 VOLT 2700K E27 LED 750 LUMENS +/- 10%	620 DIA X 380 HIGH DECORATIVE PENDANT. CONFIRM THE SUSPENSION HEIGHT ONSITE WITH THE ARCHITECT	NATURAL RATTAN	LIGHTHOUSE LANE PORTSEA PENDANT LIGHT	B

C3743a-0002(D).xls

Pages inc. any attach. 2 of 8



ELECTRICAL DESIGN GROUP

ELECTRICAL BUILDING SERVICES CONSULTANTS

P.O. Box 15, SHERWOOD Q. 4075

Phone: (07) 3278 4375 Fax: (07) 3716 0222

Web Site: www.edg.net.au Email: brisbane@edg.net.au

C3743a - COOLUM BEACH HOTEL


C3743a-0002(D).xls

ELECTRICAL EQUIPMENT SCHEDULE

REVISION D - 29 MAY 2026

THE LIGHT FITTING SUPPLIER CONTACT DETAILS MAY BE AVAILABLE ON THE EDG WEBSITE VIA THE FOLLOWING LINK
www.edg.net.au/Links/Lighting.htm

TYPE	LAMPS	DESCRIPTION	COLOUR / ACCESSORY	CATALOGUE No	REV
PD04	TRAILING EDGE DIMMABLE 240 VOLT 2200K E27 G45 LED 250 LUMENS +/- 10% 15,000 HOUR LIFE LAMP	DECORATIVE PENDANT C/W 2000 BRAIDED TEXTILE CABLE. CONFIRM THE SUSPENSION HEIGHT ONSITE WITH THE ARCHITECT	LARGE CLEAR SHADE	FAT SHACK CHAPMAN GLASS NORD PENDANT P1189-CLR-LRG	D
PD05	TRAILING EDGE DIMMABLE 240 VOLT 2200K E27 A60 LED 750 LUMENS +/- 10% 15,000 HOUR LIFE LAMP	600 DIA X 600 HIGH DECORATIVE PENDANT. CONFIRM THE SUSPENSION HEIGHT ONSITE WITH THE ARCHITECT	GOLD FINISH CHAIN BRONZE FRAME	ABOUT SPACE ID 128010 TYPE A J23 26-00006380	B
PD06	TRAILING EDGE DIMMABLE 240 VOLT 2200K E27 A60 LED 750 LUMENS +/- 10% 15,000 HOUR LIFE LAMP	1010 DIA X 580 HIGH DECORATIVE PENDANT. CONFIRM THE SUSPENSION HEIGHT ONSITE WITH THE ARCHITECT	GOLD FINISH CHAIN BRONZE FRAME	ABOUT SPACE ID 128010 TYPE B J23 26-00006380	B
PD07	TRAILING EDGE DIMMABLE 240 VOLT 2200K E27 G45 LED 250 LUMENS +/- 10% 15,000 HOUR LIFE LAMP	250 DIA DECORATIVE PENDANT. CONFIRM THE SUSPENSION HEIGHT ONSITE WITH THE ARCHITECT	GOLD	FAT SHACK ORBITAL GLASS PENDANT SKU: P420- OPL-GLD	D
PD08	TRAILING EDGE DIMMABLE 240 VOLT 2200K E14 LED 250 LUMENS +/- 10% 15,000 HOUR LIFE LAMP	150 DIA X 140 HIGH DECORATIVE PENDANT. CONFIRM THE SUSPENSION HEIGHT ONSITE WITH THE ARCHITECT	BLACK	FAT SHACK STELLER REEDED GLASS P1138-AMB	D
PD09	TRAILING EDGE DIMMABLE 240 VOLT 2200K E27 A60 LED 750 LUMENS +/- 10% 15,000 HOUR LIFE LAMP	750 DIA X 250 H DECORATIVE PENDANT. CONFIRM THE SUSPENSION HEIGHT ONSITE WITH THE ARCHITECT	RATTAN	TEMPLE & WEBSTER ZAYN RATTAN PENDANT	B
PD10	TRAILING EDGE DIMMABLE 240 VOLT 2700K E27 LED 750 LUMENS +/- 10%	770 DIA X 490 HIGH DECORATIVE PENDANT. CONFIRM THE SUSPENSION HEIGHT ONSITE WITH THE ARCHITECT	ROPE	TEMPLE & WBSTER EVERETT IRON ROPE 3 LAMP PENDANT	B
PD11	TRAILING EDGE DIMMABLE 240 VOLT 2700K E27 LED 750 LUMENS +/- 10%	ALLOW TO INSTALL ALLOW A PC SUM FOR THE SUPPLY OF EACH PD11 FITTING	TBA	ALLOW A PC SUM OF \$1,000.00 PLUS GST FOR THE SUPPLY OF EACH PD11 FITTING	C
WL01	INTEGRAL 8W 2700K LED	DECORATIVE 135 DIA X 80 DEEP WALL LIGHT MOUNTED AS PER THE ARCHITECTURAL DETAILS	AMBER	FAT SHACK SKU W1179-AMB-SAW	A

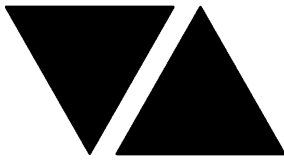

ELECTRICAL DESIGN GROUP

ELECTRICAL BUILDING SERVICES CONSULTANTS

P.O. Box 15, SHERWOOD Q. 4075

Phone: (07) 3278 4375 Fax: (07) 3716 0222

Web Site: www.edg.net.au Email: brisbane@edg.net.au

C3743a - COOLUM BEACH HOTEL

C3743a-0002(D).xls

ELECTRICAL EQUIPMENT SCHEDULE

REVISION D - 29 MAY 2026

THE LIGHT FITTING SUPPLIER CONTACT DETAILS MAY BE AVAILABLE ON THE EDG WEBSITE VIA THE FOLLOWING LINK
www.edg.net.au/Links/Lighting.htm

TYPE	LAMPS	DESCRIPTION	COLOUR / ACCESSORY	CATALOGUE No	REV
WL02	TRAILING EDGE DIMMABLE 240 VOLT 2200K E14 CANDLE LED 250 LUMENS +/- 10% 15,000 HOUR LIFE LAMP	DECORATIVE 250 HIGH X 150 DEEP WALL LIGHT MOUNTED AS PER THE ARCHITECTURAL DETAILS	WHITE SPECKLE	TEMPLE & WEBSTER CAPRI TERRACOTTA WALL SCONCE	A
WL03	TRAILING EDGE DIMMABLE 240 VOLT 2200K E14 CANDLE LED 250 LUMENS +/- 10% 15,000 HOUR LIFE LAMP	DECORATIVE 250 HIGH X 150 DEEP WALL LIGHT MOUNTED AS PER THE ARCHITECTURAL DETAILS	TERRACOTTA	TEMPLE & WEBSTER CAPRI TERRACOTTA WALL SCONCE	A
WL04	TRAILING EDGE DIMMABLE 240 VOLT 2200K G9 LED 250 LUMENS +/- 10% 15,000 HOUR LIFE LAMP	DECORATIVE 350 DIA X 150 PROJECTION WALL LIGHT MOUNTED AS PER THE ARCHITECTURAL DETAILS	ANTIQUE GOLD	ZEST LIGHTING MIKUMI PLEATED ANTIQUE GOLD BASE ROUND WALL LIGHT	B
WL05	TRAILING EDGE DIMMABLE 240 VOLT 2200K B22 A60 LED 250 LUMENS +/- 10% 15,000 HOUR LIFE LAMP	DECORATIVE 350 DIA X 270MM H LARGE WALL LIGHT MOUNTED AS PER THE ARCHITECTURAL DETAILS	WHITE SHADE WHITE SCONCE	FAT SHACK VINTAGE W819-WHT-LRG-WHT CONE ADJUSTABLE SWIVEL ARM	B
WL06	TRAILING EDGE DIMMABLE 240 VOLT 2200K E27 A60 LED 250 LUMENS +/- 10% 15,000 HOUR LIFE LAMP	DECORATIVE 320 DIA X 310 WALL LIGHT MOUNTED AS PER THE ARCHITECTURAL DETAILS	GRAPHITE	FATSHACK VINTAGE W119-GPH	B
WL07	NO LONGER REQUIRED				B
WL08	NO LONGER REQUIRED				B
WL09	NO LONGER REQUIRED				B
WL10	TRAILING EDGE DIMMABLE 240 VOLT 2200K GU10 LED 250 LUMENS +/- 10% 15,000 HOUR LIFE LAMP	DECORATIVE 110 DEEP X 100 L X 90 HIGH WALL LIGHT MOUNTED AS PER THE ARCHITECTURAL DETAILS	BLACK	ABOUT SPACE SILFA	B
WL11	INTEGRAL 15W 3000K LED	DECORATIVE 200 DIA X 70 DEEP WALL LIGHT MOUNTED AS PER THE ARCHITECTURAL DETAILS	WHITE	ABOUT SPACE KLIPS 200 DIA	B
WL12	INTEGRAL 6W 3000K LED	DECORATIVE 30 DEEP X 110 HIGH WALL LIGHT MOUNTED AS PER THE ARCHITECTURAL DETAILS	BLACK	ABOUT SPACE JBO WALL LIGHT	B



ELECTRICAL DESIGN GROUP

ELECTRICAL BUILDING SERVICES CONSULTANTS

P.O. Box 15, SHERWOOD Q. 4075

Phone: (07) 3278 4375 Fax: (07) 3716 0222

Web Site: www.edg.net.au Email: brisbane@edg.net.au

C3743a - COOLUM BEACH HOTEL

C3743a-0002(D).xls

ELECTRICAL EQUIPMENT SCHEDULE

REVISION D - 29 MAY 2026

THE LIGHT FITTING SUPPLIER CONTACT DETAILS MAY BE AVAILABLE ON THE EDG WEBSITE VIA THE FOLLOWING LINK
www.edg.net.au/Links/Lighting.htm

TYPE	LAMPS	DESCRIPTION	COLOUR / ACCESSORY	CATALOGUE No	REV
WLE	EXISTING WALL MOUNTED LIGHT FITTING TO BE RETAINED AND RESUPPLIED AS INDICATED. WITHIN ONE WEEK OF BEING AWARDED THE CONTRACT CONFIRM THE EXISTING LAMP TYPE AND CONTROL TYPE AS TRAILING EDGE, LEADING EDGE, DSI, 0-10, DALI OR SWITCHED.				A
RD01	15W 3000K LED	90 DIA RECESSED DOWNLIGHT C/W 24 DEG BEAM REMOTE DALI DIMMABLE DRIVER	WHITE	RAPID R1078-WH-15W-WW-DALI	A
RD02	15W 3000K LED	75 DIA RECESSED ADJUSTABLE DOWNLIGHT C/W REMOTE DALI DIMMABLE DRIVER	WHITE	RAPID R1077-WH-15W-WW-DALI	A
RD03	15W 3000K LED	RECESSED RECTANGULAR DOUBLE HEAD ADJUSTABLE DOWNLIGHT C/W 24 DEG BEAM REMOTE DALI DIMMABLE DRIVER	WHITE	RAPID R1067-WH-15W-WW-DALI	A
RD04	18W 3000K LED	150 DIA IP54 RECESSED DOWNLIGHT C/W 24 DEG BEAM REMOTE DALI DIMMABLE DRIVER	WHITE	RAPID R1093-18-WH-SIL-TRI DALI	B
RD10	NO LONGER REQUIRED				C
RD11	18W 3000K LED	150 DIA IP54 RECESSED DOWNLIGHT C/W 24 DEG BEAM REMOTE DALI DIMMABLE DRIVER	WHITE	RAPID R1093-18-WH-SIL-TRI DALI	A
RDE	EXISTING LIGHT FITTING TO BE RETAINED AND RESUPPLIED AS INDICATED. WITHIN ONE WEEK OF BEING AWARDED THE CONTRACT CONFIRM THE EXISTING LAMP TYPE AND CONTROL TYPE AS TRAILING EDGE, LEADING EDGE, DSI, 0-10, DALI OR SWITCHED.				A
SL01	15W 3000K LED	SURFACE MOUNTED 62 DIA 172 HIGH CAN DOWNLIGHT C/W 40DEG BEAM REMOTE DALI DIMMABLE DRIVER	WHITE	LUMEN 8 SOLIS SOROSU15930TR WHITE 15W 40DEG	B
SL02	40W 3000K LED	SURFACE MOUNTED 72 DIA 210 HIGH CAN DOWNLIGHT C/W 45DEG BEAM REMOTE DALI DIMMABLE DRIVER	WHITE	LUMEN 8 SOROSU40930ND WHITE 40W 40DEG	B
SL03	15W 3000K LED	SURFACE MOUNTED 62 DIA 172 HIGH CAN DOWNLIGHT C/W 40DEG BEAM REMOTE DALI DIMMABLE DRIVER	WHITE	LUMEN 8 SOLIS SOROSU15930TR WHITE 15W 40DEG	B
SL04	40W 3000K LED	SURFACE MOUNTED 72 DIA 210 HIGH CAN DOWNLIGHT C/W 45DEG BEAM REMOTE DALI DIMMABLE DRIVER AND A CUSTOM ANGLED TIMBER MOUNTING BLOCK TO ALLOW THE FITTING TO MOUNT VERTICALLY. THE MOUNTING BLOCK IS TO BE PAINTED TO MATCH THE FITTING COLOUR AND BE AS SMALL AS PRACTICAL.	WHITE	LUMEN 8 SOROSU40930ND WHITE 40W 40DEG	B

C3743a-0002(D).xls

Pages inc. any attach. 5 of 8



ELECTRICAL DESIGN GROUP

ELECTRICAL BUILDING SERVICES CONSULTANTS

P.O. Box 15, SHERWOOD Q. 4075

Phone: (07) 3278 4375 Fax: (07) 3716 0222

Web Site: www.edg.net.au Email: brisbane@edg.net.au

C3743a - COOLUM BEACH HOTEL


C3743a-0002(D).xls

ELECTRICAL EQUIPMENT SCHEDULE

REVISION D - 29 MAY 2026

THE LIGHT FITTING SUPPLIER CONTACT DETAILS MAY BE AVAILABLE ON THE EDG WEBSITE VIA THE FOLLOWING LINK
www.edg.net.au/Links/Lighting.htm

TYPE	LAMPS	DESCRIPTION	COLOUR / ACCESSORY	CATALOGUE No	REV
SLE	EXISTING SURFACE MOUNTED LIGHT FITTING TO BE RETAINED AND RESUPPLIED AS INDICATED. WITHIN ONE WEEK OF BEING AWARDED THE CONTRACT CONFIRM THE EXISTING LAMP TYPE AND CONTROL TYPE AS TRAILING EDGE, LEADING EDGE, DSI, 0-10, DALI OR SWITCHED.				A
GL01	8W 3000K LED	GARDEN STAKE FITTING C/W REMOTE DALI DIMMABLE DRIVER MOUNT THE FITTING IN THE GARDEN AS PER THE ARCHITECTURAL DETAIL. IT IS ACCEPTABLE TO SUPPLY MULTIPLE UP2 FITTINGS ON THE SAME CHANNEL FROM A SINGLE SUITABLY SIZED DRIVER / POWER SUPPLY	BLACK	GAMMA ILLUMINATION RULLO 1373- FL-8W- 3K	A
BL01	2200K LED	TREE BUD LIGHTS. ALLOW A PC SUM FOR THE SUPPLY AND INSTALLATION OF EACH BL01 FITTING.	WHITE	ALLOW A PC SUM OF \$10,000.00 PLUS GST FOR THE SUPPLY OF EACH BD01 FITTING	A
G1	10W/M 2700K LED	IP67 LED FLEX SCREW FIXED IN THE GAMING CEILING FEATURE COFFER ABOVE THE PLANTER AS PER THE ARCHITECTURAL DETAIL. PROVIDE THE STRIP WITH REMOTE DALI DIMMABLE POWER SUPPLIES AS REQUIRED LOCATE THE POWER SUPPLIES IN A CONCEALED ACCESSIBLE POSITION NOTED ON THE AS CONSTRUCTED DOCUMENTS. CONFIRM THE BEND PLANE (TOP OR SIDE) ON SITE WITH THE ARCHITECT.	WHITE	RAPID LED R2334 2700K PLUS R2380 ALUMINIUM EXTRUSION OPAL DIFFUSER AND POWER SUPPLY & DALI CONTROLLER	B
R1	10W/M 2700K LED	IP67 LED FLEX SCREW FIXED IN THE GAMING CEILING FEATURE COFFER ABOVE THE PLANTER AS PER THE ARCHITECTURAL DETAIL. PROVIDE THE STRIP WITH REMOTE DALI DIMMABLE POWER SUPPLIES AS REQUIRED LOCATE THE POWER SUPPLIES IN A CONCEALED ACCESSIBLE POSITION NOTED ON THE AS CONSTRUCTED DOCUMENTS. CONFIRM THE BEND PLANE (TOP OR SIDE) ON SITE WITH THE ARCHITECT.	WHITE	RAPID LED R2334 2700K PLUS R2380 ALUMINIUM EXTRUSION OPAL DIFFUSER AND POWER SUPPLY & DALI CONTROLLER	B
FE	EXISTING CEILING FAN AND ASSOCIATED CONTROLLER TO BE RETAINED.				A
F02	REPLACE THE EXISTING CEILING FAN AND CONTROLLER WITH A NEW 1320 DIA COASTAL GRADE FAN AND WALL MOUNTED CONTROLLER UTILISE THE EXISTING CIRCUIT		WHITE	VENTAIR SPIN1304WH	C
FS01	1W LED AT 500 CENTRES	REPLACE THE EXISTING FESTOON LIGHT WITH NEW 24V DC IP65 FESTOON LIGHTING TO BE FIXED TO A 316 STAINLESS STEEL WIRE SUPPORT SYSTEM. SUPPLY THE NEW FESTOON LIGHTS VIA REMOTE DALI DIMMABLE DRIVERS IN A CONCEALED ACCESSIBLE POSITIONS NOTED ON THE AS CONSTRUCTED DOCUMENTS. CONFIRM THE LENGTH AND POSITION ON SITE CONNECT THE NEW FESTOON LIGHTS WITH A NEW SUPPLY TO THE NEW LIGHTING CONTROL SYSTEM	BLACK CABLE AND FIXINGS 316 STAINLESS STEEL SUPPORT AND FIXINGS	FIRE FLY FFC-LS-50-24VE27-BK	A

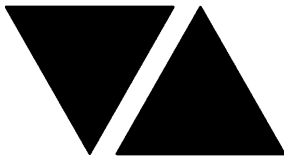

ELECTRICAL DESIGN GROUP

ELECTRICAL BUILDING SERVICES CONSULTANTS

P.O. Box 15, SHERWOOD Q. 4075

Phone: (07) 3278 4375 Fax: (07) 3716 0222

Web Site: www.edg.net.au Email: brisbane@edg.net.au

C3743a - COOLUM BEACH HOTEL

C3743a-0002(D).xls

ELECTRICAL EQUIPMENT SCHEDULE

REVISION D - 29 MAY 2026

THE LIGHT FITTING SUPPLIER CONTACT DETAILS MAY BE AVAILABLE ON THE EDG WEBSITE VIA THE FOLLOWING LINK
www.edg.net.au/Links/Lighting.htm

TYPE	LAMPS	DESCRIPTION	COLOUR / ACCESSORY	CATALOGUE No	REV
FDE		EXISTING FLOOD LIGHT TO BE RETAINED AND RESUPPLIED AS INDICATED. WITHIN ONE WEEK OF BEING AWARDED THE CONTRACT CONFIRM THE EXISTING LAMP TYPE AND CONTROL TYPE AS TRAILING EDGE, LEADING EDGE, DSI, 0-10, DALI OR SWITCHED.			A
E1	LED	EMERGENCY LIGHT: RECESSED NON-MAINTAINED EMERGENCY LIGHT. AS2293 CLASSIFICATION C0-D40 - C90-D40.	WHITE	CLEVERTRONICS LLIFE	A
E2		EXISTING EMERGENCY LIGHT TO BE RETAINED			A
EX E3		EXISTING EMERGENCY EXIT LIGHT TO BE RETAINED			A
EX	LED	EXIT LIGHT: MAINTAINED 24M VIEWING DISTANCE EXIT LIGHT C/W DIFFUSERS & DIRECTIONAL ARROWS AS SHOWN. CEILING SURFACE MOUNT OR WALL MOUNT BETWEEN 2100mm & 2700mm AFFL IF THERE IS NO VERTICAL SURFACE TO MOUNT THE FITTING ON WITHIN THIS RANGE CONFIRM THE MOUNTING HEIGHT WITH THE ENGINEER. AS2293 CLASSIFICATION C0-D1.25- C90-D2	WHITE	CLEVERTRONICS LUBPRO-SM	A
EX BK	LED	EXIT LIGHT: MAINTAINED 24M VIEWING DISTANCE EXIT LIGHT C/W DIFFUSERS & DIRECTIONAL ARROWS AS SHOWN. CEILING SURFACE MOUNT OR WALL MOUNT BETWEEN 2100mm & 2700mm AFFL IF THERE IS NO VERTICAL SURFACE TO MOUNT THE FITTING ON WITHIN THIS RANGE CONFIRM THE MOUNTING HEIGHT WITH THE ENGINEER. AS2293 CLASSIFICATION C0-D1.25- C90-D2	BLACK	CLEVERTRONICS LUBPRO-SM-BLK	A
CHANNEL x		CONTROL CHANNEL WITH A NUMERICAL REFERENCE. REFER TO THE POWER AND LIGHTING CONTROL SCHEMATIC / SCHEDULE			A
LIGHTING CONTROL SWITCH PANEL 1 (SP1)		EXISTING DYNALITE ANTUMBRA DISPLAY TO BE CONNECTED TO THE NEW LIGHTING CONTROL SYSTEM. REMOVE THE EXISTING MANUAL LIGHTING CONTROLS THAT BECOME REDUNDANT.			A
LIGHTING CONTROL SWITCH PANEL 2 (SP2)		6-BUTTON PROGRAMMABLE SWITCH PANEL C/W CENTRAL LCD DISPLAY MOUNTED AT 1000mm AFFL UNLESS NOTED OTHERWISE. REMOVE THE EXISTING MANUAL LIGHTING CONTROLS THAT BECOME REDUNDANT.	ALUMINIUM	DYNALITE ANTUMBRA DISPLAY	A
LIGHTING CONTROL SWITCH PANEL 3 (SP3)		6-BUTTON PROGRAMMABLE SWITCH PANEL C/W CENTRAL LCD DISPLAY MOUNTED AT 1000mm AFFL UNLESS NOTED OTHERWISE. REMOVE THE EXISTING MANUAL LIGHTING CONTROLS THAT BECOME REDUNDANT.	ALUMINIUM	DYNALITE ANTUMBRA DISPLAY	A
AUTO DOOR SINGLE POWER OUTLET (AD)		SINGLE POWER OUTLET C/W CIRCUIT IDENTIFICATION ON THE FACEPLATE BEHIND THE SURROUND MOUNT AT 300mm AFFL U.N.O. RATING 10A U.N.O.	WHITE UNLESS NOTED AS BLACK (BK)	CLIPSAL C2000 SERIES	A

C3743a-0002(D).xls

Pages inc. any attach. 7 of 8



ELECTRICAL DESIGN GROUP

ELECTRICAL BUILDING SERVICES CONSULTANTS

P.O. Box 15, SHERWOOD Q. 4075

Phone: (07) 3278 4375 Fax: (07) 3716 0222

Web Site: www.edg.net.au Email: brisbane@edg.net.au

C3743a - COOLUM BEACH HOTEL


C3743a-0002(D).xls

ELECTRICAL EQUIPMENT SCHEDULE

REVISION D - 29 MAY 2026

THE LIGHT FITTING SUPPLIER CONTACT DETAILS MAY BE AVAILABLE ON THE EDG WEBSITE VIA THE FOLLOWING LINK
www.edg.net.au/Links/Lighting.htm

TYPE	LAMPS	DESCRIPTION	COLOUR / ACCESSORY	CATALOGUE No	REV
AUTO DOOR SINGLE POWER OUTLET (AD)		SINGLE POWER OUTLET C/W CIRCUIT IDENTIFICATION LOCATED CONCEALED WITHIN THE AUTO DOOR HEAD MULLION RATING 10A U.N.O.	WHITE	CLIPSAL C2000 SERIES	A
DOUBLE POWER OUTLET		DOUBLE POWER OUTLET C/W CIRCUIT IDENTIFICATION ON THE FACEPLATE BEHIND THE SURROUND MOUNT AT 300mm AFFL U.N.O. RATING 10A U.N.O.	WHITE UNLESS NOTED AS BLACK (BK)	CLIPSAL C2000 SERIES	A
SIGN CONNECTION		COORDINATE THE LOCATION AND CONNECTION WITH THE SIGN CONTRACTOR ENSURING THE CONNECTION ARE PROVIDED WITH APPROPRIATE WEATHER PROTECTION AND ARE CONCEALED FROM VIEW.			A
DB-1		EXISTING DISTRIBUTION BOARD DB-1 LOCATED ON THE MEZZANINE LEVEL TO BE PROVIDED WITH NEW SWITCHGEAR TO ACCOMMODATE THE NEW CIRCUITS AS NOTED IN THE DISTRIBUTION BOARD DB-1 SCHEDULE. ANY EXISTING CIRCUITS THAT BECOME REDUNDANT DUE TO THE WORKS ARE TO BE REMOVED. PROVIDE DB-1 WITH A WALL MOUNTED DIN RAIL CUBICAL TO ACCOMMODATE THE NEW DB-1 LIGHTING CONTROL GEAR. ENSURE THE CUBICAL CONTAINS AT LEAST ONE SPARE 600 WIDE HORIZONTAL DIN RAIL IN ADDITION TO THAT NECESSARY TO ACCOMMODATE THE INITIAL DYNALITE CONTROL EQUIPMENT.			A
DB-2		EXISTING DISTRIBUTION BOARD DB-2 LOCATED ON THE MEZZANINE LEVEL TO BE USED AS THE GAMING DB BY THE GAMING ELECTRICIAN. ANY EXISTING CIRCUITS THAT BECOME REDUNDANT DUE TO THE WORKS ARE TO BE REMOVED. RELOCATE ANY EXISTING CIRCUITS THAT REMAIN TO DB-1.			A
DB-3		EXISTING DISTRIBUTION BOARD DB-3 TO BE PROVIDED WITH NEW SWITCHGEAR TO ACCOMMODATE THE NEW CIRCUITS AS NOTED IN THE DISTRIBUTION BOARD DB-3 SCHEDULE. ANY EXISTING CIRCUITS THAT BECOME REDUNDANT DUE TO THE WORKS ARE TO BE REMOVED. PROVIDE DB-3 WITH A WALL MOUNTED DIN RAIL CUBICAL TO ACCOMMODATE THE NEW DB-3 LIGHTING CONTROL GEAR. ENSURE THE CUBICAL CONTAINS AT LEAST ONE SPARE 600 WIDE HORIZONTAL DIN RAIL IN ADDITION TO THAT NECESSARY TO ACCOMMODATE THE INITIAL DYNALITE CONTROL EQUIPMENT.			A
DB-4		EXISTING DISTRIBUTION BOARD DB-4 TO BE PROVIDED WITH NEW SWITCHGEAR TO ACCOMMODATE THE NEW CIRCUITS AS NOTED IN THE DISTRIBUTION BOARD DB-4 SCHEDULE. ANY EXISTING CIRCUITS THAT BECOME REDUNDANT DUE TO THE WORKS ARE TO BE REMOVED. PROVIDE DB-4 WITH A WALL MOUNTED DIN RAIL CUBICAL TO ACCOMMODATE THE NEW DB-4 LIGHTING CONTROL GEAR. ENSURE THE CUBICAL CONTAINS AT LEAST ONE SPARE 600 WIDE HORIZONTAL DIN RAIL IN ADDITION TO THAT NECESSARY TO ACCOMMODATE THE INITIAL DYNALITE CONTROL EQUIPMENT.			A
MSB		EXISTING HOTEL MAIN SWITCHBOARD LOCATED ON THE MEZZANINE LEVEL TO REMAIN.			A

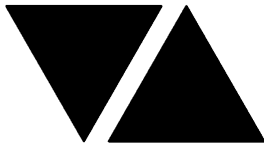

ELECTRICAL DESIGN GROUP

ELECTRICAL BUILDING SERVICES CONSULTANTS

P.O. Box 15, SHERWOOD Q. 4075

Phone: (07) 3278 4375 Fax: (07) 3716 0222

Web Site: www.edg.net.au Email: brisbane@edg.net.au


C3743a - COOLUM BEACH HOTEL

C3743a-0004(C).xls

LIGHTING CONTROL SCHEDULE

REVISION C - 29 MAY 2026

MISCELLANEOUS EQUIPMENT					REV
ITEM	DESCRIPTION				A
SP1	CONNECT THE EXISTING DYNALITE SWITCH PANEL INTO THE NEW DYNALITE CONTROL SYSTEM AND REPROGRAMME IT AS IF IT IS NEW				A
SP2	REMOVE THE EXISTING MANUAL LIGHTING CONTROLS AND MAKE GOOD PROVIDE A NEW 6-BUTTON PROGRAMMABLE SWITCH PANEL C/W CENTRAL LCD DISPLAY DYNALITE ANTUMBRA DISPLAY ALUMINIUM				A
SP3	REMOVE THE EXISTING MANUAL LIGHTING CONTROLS AND MAKE GOOD PROVIDE A NEW 6-BUTTON PROGRAMMABLE SWITCH PANEL C/W CENTRAL LCD DISPLAY DYNALITE ANTUMBRA DISPLAY ALUMINIUM				A
PE CELL	PROGRAMMABLE PE CELL DUS 90CS CONFIRM THE LOCATION ON SITE WITH THE ARCHITECT				A
TIME CLOCK	PROGRAMMABLE TIME CLOCK ENVISION GATEWAY PDEG LOCATED IN DB-A				A
CONTROL MODULE 1					A
TYPE:		DYNALITE DDMC802			A
DESCRIPTION		8CH MODULAR CONTROLLER			A
LOCATION		DIN RAIL MOUNTED WITHIN NEW ENCLOSURE ADJACENT DB-1			A
BUS:		A			A
CHANNEL	CONTROL	DESCRIPTION			A
		LOCATION	CIRCUIT	USE	A
1-1	DGTM202		DB-1 -L1	WL01	A
1-2				WL03	A
1-3				WL12	A
1-4	DGTM202			PD10	A
1-5				PD03	A
1-6	DGTM202				A
1-7					A
1-8					A
CONTROL MODULE 2					A
TYPE:		DYNALITE DDMC802			A
DESCRIPTION		8CH MODULAR CONTROLLER			A
LOCATION		DIN RAIL MOUNTED WITHIN NEW ENCLOSURE ADJACENT DB-1			A
BUS:		A			A
CHANNEL	CONTROL	DESCRIPTION			A
		LOCATION	CIRCUIT	USE	A
1-9	DGTM202		DB-1 -L2	PD02	A
1-10				PD01	B
1-11	DGTM202			PD09	A
1-12				PD09	A
1-13					A
1-14					A
1-15					A
1-16					A

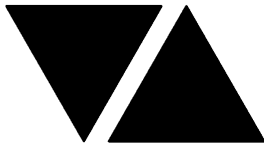

ELECTRICAL DESIGN GROUP

ELECTRICAL BUILDING SERVICES CONSULTANTS

P.O. Box 15, SHERWOOD Q. 4075

Phone: (07) 3278 4375 Fax: (07) 3716 0222

Web Site: www.edg.net.au Email: brisbane@edg.net.au


C3743a - COOLUM BEACH HOTEL

C3743a-0004(C).xls

LIGHTING CONTROL SCHEDULE

REVISION C - 29 MAY 2026

CONTROL MODULE 3					A
TYPE:		DYNALITE DDMC802			A
DESCRIPTION		8CH MODULAR CONTROLLER			A
LOCATION		DIN RAIL MOUNTED WITHIN NEW ENCLOSURE ADJACENT DB-1			A
BUS:		A			A
CHANNEL	CONTROL	DESCRIPTION			A
		LOCATION	CIRCUIT	USE	A
1-17	DGTM202		DB-1 -L3	PD06 & PD05	B
1-18				WL11	A
1-19	DGTM202			WL04	A
1-20				PD07	A
1-21	DGTM202			WL02	A
1-22					A
1-23					A
1-24					A
CONTROL MODULE 4					A
TYPE:		DYNALITE DDBC1200			A
DESCRIPTION		12CH BOARD CAST DALI CONTROLLER			A
LOCATION		DIN RAIL MOUNTED WITHIN NEW ENCLOSURE ADJACENT DB-1			A
BUS:		A			A
CHANNEL	CONTROL	DESCRIPTION			A
		LOCATION	CIRCUITS	USE	A
1-25	DALI DIM		DB-1- L4	RD02	A
1-26	DALI DIM		DB-1- L4	RD01	A
1-27	DALI DIM		DB-1- L4	S3	A
1-28	DALI DIM		DB-1- L4	S3	A
1-29	DALI DIM		DB-1- L4	RD01	A
1-30	DALI DIM		DB-1- L4	S5	A
1-31	DALI DIM		DB-1- L4	S2	A
1-32	DALI DIM		DB-1- L4	S2	A
1-33	DALI DIM		DB-1- L4	RD02	A
1-34					A
1-35					A
1-36					A
CONTROL MODULE 5					A
TYPE:		DYNALITE DDBC1200			A
DESCRIPTION		12CH BOARD CAST DALI CONTROLLER			A
LOCATION		DIN RAIL MOUNTED WITHIN NEW ENCLOSURE ADJACENT DB-1			A
BUS:		A			A
CHANNEL	CONTROL	DESCRIPTION			A
		LOCATION	CIRCUITS	USE	A
1-37	DALI DIM		DB-1- L5	S1	A
1-38	DALI DIM		DB-1- L5	S7	A
1-39	DALI DIM		DB-1- L5	S9	A
1-40	DALI DIM		DB-1- L5	S8	A
1-41	DALI DIM		DB-1- L5	G1	A
1-42					C
1-43	DALI DIM		DB-1- L5	R1	A
1-44	DALI DIM		DB-1- L6	RD01	A
1-45	DALI DIM		DB-1- L6	RD01	A
1-46	DALI DIM		DB-1- L5	S10	A
1-47					A
1-48					A

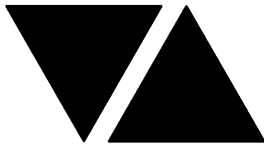

ELECTRICAL DESIGN GROUP

ELECTRICAL BUILDING SERVICES CONSULTANTS

P.O. Box 15, SHERWOOD Q. 4075

Phone: (07) 3278 4375 Fax: (07) 3716 0222

Web Site: www.edg.net.au Email: brisbane@edg.net.au


C3743a - COOLUM BEACH HOTEL

C3743a-0004(C).xls

LIGHTING CONTROL SCHEDULE

REVISION C - 29 MAY 2026

CONTROL MODULE 6					A
TYPE:		DYNALITE DDBC1200			A
DESCRIPTION		12CH BOARD CAST DALI CONTROLLER			A
LOCATION		DIN RAIL MOUNTED WITHIN NEW ENCLOSURE ADJACENT DB-1			A
BUS:		A			A
CHANNEL	CONTROL	DESCRIPTION			A
		LOCATION	CIRCUITS	USE	A
1-49	DALI DIM		DB-1- L7	RD03	A
1-50	DALI DIM		DB-1- L7	RD03	A
1-51	DALI DIM		DB-1- L7	RD03	A
1-52	DALI DIM		DB-1- L7	RD03	A
1-53	DALI DIM		DB-1- L7	BL01	A
1-54	DALI DIM		DB-1- L7	GL01	A
1-55	DALI DIM		DB-1- L10	SL04	A
1-56					A
1-57					A
1-58					A
1-59					A
1-60					A
CONTROL MODULE 7					A
TYPE:		DYNALITE DDRC1220FR-GL			A
DESCRIPTION		12CH 20 A FEEDTHROUGH RELAY CONTROLLER			A
LOCATION		DIN RAIL MOUNTED WITHIN NEW ENCLOSURE ADJACENT DB-1			A
BUS:		A			A
CHANNEL	CONTROL	DESCRIPTION			A
		LOCATION	CIRCUIT	USE	A
1-61	SWITCHED		DB-1- L8	SIGN	A
1-62	SWITCHED		DB-1- L8	SIGN	A
1-63	SWITCHED		DB-1- L8	SIGN	A
1-64	SWITCHED		DB-1- L8	SIGN	A
1-65	SWITCHED		DB-1- L8	SIGN	A
1-66	SWITCHED	AMENITIES	DB-1- L11	LIGHTS	B
1-67					A
1-68					A
					A
					A
					A
					A
CONTROL MODULE 8					A
TYPE:		DYNALITE DDMC802			A
DESCRIPTION		8CH MODULAR CONTROLLER			A
LOCATION		DIN RAIL MOUNTED WITHIN NEW ENCLOSURE ADJACENT DB-1			A
BUS:		A			A
CHANNEL	CONTROL	DESCRIPTION			A
		LOCATION	CIRCUIT	USE	A
1-69	DGTM202		DB-1 -L9	SLE	A
1-70					A
1-71	DGTM202			SLE	A
1-72					A
1-73					A
1-74					A
1-75					A
1-76					A

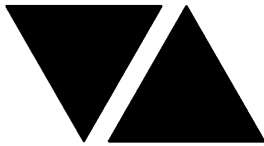

ELECTRICAL DESIGN GROUP

ELECTRICAL BUILDING SERVICES CONSULTANTS

P.O. Box 15, SHERWOOD Q. 4075

Phone: (07) 3278 4375 Fax: (07) 3716 0222

Web Site: www.edg.net.au Email: brisbane@edg.net.au


C3743a - COOLUM BEACH HOTEL

C3743a-0004(C).xls

LIGHTING CONTROL SCHEDULE

REVISION C - 29 MAY 2026

CONTROL MODULE 9					A
TYPE:		DYNALITE DDMC802			A
DESCRIPTION		8CH MODULAR CONTROLLER			A
LOCATION		DIN RAIL MOUNTED WITHIN NEW ENCLOSURE ADJACENT DB-3			A
BUS:		A			A
CHANNEL	CONTROL	DESCRIPTION			A
		LOCATION	CIRCUIT	USE	A
3-1	DGT M202		DB-3 -L1	WL11	A
3-2				WL10	A
3-3	DGT M202			WL12	A
3-4				FDE	A
3-5	DGT M202			FDE	A
3-6				SLE	A
3-7					A
3-8					A
CONTROL MODULE 10					A
TYPE:		DYNALITE DDMC802			A
DESCRIPTION		8CH MODULAR CONTROLLER			A
LOCATION		DIN RAIL MOUNTED WITHIN NEW ENCLOSURE ADJACENT DB-3			A
BUS:		A			A
CHANNEL	CONTROL	DESCRIPTION			A
		LOCATION	CIRCUIT	USE	A
3-9	DGT M202		DB-3 -L2	WL06	A
3-10				PD04	B
3-11	DGT M202			WL06	A
3-12				WL01	A
3-13	DGT M202			WL01	A
3-14				WL11	A
3-15					A
3-16					A
CONTROL MODULE 11					A
TYPE:		DYNALITE DDMC802			A
DESCRIPTION		8CH MODULAR CONTROLLER			A
LOCATION		DIN RAIL MOUNTED WITHIN NEW ENCLOSURE ADJACENT DB-3			A
BUS:		A			A
CHANNEL	CONTROL	DESCRIPTION			A
		LOCATION	CIRCUIT	USE	A
3-17	DGT M202		DB-3 -L3	WL01	A
3-18				WL05	A
3-19	DGT M202			WL11	A
3-20				WL12	A
3-21	DGT M202			PD11	A
3-22					A
3-23					A
3-24					A

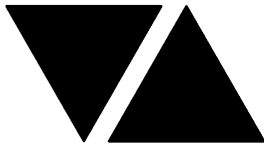

ELECTRICAL DESIGN GROUP

ELECTRICAL BUILDING SERVICES CONSULTANTS

P.O. Box 15, SHERWOOD Q. 4075

Phone: (07) 3278 4375 Fax: (07) 3716 0222

Web Site: www.edg.net.au Email: brisbane@edg.net.au


C3743a - COOLUM BEACH HOTEL

C3743a-0004(C).xls

LIGHTING CONTROL SCHEDULE

REVISION C - 29 MAY 2026

CONTROL MODULE 12					A
TYPE:		DYNALITE DDBC1200			A
DESCRIPTION		12CH BOARD CAST DALI CONTROLLER			A
LOCATION		DIN RAIL MOUNTED WITHIN NEW ENCLOSURE ADJACENT DB-3			A
BUS:		A			A
CHANNEL	CONTROL	DESCRIPTION			A
		LOCATION	CIRCUITS	USE	A
3-25	DALI DIM		DB-3 -L4	FS01	A
3-26	DALI DIM		DB-3 -L4	RD03	A
3-27	DALI DIM		DB-3 -L4	RD01	A
3-28	DALI DIM		DB-3 -L4	SL04	B
3-29	DALI DIM		DB-3 -L5	RD03	A
3-30	DALI DIM		DB-3 -L5	S1	A
3-31	DALI DIM		DB-3 -L5	BL01	A
3-32	DALI DIM		DB-3 -L5	GL01	A
3-33	DALI DIM		DB-3 -L5	S3	A
3-34	DALI DIM		DB-3 -L5	S2	A
3-35	DALI DIM		DB-3 -L5	S4	A
3-36					A
CONTROL MODULE 13					A
TYPE:		DYNALITE DDBC1200			A
DESCRIPTION		12CH BOARD CAST DALI CONTROLLER			A
LOCATION		DIN RAIL MOUNTED WITHIN NEW ENCLOSURE ADJACENT DB-3			A
BUS:		A			A
CHANNEL	CONTROL	DESCRIPTION			A
		LOCATION	CIRCUITS	USE	A
3-37	DALI DIM		DB-3 -L6	SL03	A
3-38	DALI DIM		DB-3 -L6	RD03	A
3-39	DALI DIM		DB-3 -L6	RD01	A
3-40	DALI DIM		DB-3 -L6	SL02	A
3-41	DALI DIM		DB-3 -L6	SL03	A
3-42	DALI DIM		DB-3 -L6	SL01	A
3-43	DALI DIM		DB-3 -L7	RD11	A
3-44					A
3-45					A
3-46					A
3-47					A
3-48					A
CONTROL MODULE 14					A
TYPE:		DYNALITE DDRC1220FR-GL			A
DESCRIPTION		12CH 20 A FEEDTHROUGH RELAY CONTROLLER			A
LOCATION		DIN RAIL MOUNTED WITHIN NEW ENCLOSURE ADJACENT DB-3			A
BUS:		A			A
CHANNEL	CONTROL	DESCRIPTION			A
		LOCATION	CIRCUIT	USE	A
3-49					B
3-50	SWITCHED		DB-3 -L9	SIGN	A
3-51	SWITCHED		DB-3 -L9	SIGN	A
3-52	SWITCHED	AMENITIES	DB-3 -L10	LIGHTS	B
3-53					A
3-54					A
3-55					A
3-56					A
3-57					A
3-58					A
3-59					A
3-60					A

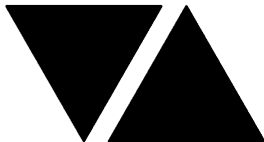

ELECTRICAL DESIGN GROUP

ELECTRICAL BUILDING SERVICES CONSULTANTS

P.O. Box 15, SHERWOOD Q. 4075

Phone: (07) 3278 4375 Fax: (07) 3716 0222

Web Site: www.edg.net.au Email: brisbane@edg.net.au

C3743a - COOLUM BEACH HOTEL

C3743a-0004(C).xls

LIGHTING CONTROL SCHEDULE

REVISION C - 29 MAY 2026

CONTROL MODULE 15					A
TYPE:		DYNALITE DDRC1220FR-GL			A
DESCRIPTION		12CH 20 A FEEDTHROUGH RELAY CONTROLLER			A
LOCATION		DIN RAIL MOUNTED WITHIN NEW ENCLOSURE ADJACENT DB-4			A
BUS:		A			A
CHANNEL	CONTROL	DESCRIPTION			A
		LOCATION	CIRCUIT	USE	A
4-1	DALI DIM		DB-4 -L1	RD11	A
4-2	DALI DIM		DB-4 -L1	RD04	A
4-3	DALI DIM		DB-4 -L1	RD03	A
4-4	DALI DIM		DB-4 -L1	S6	A
4-5	DALI DIM		DB-4 -L1	RD02	A
CONTROL MODULE 16					A
TYPE:		DYNALITE DDMC802			A
DESCRIPTION		8CH MODULAR CONTROLLER			A
LOCATION		DIN RAIL MOUNTED WITHIN NEW ENCLOSURE ADJACENT DB-4			A
BUS:		A			A
CHANNEL	CONTROL	DESCRIPTION			A
		LOCATION	CIRCUIT	USE	A
4-6	DGTM202		DB-4 -L2	PD04	B
4-7				WL10	A
4-8	DGMM204			SIGNS	A
4-9				SIGNS	A
4-10					A
4-11					A
4-12					A
4-13					A



ELECTRICAL DESIGN GROUP

ELECTRICAL BUILDING SERVICES CONSULTANTS

P.O. Box 15, SHERWOOD Q. 4075

Phone: (07) 3278 4375

Website: www.edg.net.au Email: brisbane@edg.net.au

C3743a - COOLUM BEACH HOTEL

C3743a-0005(B).xls

DISTRIBUTION BOARD DB-1

REVISION B - 27 MAY 2026

							REV
UPDATE THE EXISTING DISTRIBUTION BOARD TO ACCOMMODATE THE FOLLOWING CIRCUITS. ALL EXISTING SWITCHGEAR THAT HAS BECOME REDUNDANT IS TO BE REMOVED. THE DB-2 CIRCUITS THAT REMAIN ARE TO BE RESUPPLIED FROM DB-1 WITH NEW SWITCHGEAR. IT IS ACCEPTABLE TO UTILISE EXISTING SPARE SWITCHGEAR IF IT IS IN GOOD CONDITION AND HAS THE APPROPRIATE CAPACITY AND FUNCTIONS. UPDATE THE CIRCUIT AT PRACTICAL COMPLETION SUCH THAT THE DESCRIPTION INDICATES THE CIRCUIT USE AND LOCATION.							A
CIRC	PH	CIRCUIT BREAKER (amps)	CONTROL EQUIPMENT	CABLE SIZE (mm ²)	LOCATION	CIRCUIT USE	
P1	1	20	RCBO	2.5		CLEANING	A
P2	1	20	RCBO	2.5		TV	A
P3	1	20	RCBO	2.5		WATER FILTER	A
P4	1	20	RCBO	2.5	ENTRY	LED SCREEN	B
P5	1	20	RCBO	2.5	ENTRY	LED SCREEN	B
L1	1	20	RCBO	2.5		LIGHTING	A
L2	1	20	RCBO	2.5		LIGHTING	A
L3	1	20	RCBO	2.5		LIGHTING	A
L4	1	20	RCBO	2.5		LIGHTING	A
L5	1	20	RCBO	2.5		LIGHTING	A
L6	1	20	RCBO	2.5		LIGHTING	A
L7	1	20	RCBO	2.5		LIGHTING	A
L8	1	20	RCBO	2.5		LIGHTING	A
L9	1	20	RCBO	2.5		LIGHTING	A
L10	1	20	RCBO	2.5		LIGHTING	A
L11	1	20	RCBO	2.5	AMENITIES	LIGHTING	B



ELECTRICAL DESIGN GROUP

ELECTRICAL BUILDING SERVICES CONSULTANTS

P.O. Box 15, SHERWOOD Q. 4075

Phone: (07) 3278 4375

Website: www.edg.net.au Email: brisbane@edg.net.au

C3743a - COOLUM BEACH HOTEL

C3743a-0006(B).xls

DISTRIBUTION BOARD DB-3

REVISION B - 27 MAY 2026

							REV
UPDATE THE EXISTING DISTRIBUTION BOARD TO ACCOMMODATE THE FOLLOWING CIRCUITS. ALL EXISTING SWITCHGEAR THAT HAS BECOME REDUNDANT IS TO BE REMOVED. IT IS ACCEPTABLE TO UTILISE EXISTING SPARE SWITCHGEAR IF IT IS IN GOOD CONDITION AND HAS THE APPROPRIATE CAPACITY AND FUNCTIONS. UPDATE THE CIRCUIT AT PRACTICAL COMPLETEION SUCH THAT THE DESCRIPTION INDICATES THE CIRCUIT USE AND LOCATION.							A
CIRC	PH	CIRCUIT BREAKER (amps)	CONTROL EQUIPMENT	CABLE SIZE (mm ²)	LOCATION	CIRCUIT USE	
P1	1	20	RCBO	2.5	EXTERNAL	STAGE	A
P2	1	20	RCBO	2.5	EXTERNAL	STAGE	A
P3	1	20	RCBO	2.5		TV	A
P4	1	20	RCBO	2.5		TV	A
P5	1	20	RCBO	2.5		CLEANING	A
P6	1	20	RCBO	2.5		ATM	A
P7	1	20	RCBO	2.5		AUTO DOOR	A
P8	1	20	RCBO	2.5		TAB	A
P9	1	20	RCBO	2.5		TAB	A
L1	1	20	RCBO	2.5		LIGHTING	A
L2	1	20	RCBO	2.5		LIGHTING	A
L3	1	20	RCBO	2.5		LIGHTING	A
L4	1	20	RCBO	2.5		LIGHTING	A
L5	1	20	RCBO	2.5		LIGHTING	A
L6	1	20	RCBO	2.5		LIGHTING	A
L7	1	20	RCBO	2.5		LIGHTING	A
L8							B
L9	1	20	RCBO	2.5		LIGHTING	A
L10	1	20	RCBO	2.5	AMENITIES	LIGHTING	B



ELECTRICAL DESIGN GROUP

ELECTRICAL BUILDING SERVICES CONSULTANTS

P.O. Box 15, SHERWOOD Q. 4075

Phone: (07) 3278 4375

Website: www.edg.net.au Email: brisbane@edg.net.au

C3743a - COOLUM BEACH HOTEL








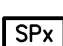
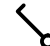








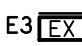









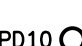
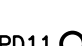
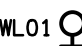
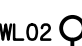
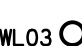
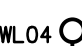
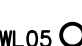
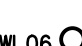



C3743a-0007(A).xls

DISTRIBUTION BOARD DB-4

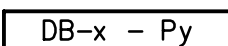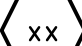


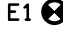

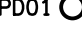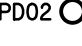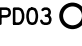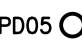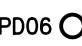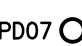





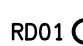















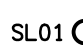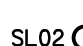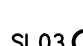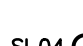

REVISION A - 22 MAY 2026


							REV
UPDATE THE EXISTING DISTRIBUTION BOARD TO ACCOMMODATE THE FOLLOWING CIRCUITS. ALL EXISTING SWITCHGEAR THAT HAS BECOME REDUNDANT IS TO BE REMOVED. IT IS ACCEPTABLE TO UTILISE EXISTING SPARE SWITCHGEAR IF IT IS IN GOOD CONDITION AND HAS THE APPROPRIATE CAPACITY AND FUNCTIONS. UPDATE THE CIRCUIT AT PRACTICAL COMPLETION SUCH THAT THE DESCRIPTION INDICATES THE CIRCUIT USE AND LOCATION.							A
CIRC	PH	CIRCUIT BREAKER (amps)	CONTROL EQUIPMENT	CABLE SIZE (mm ²)	LOCATION	CIRCUIT USE	
P1	1	20	RCBO	2.5		REF	A
P2	1	20	RCBO	2.5		GLASS WASHER	A
P3	1	20	RCBO	2.5		HEAT LAMPS	A
L1	1	20	RCBO	2.5		LIGHTING	A
L2	1	20	RCBO	2.5		LIGHTING	A

LEGEND

-  ELECTRICAL SERVICES SWITCHBOARD.
-  SWITCHBOARD / CONTROL PANEL NOT PROVIDED AS PART OF THE ELECTRICAL SUBCONTRACT.
-  SINGLE POWER OUTLET.
-  DOUBLE POWER OUTLET.
-  EXIST  EXISTING POWER OUTLET TO REAMIN AS NOTED.
-  SIGNAGE CONNECTION.
-  SPx LIGHTING CONTROL SWITCHPANEL, TYPE x.
-  ONE-WAY LIGHT SWITCH.
-  CIRCUIT LINE.
-  SWITCH LINE.
-  DB-x - Py POWER CIRCUIT DESIGNATION. DENOTES DB AND CIRCUIT.
-  LIGHTING CONTROL CHANNEL REFERENCE.
-  ELECTRICAL EQUIPMENT AS NOTED.
-  REFER TO DETAIL NOTED FOR THE AREA SHOWN HATCHED. ADDITIONAL OUTLETS & FITTINGS MAY BE SHOWN ON DETAIL.
-  E1 E1: GENERAL CEILING RECESSED LED EMERGENCY LIGHT, WHITE.
-  E2 E2: EXISTING EMERGENCY LIGHT TO BE RETAINED.
-  E3  EX: EXISTING EMERGENCY EXIT LIGHT TO BE RETAINED. .
-  EX: EMERGENCY LED EXIT LIGHT, WHITE.
-  PD01 PD01: DECORATIVE SUSPENDED PENDANT.
-  PD02 PD02: DECORATIVE SUSPENDED PENDANT.
-  PD03 PD03: DECORATIVE SUSPENDED PENDANT.
-  PD05 PD05: DECORATIVE SUSPENDED PENDANT.
-  PD06 PD06: DECORATIVE SUSPENDED PENDANT.
-  PD07 PD07: DECORATIVE SUSPENDED PENDANT.
-  PD09 PD09: DECORATIVE SUSPENDED PENDANT.
-  PD10 PD10: DECORATIVE SUSPENDED PENDANT.
-  PD11 PD11: DECORATIVE SUSPENDED PENDANT.
-  WL01 WL01: DECORATIVE WALL LIGHT, BRASS.
-  WL02 WL02: DECORATIVE WALL LIGHT, BLACK.
-  WL03 WL03: DECORATIVE WALL LIGHT.
-  WL04 WL04: DECORATIVE WALL LIGHT.
-  WL05 WL05: DECORATIVE WALL LIGHT.
-  WL06 WL06: DECORATIVE WALL LIGHT.
-  WL10 WL10: DECORATIVE WALL LIGHT.
-  WL11 WL11: DECORATIVE WALL LIGHT.
-  WL12 WL12: DECORATIVE WALL LIGHT.

LEGEND

-  RD01: 90 DIA RECESSED DOWNLIGHT, WHITE.
-  RD02: 75 DIA RECESSED DOWNLIGHT, WHITE.
-  RD03: RECTANGULAR TWIN HEAD ADJUSTABLE RECESSED DOWNLIGHT, WHITE.
-  RD04: 190 DIA RECESSED DOWNLIGHT, WHITE.
-  RD11: 150 DIA RECESSED IP54 DOWNLIGHT, WHITE
-  GL01: GARDEN SPIKE LIGHT, BLACK.
-  BL01: TREE WRAP BUD LIGHT.
-  G1: GAMING ROOM CEILING FEATURE LED STRIP LIGHT.
-  R1: GAMING ROOM CEILING FEATURE LED STRIP LIGHT.
-  FE: EXISTING CEILING FAN AND CONTROLS TO BE RETAINED.
-  F02: REPLACE THE EXISTING CEILING FAN AND CONTROLS.
-  FS01: REPLACE THE EXISTING FESTOON LIGHTS FIXED TO STAINLESS STEEL WIRE SUPPORT.
-  FDE  FDE: EXISTING FLOOD LIGHT TO BE RETAINED.
-  SL01: SURFACE CAN DOWNLIGHT.
-  SL02: SURFACE CAN DOWNLIGHT.
-  SL03: SURFACE CAN DOWNLIGHT.
-  SL04: SURFACE CAN DOWNLIGHT.
-  SLE: EXISTING SURFACE MOUNTED LIGHT TO BE RETAINED AND RESUPPLIED.
-  S1: WARM WHITE STRAIGHT LED STRIP LIGHT MOUNTED BEHIND THE FOUR SIDES OF THE TV.
-  S2: WARM WHITE STRAIGHT LED STRIP LIGHT MOUNTED WITHIN THE BAR FRONT.
-  S3: WARM WHITE FLEXIBLE LED STRIP LIGHT MOUNTED WITHIN THE REAR BAR JOINERY.
-  S4: WARM WHITE STRAIGHT LED STRIP LIGHT MOUNTED ON THE SUSPENDED BAR FEATURE BULKHEAD.
-  S5: THREE RUNS OF WARM WHITE STRAIGHT LED STRIP LIGHT MOUNTED UNDER THE BAR COUNTER BULKHEAD.
-  S6: WARM WHITE FLEXIBLE LED STRIP LIGHT MOUNTED WITHIN THE REAR BAR JOINERY
-  S7: WARM WHITE STRAIGHT LED STRIP LIGHT MOUNTED BEHIND THE FOUR SIDES OF THE MIRROR.
-  S8: WARM WHITE STRAIGHT LED STRIP LIGHT RECESSED INTO THE CEILING.
-  S9: WARM WHITE STRAIGHT LED STRIP LIGHT MOUNTED WITHIN THE GAMING ROOM CURTAIN PELMET.
-  S10: WARM WHITE STRAIGHT LED STRIP LIGHT MOUNTED WITHIN THE GAMING ENTRY PORTAL.

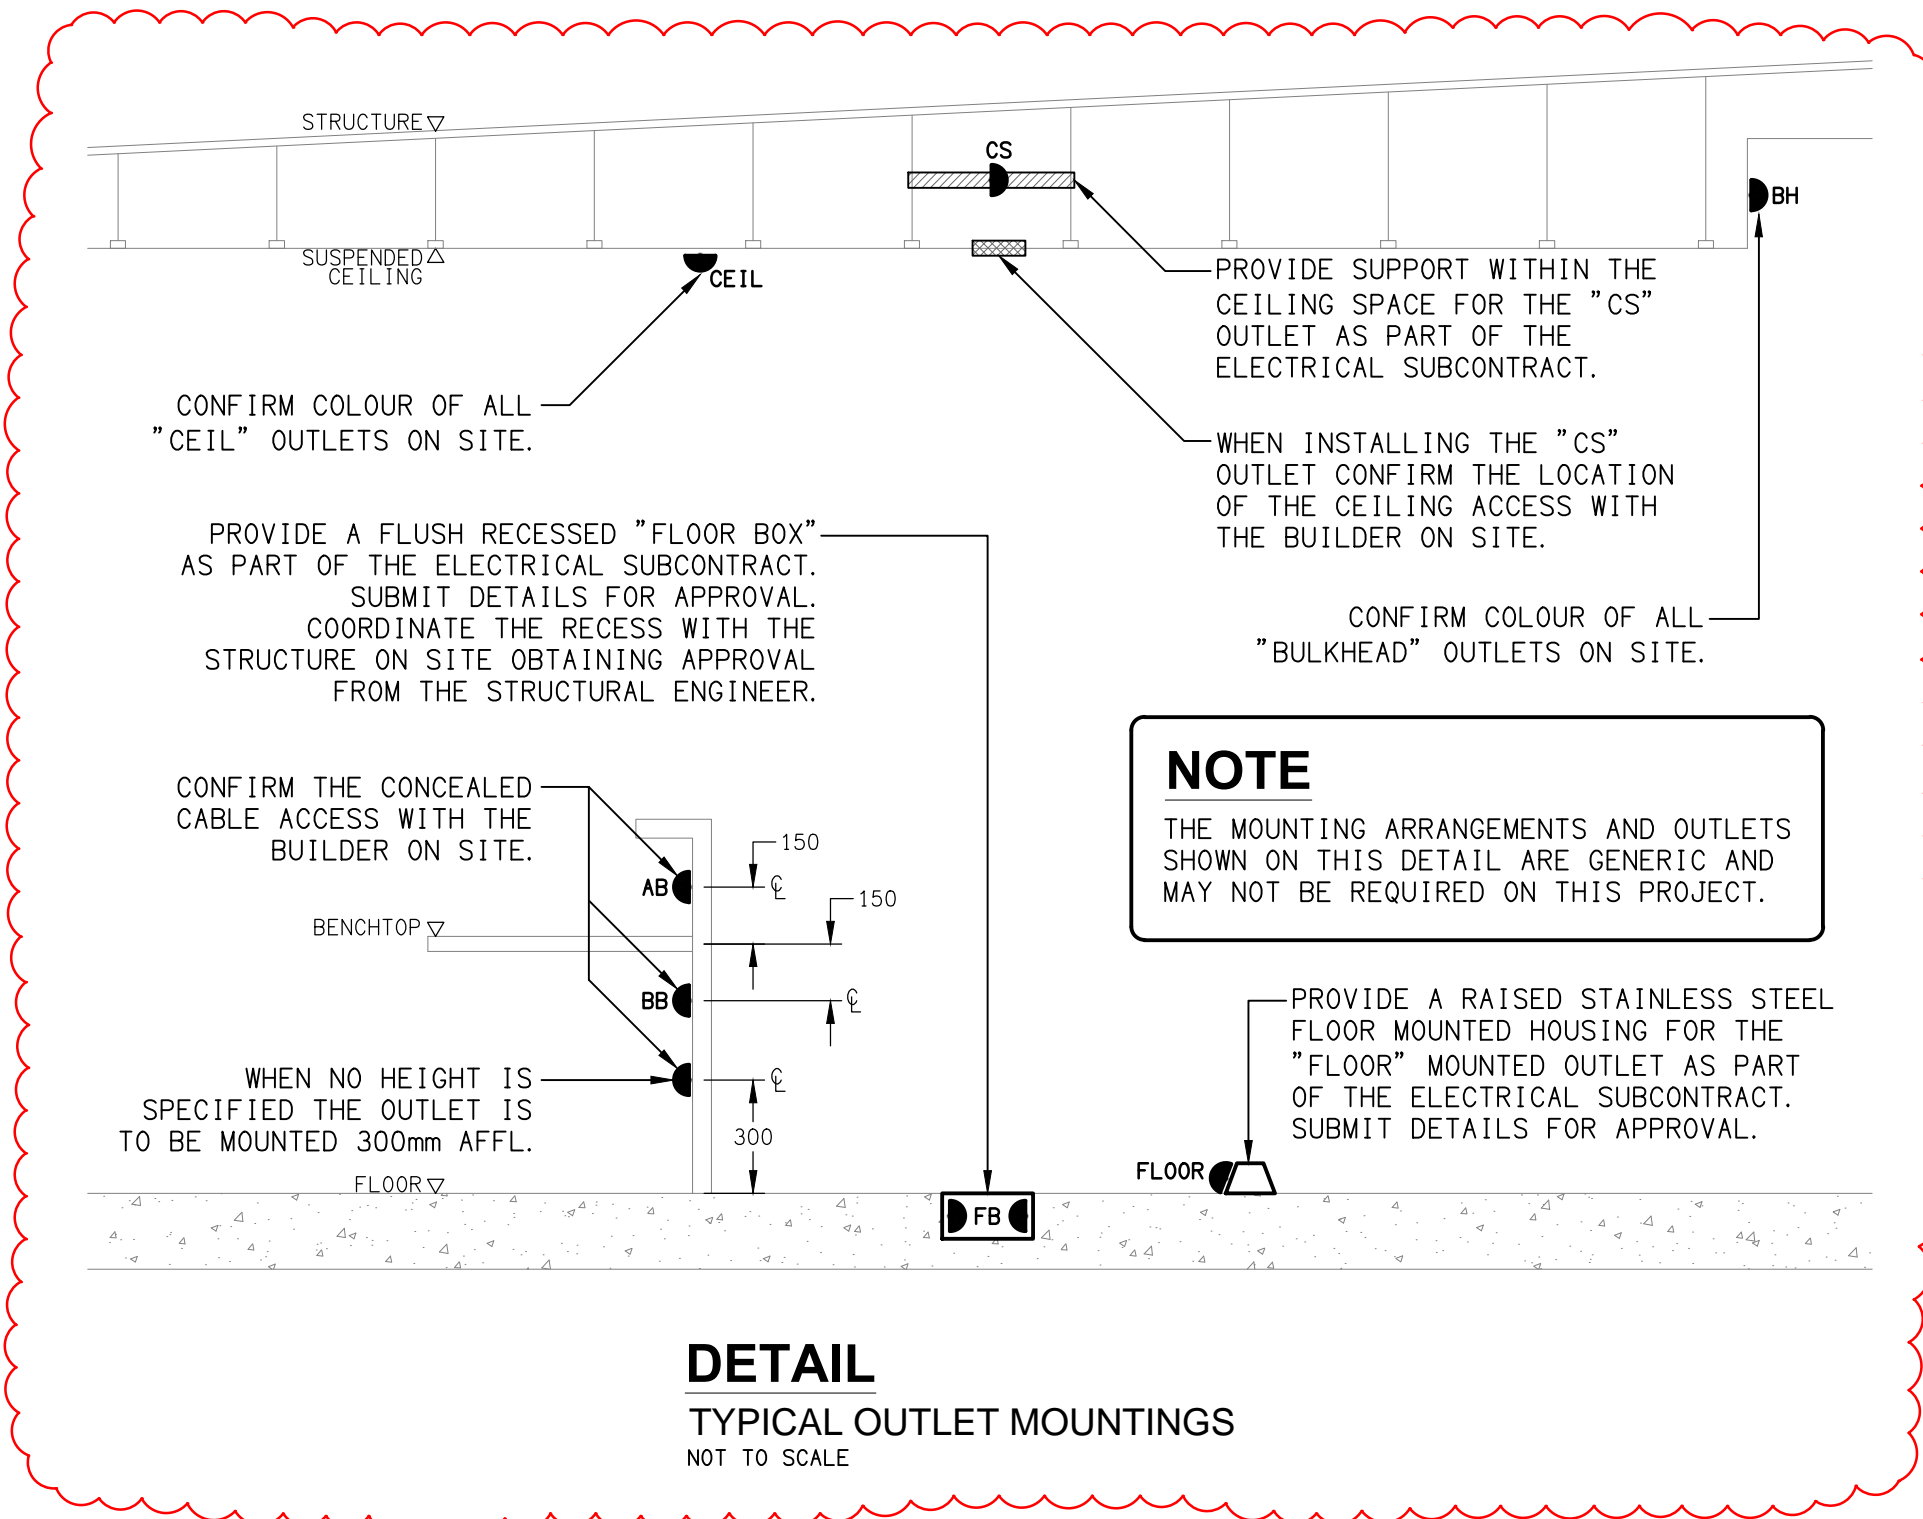

NOTES

1. EXTENT OF WORKS

THE ELECTRICAL SERVICES SUB-CONTRACT INCLUDES BUT IS NOT LIMITED TO THE FOLLOWING:

- SUPPLY AND INSTALLATION OF ALL COMPONENTS FORMING PART OF THE ELECTRICAL SERVICES.
- INSPECTIONS.
- TESTING AND COMMISSIONING.
- MAINTENANCE.
- CABLING, CABLE SUPPORT SYSTEMS AND ACCESS.
- POWER DISTRIBUTION.
- LIGHTING.
- MODIFICATION, RELOCATION AND EXTENSION AS NECESSARY OF ALL EXISTING SERVICES THAT ARE IMPACTED BY THE WORKS OR REQUIRED TO BE EXTENDED BY THE WORKS.
- REMOVAL OF ALL EXISTING SERVICES MADE REDUNDANT BY THE WORKS.
- DOCUMENTS.
- ANY TEMPORARY WORKS REQUIRED TO KEEP THE HOTEL OPERATING DURING THE CONSTRUCTION PROCESS AND ACCOMMODATE STAGING OF THE WORKS TO REFLECT THE EXECUTION OF THE MAIN CONTRACT WORKS.
- ALL MINOR COMPONENTS AND INCIDENTAL WORKS NOT SPECIFICALLY REFERRED TO, HOWEVER NECESSARY TO COMPLETE THE ELECTRICAL SERVICES INSTALLATION SUCH THAT IT IS HANDED OVER COMPLETE, OPERATIONAL AND FIT FOR THE INTENDED USE.

PRIOR TO COMMENCING WORK CONSULT SITE MANAGEMENT FOR ANY HAZARDOUS MATERIAL AND OR ASBESTOS REGISTERS AS WELL AS UNDERTAKE A THOROUGH INSPECTION OF THE SITE TO IDENTIFY ANY POTENTIAL HAZARDOUS MATERIALS, ASBESTOS AND HEALTH OR SAFETY RISKS. ADVISE THE CONTRACTOR OF ANY POTENTIAL HAZARDOUS MATERIALS, ASBESTOS AND HEALTH OR SAFETY RISKS IF IDENTIFIED AND DO NOT COMMENCE WORK UNTIL AN APPROPRIATE MANAGEMENT PLAN HAS BEEN DEVELOPED AND AGREED TO BY ALL PARTIES.

SUPPLY ALL LABOUR, MATERIALS, EQUIPMENT, AND ALL OTHER ITEMS, WHETHER MENTIONED IN DETAIL OR NOT, REQUIRED FOR THE SATISFACTORY COMPLETION OF THE ELECTRICAL SERVICES INSTALLATION, LEAVING IN FULL WORKING ORDER TO THE SATISFACTION OF THE PROJECT MANAGER.

ACCEPT FULL RESPONSIBILITY FOR LIASING, ARRANGING AND CO-ORDINATION OF ALL WORKS THAT HAVE AN EFFECT ON OR WILL BE AFFECTED BY THE ELECTRICAL SERVICES.

REFER TO THE EQUIPMENT SCHEDULE FOR ADDITIONAL REQUIREMENTS.

2. WORKMANSHIP

ENSURE THAT THE ELECTRICAL WORK IS PERFORMED BY THE HOLDER OF A CURRENT ELECTRICAL SUB CONTRACTOR LICENSE AND THE SERVICES COVERED BY THE ACMA IS PERFORMED BY THE HOLDER OF THE APPROPRIATE CURRENT ACMA LICENSE. ENSURE THE INSTALLATION AND ALL COMPONENTS, FIXTURES, FITTINGS, OUTLETS AND CABLES ARE SUPPLIED AND INSTALLED TO A HIGH STANDARD THROUGHOUT, AND INSTALLED IN A NEAT AND TRADESMAN LIKE MANNER, TO THE CURRENT INDUSTRY STANDARDS. ENSURE ALL MATERIALS AND COMPONENTS OF A SIMILAR TYPE ARE OF THE SAME MANUFACTURER AND INSTALLED IN A UNIFORM MANNER.

IT IS THE ELECTRICAL SUB CONTRACTOR'S RESPONSIBILITY TO ENSURE THAT THE INSTALLATION IS FIT FOR PURPOSE AND IS PROVIDED AS A COMPLETE WORKING INSTALLATION. IT IS THE ELECTRICAL SUB CONTRACTOR'S RESPONSIBILITY TO PROVIDE ALL COMPONENTS, FITTINGS, FIXTURES, SYSTEMS, PROGRAMMING ETC IRRESPECTIVE OF THE LEVEL DETAILED IN THE DOCUMENTS SUCH THAT THE INSTALLATION IS PROVIDED AS A COMPLETE WORKING INSTALLATION.

CONCEAL ALL WIRING AND CONDUITS. EXPOSED CABLING OR CONDUITS ARE GENERALLY NOT ACCEPTABLE. IT IS NOTED THAT CHASING AND REINSTATEMENT WILL BE REQUIRED. ENSURE ALL COMPONENTS, EQUIPMENT AND MATERIALS SUPPLIED ARE NEW, UNUSED, DESIGNED AND SELECTED TO ENSURE SATISFACTORY OPERATION UNDER VARYING ATMOSPHERIC, CLIMATIC, HUMID TROPICAL CONDITIONS WITHOUT DISTORTION AND DETERIORATION IN ANY PART AFFECTING EFFICIENCY AND RELIABILITY OF THE SYSTEMS. DESIGN AND SELECT ALL EQUIPMENT TO PROVIDE THE NECESSARY SAFETY TO HUMAN LIFE AND PROPERTY DURING OPERATION AND MAINTENANCE WITH PARTICULAR ATTENTION GIVEN TO ELECTRICAL SAFETY AND SEGREGATION PRECAUTIONS.

CHECK THE FINISHED PAINTWORK AROUND THE AREA OF EACH INSTALLATION AND TOUCH UP ALL DAMAGED PARTS AND FINISHES AFTER THE INSTALLATION OF THE ELECTRICAL SERVICES.

ALL WORKS ARE TO BE CARRIED OUT IN ACCORDANCE WITH THE BUILDER'S PROGRAM. ENSURE ALL FINAL LOCATIONS OF OUTLETS AND FITTINGS ARE CO-ORDINATED ONSITE WITH THE ARCHITECT AND ALL OTHER SERVICES, TO THE APPROVAL OF THE PROJECT MANAGER. ALLOW TO CO-ORDINATE THE FINAL LOCATION OF ALL EQUIPMENT, FITTINGS, & OUTLETS, SUCH THAT THEY ARE INSTALLED IN ACCORDANCE WITH THE AS3000 RESTRICTED ZONES, AND ARE NOT COVERED INAPPROPRIATELY.

ENSURE THAT ALL METAL SURFACES ARE SUITABLY PROTECTED AGAINST CORROSION, AND THAT ALL PLASTIC MATERIALS ARE UV STABILISED.

PROVIDE ALL MATERIALS AS NEW, AND OF THE HIGHEST CLASS AVAILABLE FOR THEIR RESPECTIVE TYPES. ENSURE ALL ASPECTS OF THE WORK ARE OF A HIGH STANDARD THROUGHOUT, AND INSTALLED IN A NEAT AND TRADESMAN LIKE MANNER, TO THE CURRENT INDUSTRY STANDARDS.

MODIFICATION, RELOCATION AND EXTENSION AS NECESSARY OF ALL EXISTING SERVICES THAT ARE IMPACTED BY THE WORKS OR REQUIRED TO BE EXTENDED BY THE WORKS.

PROVIDE ALL TEMPORARY WORKS REQUIRED TO KEEP THE VENUE AND ALL CONSTRUCTION STAGES OPERATING INCLUDING STAGED COMMISSIONING DURING THE CONSTRUCTION PROCESS.

ALL MINOR COMPONENTS AND INCIDENTAL WORKS NOT SPECIFICALLY REFERRED TO, HOWEVER NECESSARY TO COMPLETE THE ELECTRICAL SERVICES INSTALLATION SUCH THAT IT IS HANDED OVER COMPLETE, OPERATIONAL AND FIT FOR THE INTENDED USE.

CORRUGATED CONDUITS MUST NOT BE USED WITHIN ANY FOOD OR DRINK PREPARATION OR SERVERY AREAS.

CABLE JOINS ARE NOT ACCEPTABLE. ALL CABLING, WIRING, CONDUCTORS AND CONDUITS MUST BE CONCEALED. ALL EXISTING ELECTRICAL SERVICES INCLUDING CABLING AND SWITCHGEAR THAT IS FOUND TO BE REDUNDANT OR MADE REDUNDANT BY THE WORKS MUST BE REMOVED.

IT IS ACCEPTABLE TO USE EXISTING SWITCHGEAR, OUTLETS AND CABLING IF THEY ARE APPROPRIATELY RATED AND THE ELECTRICIAN ACCEPTS RESPONSIBILITY OVER THE SWITCHGEAR / OUTLETS / CABLE AND PROVIDES A WARRANTY OVER IT AS IF IT WAS INSTALLED NEW BY THE ELECTRICIAN.

3. STANDARDS

IRRESPECTIVE OF INFORMATION CONTAINED IN THE ELECTRICAL SERVICES DOCUMENTS OR IN INSTRUCTIONS, IT IS THE ELECTRICAL SUB CONTRACTORS RESPONSIBILITY TO ENSURE ALL ELECTRICAL SERVICES WORKS ARE INSTALLED IN ACCORDANCE WITH THE REQUIREMENTS OF THE FOLLOWING. REFER ANY DISCREPANCIES BETWEEN THE REQUIREMENTS OF THE FOLLOWING AND/OR THE ELECTRICAL SERVICES DOCUMENTS AND INSTRUCTIONS TO THE ARCHITECT FOR CLARIFICATION PRIOR TO THE PLACING OF ORDERS, FABRICATION OR INSTALLATION OF THE ITEMS/METHODS IN DISCREPANCY.

- NCC BUILDING CODE OF AUSTRALIA.
- ELECTRICITY ACT.
- ELECTRICAL SAFETY ACT.
- AS/NZS3000.
- AS3008.
- WORKPLACE HEALTH AND SAFETY ACT.
- TELECOMMUNICATIONS ACT.
- ACMA REQUIREMENTS.

NOTES

4. AUTHORITIES

ENSURE ALL OF THE ELECTRICAL SERVICES COMPLY WITH THE REQUIREMENTS OF ALL REGULATORY AUTHORITIES HAVING JURISDICTION OVER THE SITE INCLUDING BUT NOT LIMITED TO THE FOLLOWING:

- ACMA.
- LOCAL COUNCIL.
- LOCAL SUPPLY AUTHORITY.
- STATE GOVERNMENT DEPARTMENT OF ENVIRONMENT AND HERITAGE.
- QLD GOVERNMENT, DIVISION OF WORKPLACE, HEALTH AND SAFETY.
- QLD FIRE AND EMERGENCY SERVICES.

5. DOCUMENTATION

WITHIN TWO WEEKS OF PRACTICAL COMPLETION PROVIDE THE FOLLOWING DOCUMENTATION.

AS CONSTRUCTED DRAWINGS INCLUDING:

- ELECTRICIANS NAME AND CONTACT DETAILS.
- PROJECT NAME, ADDRESS AND DATE OF PRACTICAL COMPLETION.
- FITTING POSITIONS AND TYPES CROSS REFERENCED TO A FITTING / EQUIPMENT SCHEDULE.
- OUTLET, SWITCH, AND CONNECTION POSITIONS CROSS REFERENCED TO A FITTING / EQUIPMENT SCHEDULE.
- REMOTE DRIVER LOCATIONS.
- CIRCUITS CROSS REFERENCED TO A DISTRIBUTION BOARD SCHEDULE.
- LIGHTING CONTROL CHANNELS CROSS REFERENCED TO A LIGHTING CONTROL SCHEDULE.
- POWER SCHEMATIC.
- SWITCHBOARD SHOP DRAWINGS.
- CABLE ACCESS ROUTES.

A FITTING / EQUIPMENT SCHEDULE INCLUDING.

- FITTING DETAILS INCLUDING THE MANUFACTURERS CATALOGUE NUMBERS WITH THE TYPES CROSS REFERENCED TO THE AS CONSTRUCTED DRAWINGS.
- OUTLETS AND SWITCHES INCLUDING THE MANUFACTURERS CATALOGUE NUMBERS WITH THE TYPES CROSS REFERENCED TO THE AS CONSTRUCTED DRAWINGS.

DISTRIBUTION BOARD SCHEDULES CROSS REFERENCED TO THE AS CONSTRUCTED DRAWINGS.

LIGHTING CONTROL SCHEDULE CROSS REFERENCED TO THE AS CONSTRUCTED DRAWINGS.

PHOTOS OF EACH SWITCHBOARD INCLUDING:

- CLOSED POSITION SUCH THAT THE SWITCHBOARD DESIGNATION AND CLEARANCE IS VISIBLE.
- THE SUBMAIN LABEL.
- DOOR/S OPEN ESCUTCHEON/S CLOSED SUCH THAT THE SPARE CAPACITY AND LABELLING IS VISIBLE.
- DOOR/S OPEN ESCUTCHEON/S REMOVED SUCH THAT THE SWITCHGEAR AND INTERNAL CABLING IS VISIBLE.

6. CABLES

UNLESS OTHERWISE SPECIFIED, INSTALL AND TERMINATE CABLES IN ACCORDANCE WITH THE MANUFACTURERS' RECOMMENDATIONS. DETERMINE THE FINAL ROUTES TO SUIT THE BUILDING STRUCTURE AND SITE CONDITIONS. UNLESS NOTED OTHERWISE, PROVIDE ALL 240 VOLT POWER AND LIGHTING WIRING AS 2.5mm² TWIN & EARTH STRANDED COPPER CONDUCTORS, PVC INSULATED 0.6/1kV V75 GRADE TO AS3174, PROTECTED BY A 20 AMP CIRCUIT BREAKER. ALL CONDUIT AND FITTINGS TO BE RIGID UPVC TO AS2053, UNLESS NOTED OTHERWISE.

7. POWER DISTRIBUTION

REMOVE ALL EXISTING CIRCUITS THAT BECOME REDUNDANT BY THE WORKS. ANY REMAINING CIRCUITS IN DB-2 ARE TO BE RELOCATED INTO DB-1. DB-2 IS TO REMAIN EMPTY / SPARE FOR USE BY THE GAMING ELECTRICIAN.

THE EXISTING CIRCUITS THAT REMAIN WITHIN THE AREA OF WORKS ARE TO BE RECONNECTED TO THE SWITCHBOARDS WITH NEW SWITCHGEAR AND CONTROLS. ANY INTERRUPTION TO THE POWER SUPPLY TO ANY SERVICES OUTSIDE OF THE AREA OF WORKS MUST BE RESTRICTED TO OUTSIDE OF THE HOTELS OPERATING HOURS AND MUST BE ADVISED TO THE OPERATOR IN WRITING AT LEAST ONE WEEK PRIOR.

ALL CIRCUIT BREAKERS AND CIRCUIT SCHEDULES MUST BE LABELLED / CONTAIN THE SUBMAIN / CIRCUIT USE AND LOCATION SUCH THAT THE CONNECTION / OUTLET CAN BE SIMPLY IDENTIFIED.

OUTLETS ARE TO BE PROVIDED WITH A NEAT HAND WRITTEN CIRCUIT DESIGNATION BY INDELEIBLE INK ON THE FACEPLATE SUCH THAT IT IS NOT VISIBLE WHEN THE COVER IS CONCEALED.

REFER TO THE DISTRIBUTION BOARD SCHEDULES FOR ADDITIONAL REQUIREMENTS AND CIRCUIT DETAILS.

ENSURE ALL THREE PHASE CIRCUITS ARE PROVIDED WITH CORRECT PHASE ROTATION.

ENSURE ALL OUTLETS AND ISOLATORS ARE POSITIONED SUCH THAT THEY ARE NOT COVERED BY THE EQUIPMENT. THE FINAL POSITION OF ALL OUTLETS AND ISOLATORS ARE TO BE CONFIRMED ON SITE BY THE TENANTS REPRESENTATIVE.

NOTES

8. GAMING

THE GAMING ELECTRICIAN WILL BE ENGAGED DIRECTLY BY ENDEAVOUR GROUP TO UNDERTAKE THE FOLLOWING:

- COMMUNICATIONS CABLING.
- CIRCUITS FROM DB-2 AS NECESSARY TO:
 - GAMING MACHINES.
 - GAMING MODEMS.
 - GAMING MACHINE SIGNAGE.
 - GAMING ROOM CRTS.
- GAMING ROOM CABLE ACCESS EXCLUDING FLOOR CHASES AND REINSTATEMENT OF THE FLOOR CHASES.
- TAB OUTLETS.

ALL OTHER REMAINING ELECTRICAL SERVICES WITHIN THE GAMING ROOM ARE TO BE PROVIDED AS PART OF THE BUILDING WORKS ELECTRICAL SUB CONTRACT.

9. LIGHTING

ALL FRONT OF HOUSE LIGHTING IS TO BE 2,700K OR 3,000K AND THE BACK OF HOUSE LIGHTING IS TO BE 4,000K.

UNLESS A FITTING HAS BEEN SPECIFIED IN THE EQUIPMENT SCHEDULE THAT CONTAINS A MAIN VOLTAGE LAMP, ALL LIGHT FITTINGS MUST BE PROVIDED AS SOLID-STATE LED WITH A FIVE-YEAR MANUFACTURERS REPLACEMENT WARRANTY AND A MINIMUM TWO YEAR MANUFACTURERS REPLACEMENT AND LABOUR WARRANTY.

ALL FRONT OF HOUSE LIGHTS THAT DO NOT CONTAIN A MAIN VOLTAGE LAMP ARE TO BE DALI DIMMABLE.

REMOTE DRIVERS ARE TO BE USED IF POSSIBLE AND LOCATED IN A CONCEALED ACCESSIBLE POSITION. IF THE DRIVER CAN NOT BE REACHED FROM THE FITTING ITS POSITION MUST BE NOTED ON THE AS CONSTRUCTED DOCUMENTS.

ALL FRONT OF HOUSE LIGHTS THAT CONTAIN MAIN VOLTAGE LAMPS ARE TO BE PROVIDED WITH THE LOWEST OUTPUT PRACTICAL TO ACHIEVE THE REQUIRED ILLUMINATION / EFFECT AND BE TRAILING EDGE PHASE DIMMABLE.

ALL ILLUMINATED SIGNAGE, GAMING BASE FOOTREST LEDS, CARPARK LIGHTS, AND EXTERNAL SECURITY LIGHTS NOT CONSIDERED FRONT OF HOUSE ARE TO BE SWITCHED.

ALL LIGHTING CIRCUITS MUST BE PROTECTED BY A 20 AMP RCBO WITH THE AVERAGE NUMBER OF FITTINGS / DRIVERS SUPPLIED FROM A SINGLE CIRCUIT NOT EXCEEDING 25 WITH THE MAXIMUM NOT EXCEEDING 30.

PROVIDE A PHILIPS DYNALITE LIGHTING CONTROL SYSTEM TO CONTROL THE LIGHTING CONFIGURED WITH THE FOLLOWING SCENES:

INTERNAL

- CLEANING – MANUAL OPERATION. 100% LIGHTS ON AND SIGNS OFF.
- DAY – AUTOMATIC OPERATION FROM 10.00 AM TO 3.30 PM.
- AFTERNOON – AUTOMATIC OPERATION FROM 3.30 PM TO DUSK.
- EVENING – AUTOMATIC OPERATION FROM DUSK TO 8.30 PM.
- NIGHT – AUTOMATIC OPERATION FROM 8.30 PM TO CLOSING.
- CLOSED – MANUAL OPERATION. 100% ON FOR 15 MINUTES THEN TO A SECURITY MODE.

EXTERNAL

- DAY – AUTOMATICALLY OFF FROM DAWN TO DUSK.
- NIGHT – AUTOMATICALLY ON FROM DUSK UNTIL 15 MINUTES PAST CLOSING.
- CLOSED – MANUAL OPERATION. NIGHT MODE FOR 15 MINUTES THEN TO A SECURITY MODE.

SET THE ILLUMINATION LEVELS IN CONSULTATION WITH THE VENUE MANAGER AND OBTAIN WRITTEN APPROVAL FROM THE VENUE MANAGER OF THEIR ACCEPTANCE OF THE ILLUMINATION SCENE LEVELS FOR EACH STAGED HANDOVER AND SUBMIT A COPY OF THE APPROVAL TO THE ARCHITECT.

PROVIDE PHILIPS DYNALITE PROGRAMMABLE SWITCH PANELS PE SENSORS AND TIME CLOCKS AS NECESSARY. EACH FUNCTIONAL AREA IS TO BE PROVIDED WITH A SWITCHPANEL IN A NON-CUSTOMER ACCESSIBLE POSITION WITH THE ABILITY TO MANUALLY INSTIGATE THE ABOVE SCENES.

DIN RAIL MOUNT THE PHILIPS DYNALITE CONTROL EQUIPMENT WITHIN THE ASSOCIATED SWITCHBOARD.

ALL OF THE LIGHT FITTINGS, LAMPS AND ACCESSORIES ARE TO BE PROVIDED AS PART OF THIS CONTRACT. THE LIGHTING COMPONENT OF THIS CONTRACT INCLUDES, BUT IS NOT LIMITED TO THE FOLLOWING EXTENT OF WORK:

- LIGHTING.
- LIGHT FITTINGS AND ACCESSORIES.
- EMERGENCY AND EXIT LIGHTING.
- EARTHING OF THE LIGHTING INSTALLATION.
- LIGHTING CONTROL.
- PHILIPS DYNALITE LIGHTING CONTROL SYSTEM.
- LIGHTING SUBCIRCUITS.
- TESTING AND COMMISSIONING.
- RECONNECTION OF THE EXISTING LIGHTING THAT REMAINS.
- REMOVAL OF ALL EXISTING REDUNDANT LIGHTING SERVICES INCLUDING THE REDUNDANT LIGHTING CONTROL SYSTEM.

COMMISSION THE LIGHTING CONTROL AT PRACTICAL COMPLETION AND AGAIN THREE TIMES DURING THE DEFECTS AND LIABILITY PERIOD TO THE SATISFACTION OF THE OPERATOR.

NOTES

10. EMERGENCY AND EXIT LIGHTING

PROVIDE A SINGLE POINT EMERGENCY LIGHTING SYSTEM THAT COMPLIES WITH THE LATEST ISSUE OF ALL PARTS AS2293 AND THE RELEVANT PARTS OF THE NCC BCA. INSTALL EMERGENCY LIGHT FITTINGS NOMINATED AS MAINTAINED WITH THE LAMP PERMANENTLY ON SUPPLIED VIA AN UNSWITCHED ACTIVE MAINS SUPPLY WHEN THE MAINS SUPPLY IS AVAILABLE. WHEN THE MAINS SUPPLY IS NOT AVAILABLE, THE LAMP IS TO REMAIN ON SUPPLIED BY THE EMERGENCY PACK. SINGLE LAMP MAINTAINED EMERGENCY LIGHTS ARE NOT SWITCHED WITH THE LOCAL GENERAL AREA LIGHTING. (THE LAMP IS ALWAYS ON.)

INSTALL EMERGENCY LIGHT FITTINGS NOMINATED AS NON-MAINTAINED AS FOLLOWS:

- IF THE FITTING IS NOT BEING SWITCHED, THE LAMP IS TO REMAIN OFF WHEN THE MAINS SUPPLY IS AVAILABLE. WHEN THE MAINS SUPPLY IS NOT AVAILABLE THE LAMP IS TO BE SWITCHED ON SUPPLIED BY THE EMERGENCY PACK. UNSWITCHED SINGLE LAMP NON-MAINTAINED EMERGENCY LIGHTS ARE NOT SWITCHED WITH THE LOCAL GENERAL AREA LIGHTING. (THE LAMP IS ON ONLY WHEN THE MAINS SUPPLY IS NOT AVAILABLE.)
- IF THE FITTING IS BEING SWITCHED, THE LAMP IS TO BE SUPPLIED AND CONTROLLED WITH THE LOCAL GENERAL AREA LIGHTING WHEN THE MAINS SUPPLY IS AVAILABLE. WHEN THE MAINS SUPPLY IS NOT AVAILABLE THE LAMP IS TO BE SWITCHED ON, SUPPLIED BY THE EMERGENCY PACK. (THE LAMP IS ON WHEN TURNED ON WITH THE LOCAL GENERAL LIGHTING OR THE MAIN SUPPLY IS NOT AVAILABLE.)

INSTALL EMERGENCY LIGHTS SUCH THAT THE STATUS INDICATOR L.E.D. IS CLEARLY VISIBLE AND THE TEST BUTTONS ARE READILY ACCESSIBLE. LABEL EACH CIRCUIT BREAKER WHICH CONTROLS THE UNSWITCHED ACTIVE TO EXIT LIGHTS WITH A LABEL FIXED ADJACENT; ENGRAVED PLASTIC LAMINATE, GREEN BACKGROUND WITH WHITE CHARACTERS: –

WARNING
INTERRUPTING SUPPLY WILL DISCHARGE
EMERGENCY LIGHTING BATTERIES

PROVIDE WRITTEN EVIDENCE OF THE INITIAL COMMISSIONING AND TESTING AND TESTING FOR THE DURATION OF THE MAINTENANCE PERIOD IN ACCORDANCE WITH AS 2293.2.


THIS EVIDENCE IS TO BE IN THE FORM OF A LOG BOOK SIMILAR TO THE GENERAL LIGHTING SERVICE PTY LTD "EMERGENCY LIGHTING MAINTENANCE LOG BOOK AND MANUAL" WHICH IS TO BE PROVIDED BY THE ELECTRICAL SUB-CONTRACTOR AND HAVE ALL ENTRIES FULLY COMPLETED AND BE PRESENTED FOR INSPECTION AT PRACTICAL COMPLETION. THE LOG BOOK IS TO BE RETAINED BY THE ELECTRICAL SUB-CONTRACTOR FOR THE DURATION OF THE MAINTENANCE PERIOD, AND THE SIX MONTHLY TEST AND MAINTENANCE RESULTS ENTERED. THE LOG BOOK IS TO BE PRESENTED FOR APPROVAL AT FINAL COMPLETION (EXPIRY OF THE MAINTENANCE PERIOD) AND WILL BE FORWARDED TO THE OPERATOR FOR THEIR USE.


PROVIDE MAINTENANCE OF THE EMERGENCY AND EXIT LIGHTING INSTALLATION INCLUDING RECORDS IN ACCORDANCE WITH THE LATEST ISSUE OF ALL PARTS AS2293 AND THE RELEVANT PARTS OF THE NCC BCA. PROVIDE THE EMERGENCY LIGHTING SYSTEM WITH A SUPPLY SENSING AND TESTING FACILITY IN ACCORDANCE WITH AS 2293.1.

11. ABBREVIATIONS


- A – AMP CURRENT RATING
- AB – MOUNT ABOVE BENCH.
- AFFL – ABOVE FINISHED FLOOR LEVEL.
- BB – MOUNT BELOW BENCH.
- BH – MOUNT ON BULKHEAD.
- CEIL – MOUNT ON CEILING.
- CS – MOUNT WITHIN CEILING SPACE.
- C/W – COMPLETE WITH.
- DW – DISHWASHER.
- MCB – MINIATURE CIRCUIT BREAKER.
- MCCB – MOLDED CASE CIRCUIT BREAKER.
- MSB – MAIN SWITCHBOARD.
- MSSB – MECHANICAL SERVICES SWITCHBOARD.
- MW – MICROWAVE.
- N – NEON / LED INDICATOR WHEN ON.
- NTS – NOT TO SCALE.
- RCBO – CIRCUIT BREAKER C/W AN INTEGRAL 30ma RESIDUAL CURRENT DEVICE.
- RCD – CIRCUIT PROTECTED VIA A 30ma RESIDUAL CURRENT DEVICE.
- REF – REFRIGERATOR.
- UNO – UNLESS NOTED OTHERWISE.
- WP – WEATHERPROOF TO IP56 UNO.
- 500 – NUMBER DENOTES MOUNTING HEIGHT AFFL.

<div>ELECTRICAL DESIGN GROUP BRISBANE PTY LTD ACN 092 710 793</div> <div>TRADING AS: ELECTRICAL DESIGN GROUP</div>		<div>THE COPYRIGHT OF THIS DRAWING REMAINS THE PROPERTY OF THE ELECTRICAL DESIGN GROUP.</div> <div>USE FIGURED DIMENSIONS IN PREFERENCE TO SCALE.</div> <div>ALL DIMENSIONS TO BE VERIFIED ONSITE.</div>	<div><div><div></div></div><div>ELECTRICAL DESIGN GROUP</div><div>ELECTRICAL BUILDING SERVICES CONSULTANTS</div><div>BRISBANE GOLD COAST</div></div> <div>P.O.Box 15, Sherwood Q.4075 Phone: (07) 3276 4375 Email: brisbane@edg.net.au Web: www.edg.net.au</div>	<div>PROJECT: COOLUM BEACH HOTEL</div> <div>CORNER BIRTWILL STREET & DAVID LOW WAY, COOLUM BEACH</div>	<div>B TENDER 22/05/2026</div> <div>REV: DESCRIPTION: DATE:</div>
					<div>DRAWING: ELECTRICAL SERVICES NOTES</div> <div>SCALE: NOT TO SCALE AT A1</div> <div><div>PROJECT NO: C3743a</div><div>DRAWING NO: E02</div><div>REVISION: B</div></div>

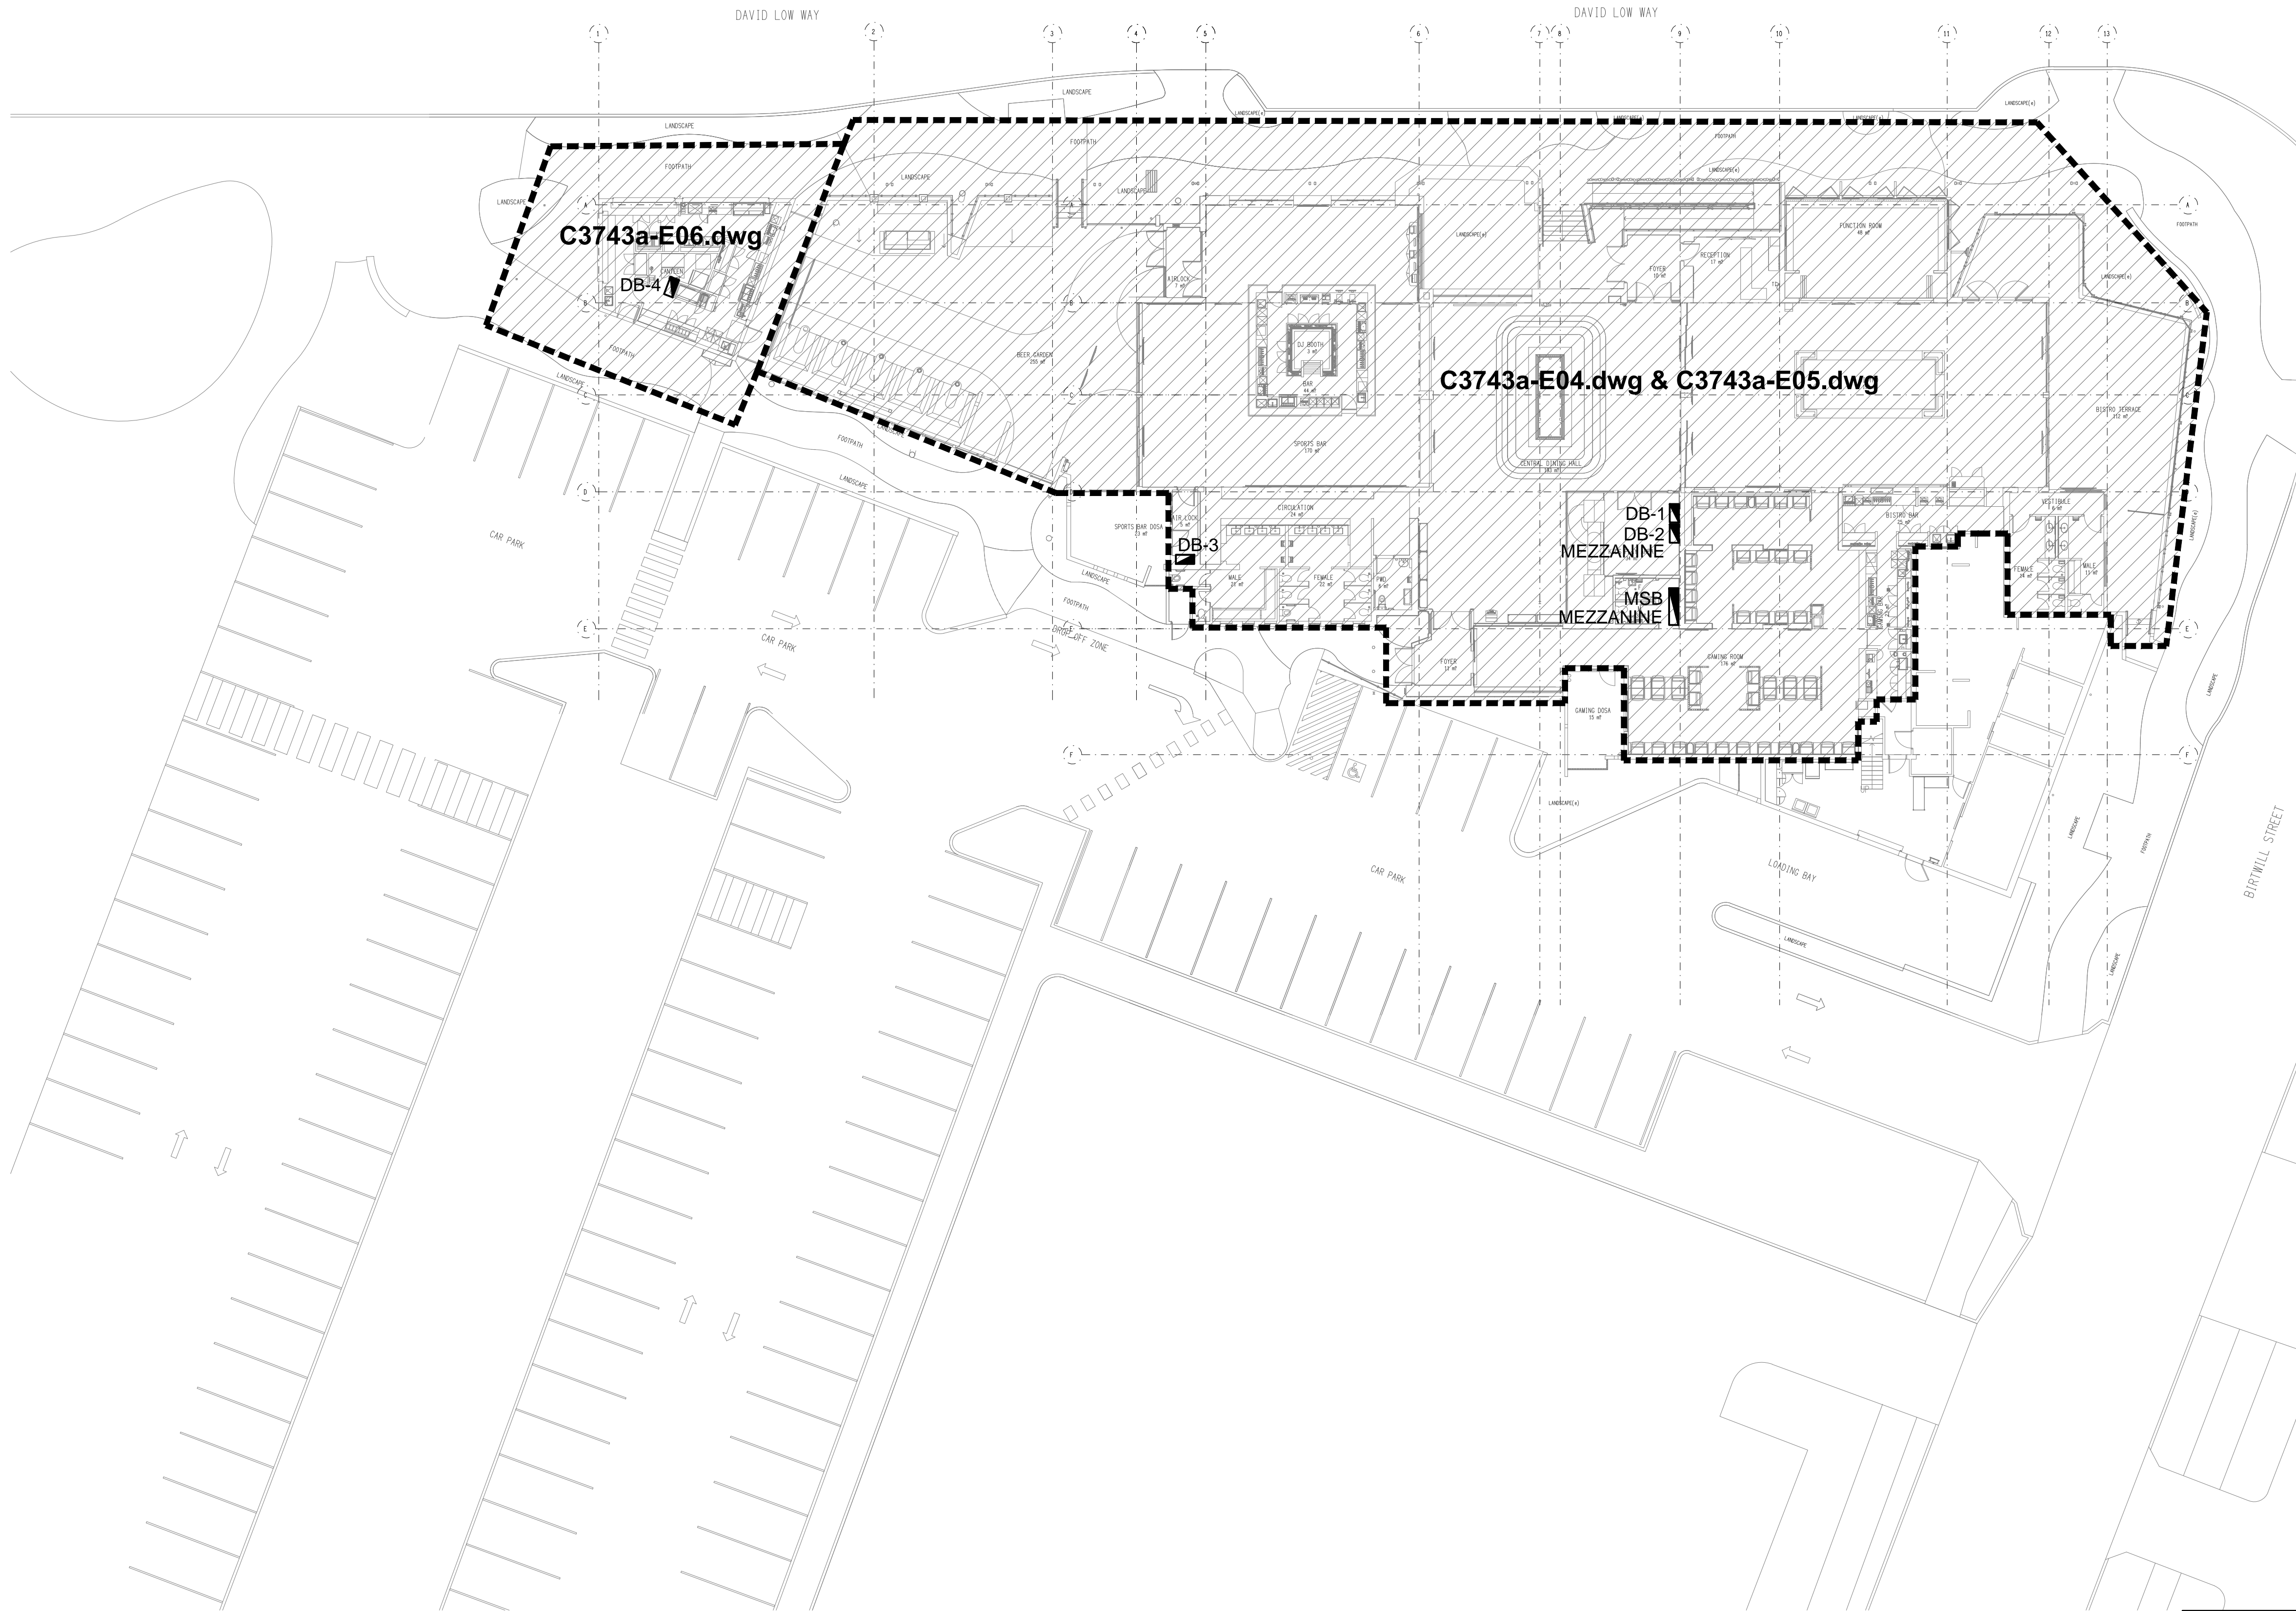

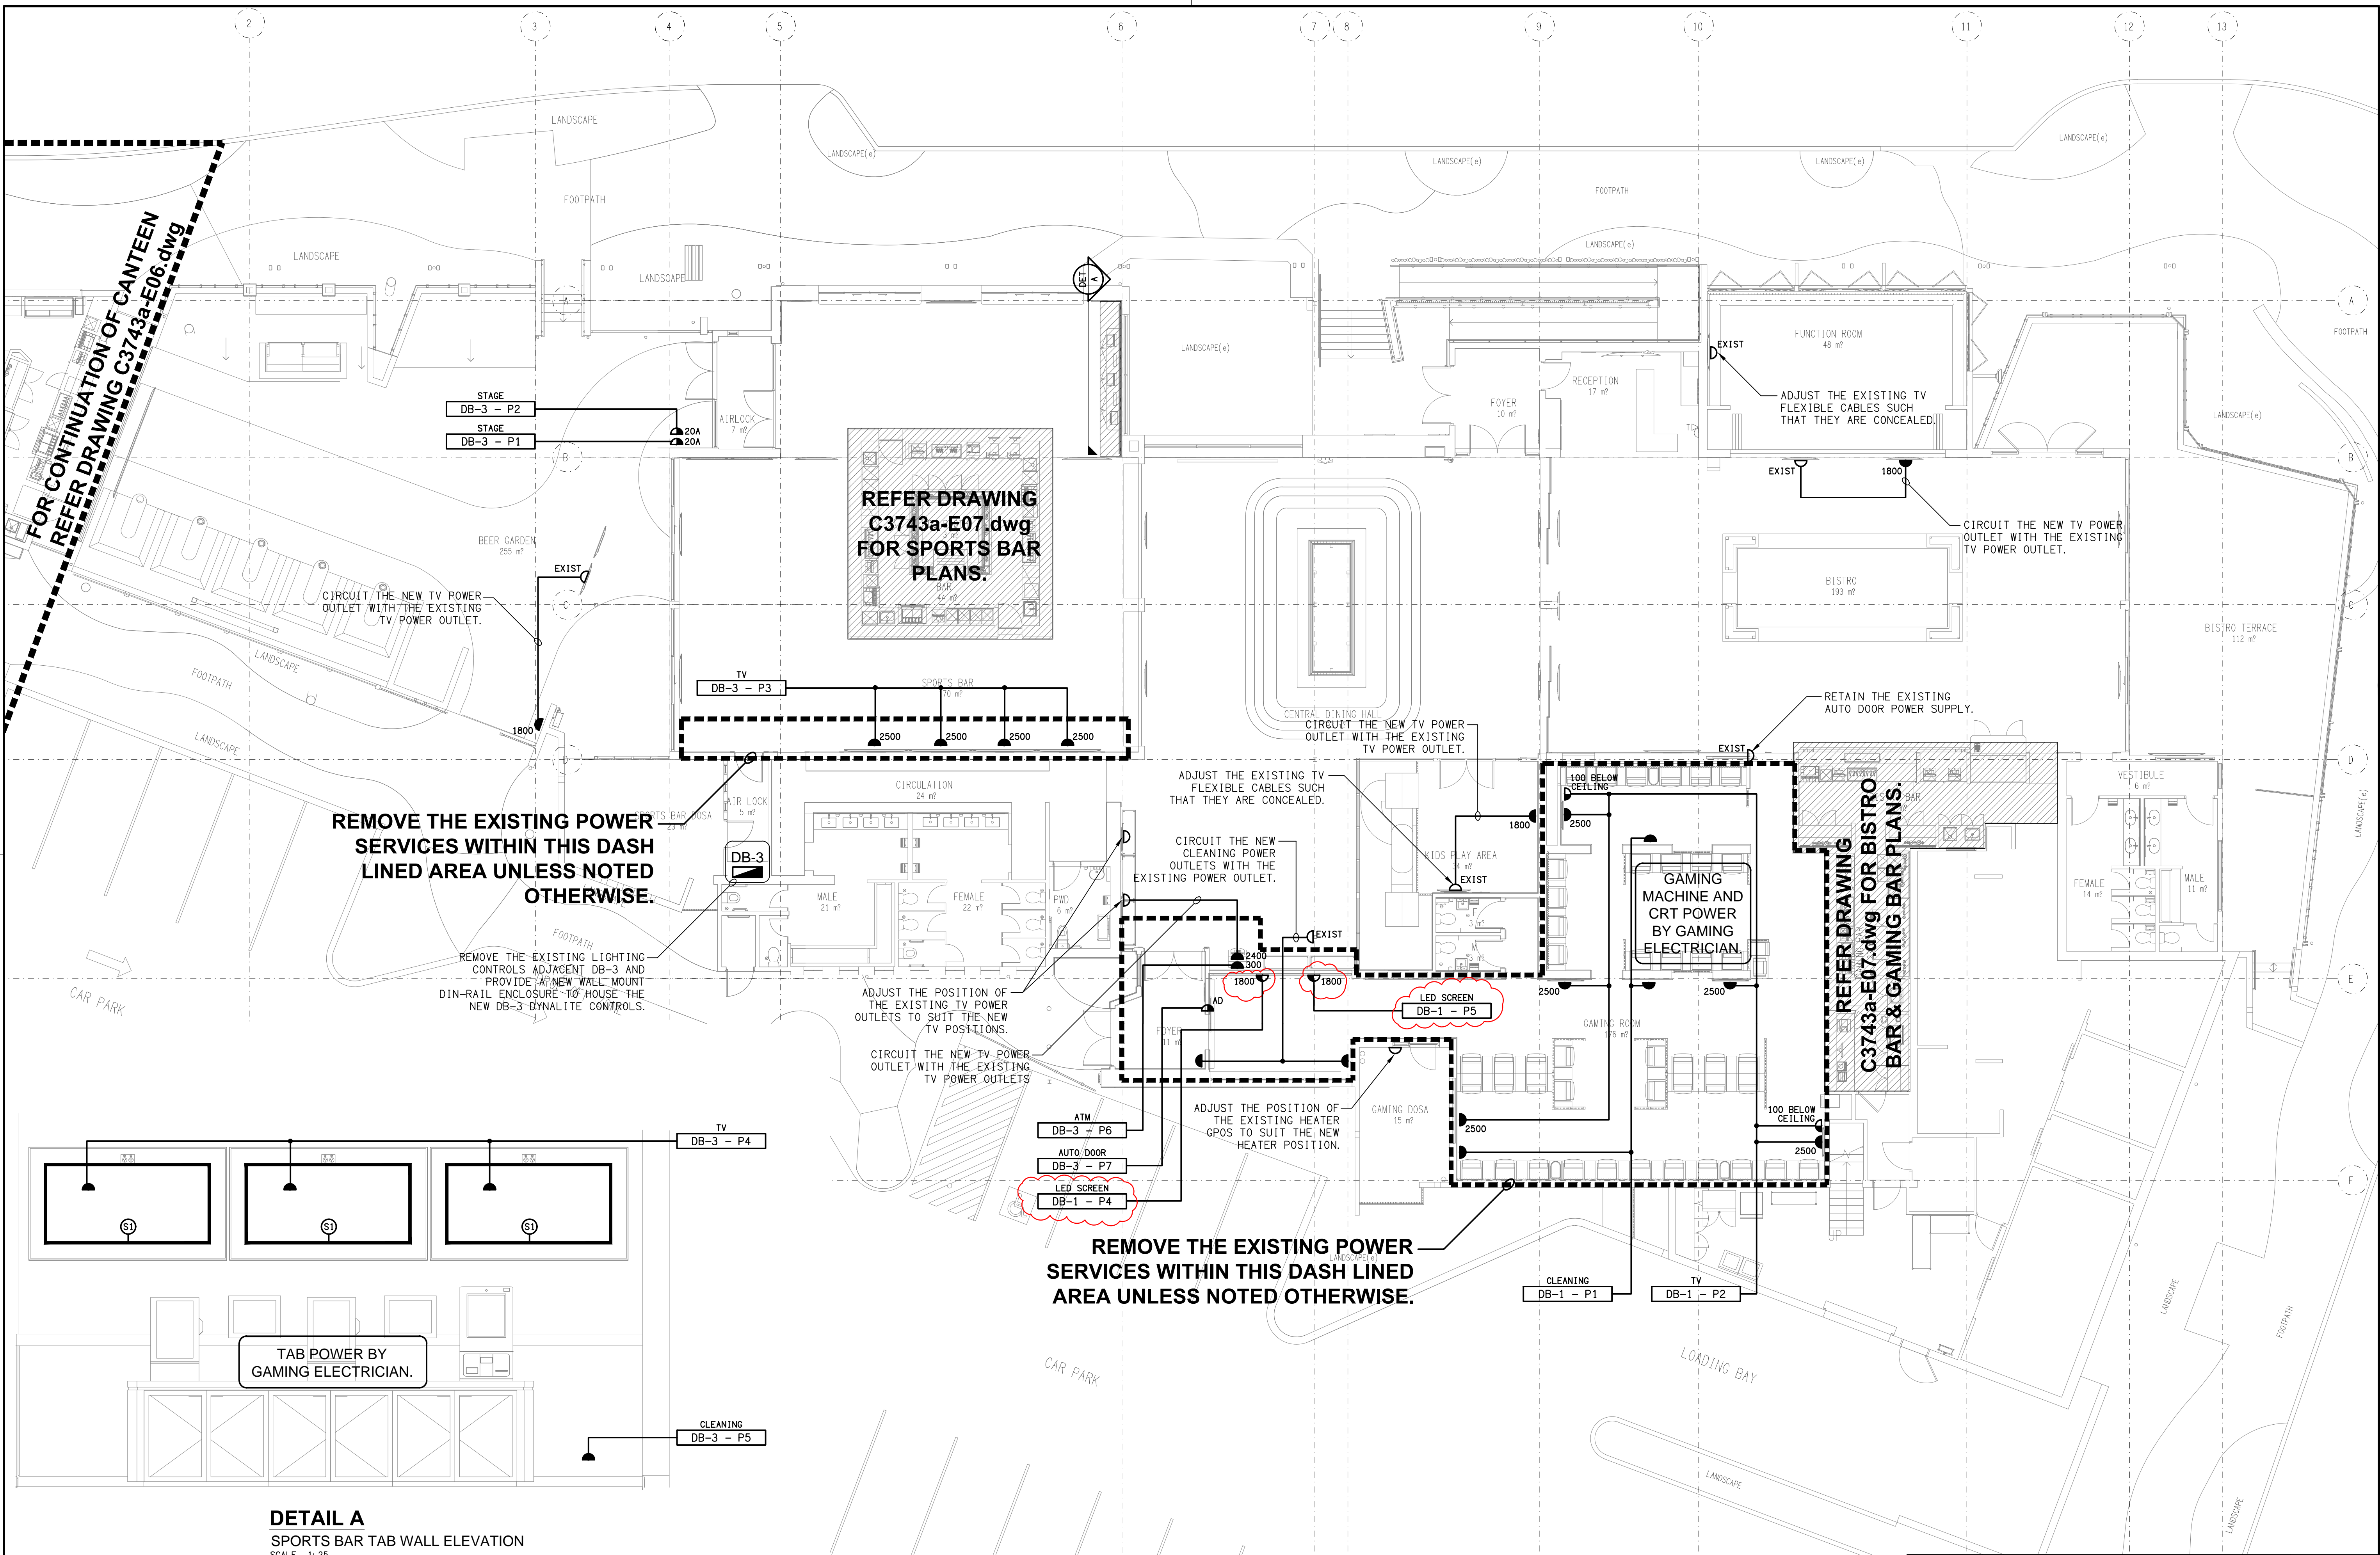


DETAIL A
SPORTS BAR TAB WALL ELEVATION
SCALE: 1:25

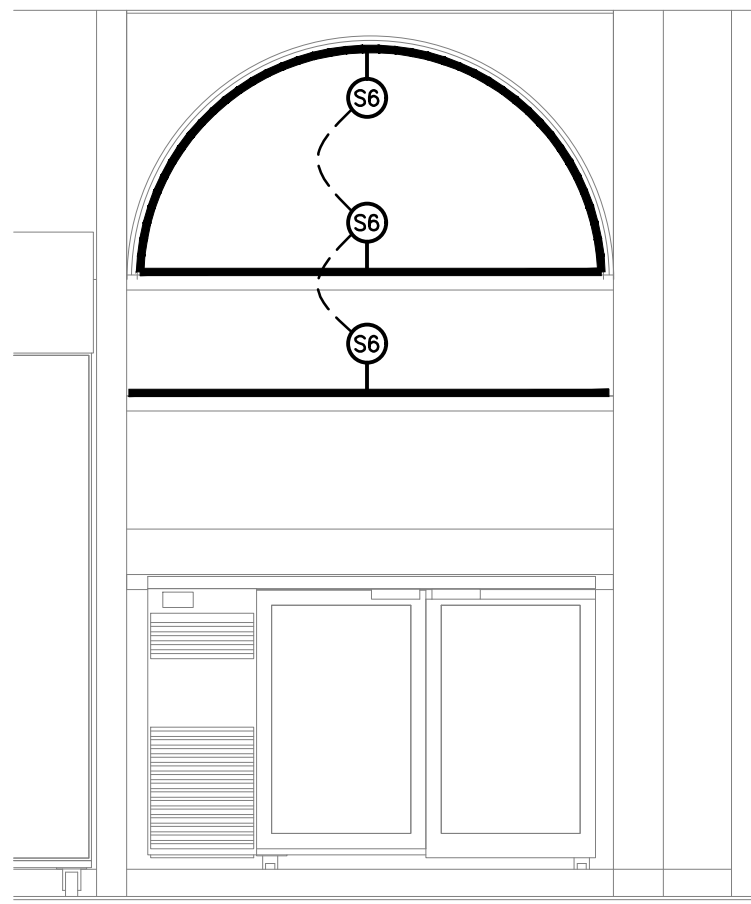


DETAIL A
CANTEEN BAR ELEVATION
SCALE 1: 25

REMOVE ALL OF THE EXISTING
LIGHTING SERVICES AND CONTROLS
WITHIN THIS DASH LINED AREA,
UNLESS NOTED OTHERWISE.

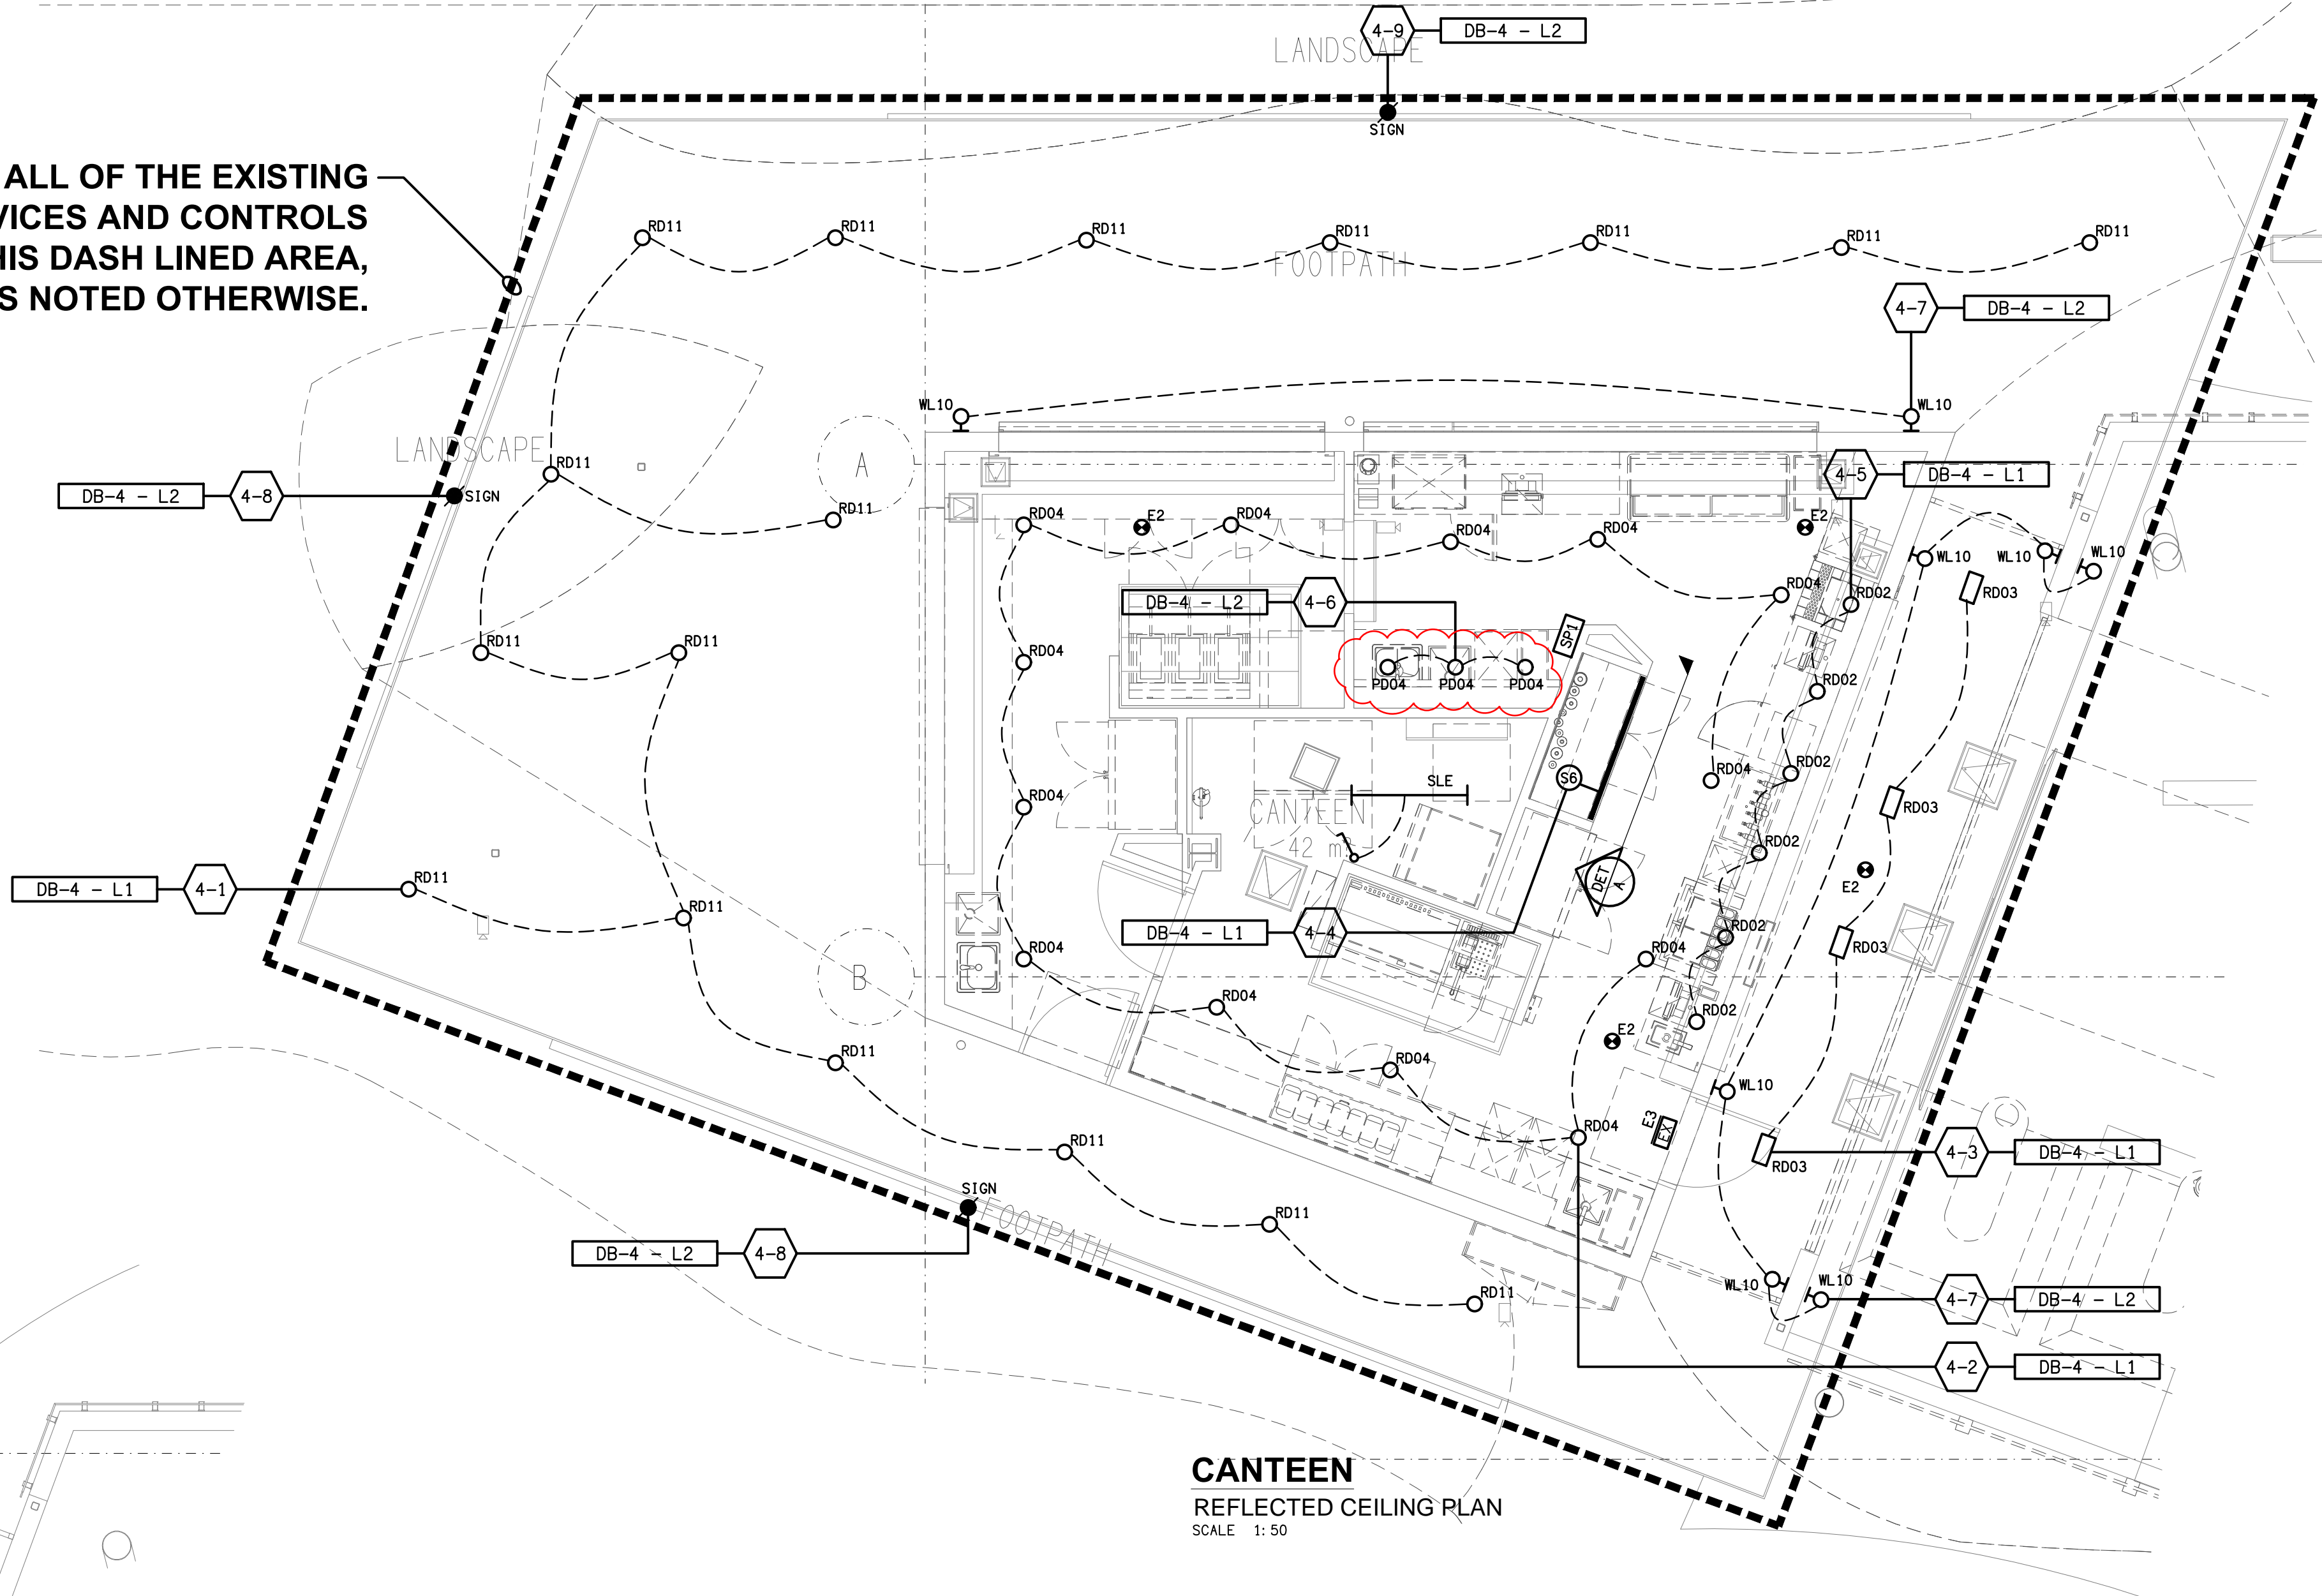

CANTEEN
REFLECTED CEILING PLAN
SCALE 1: 50

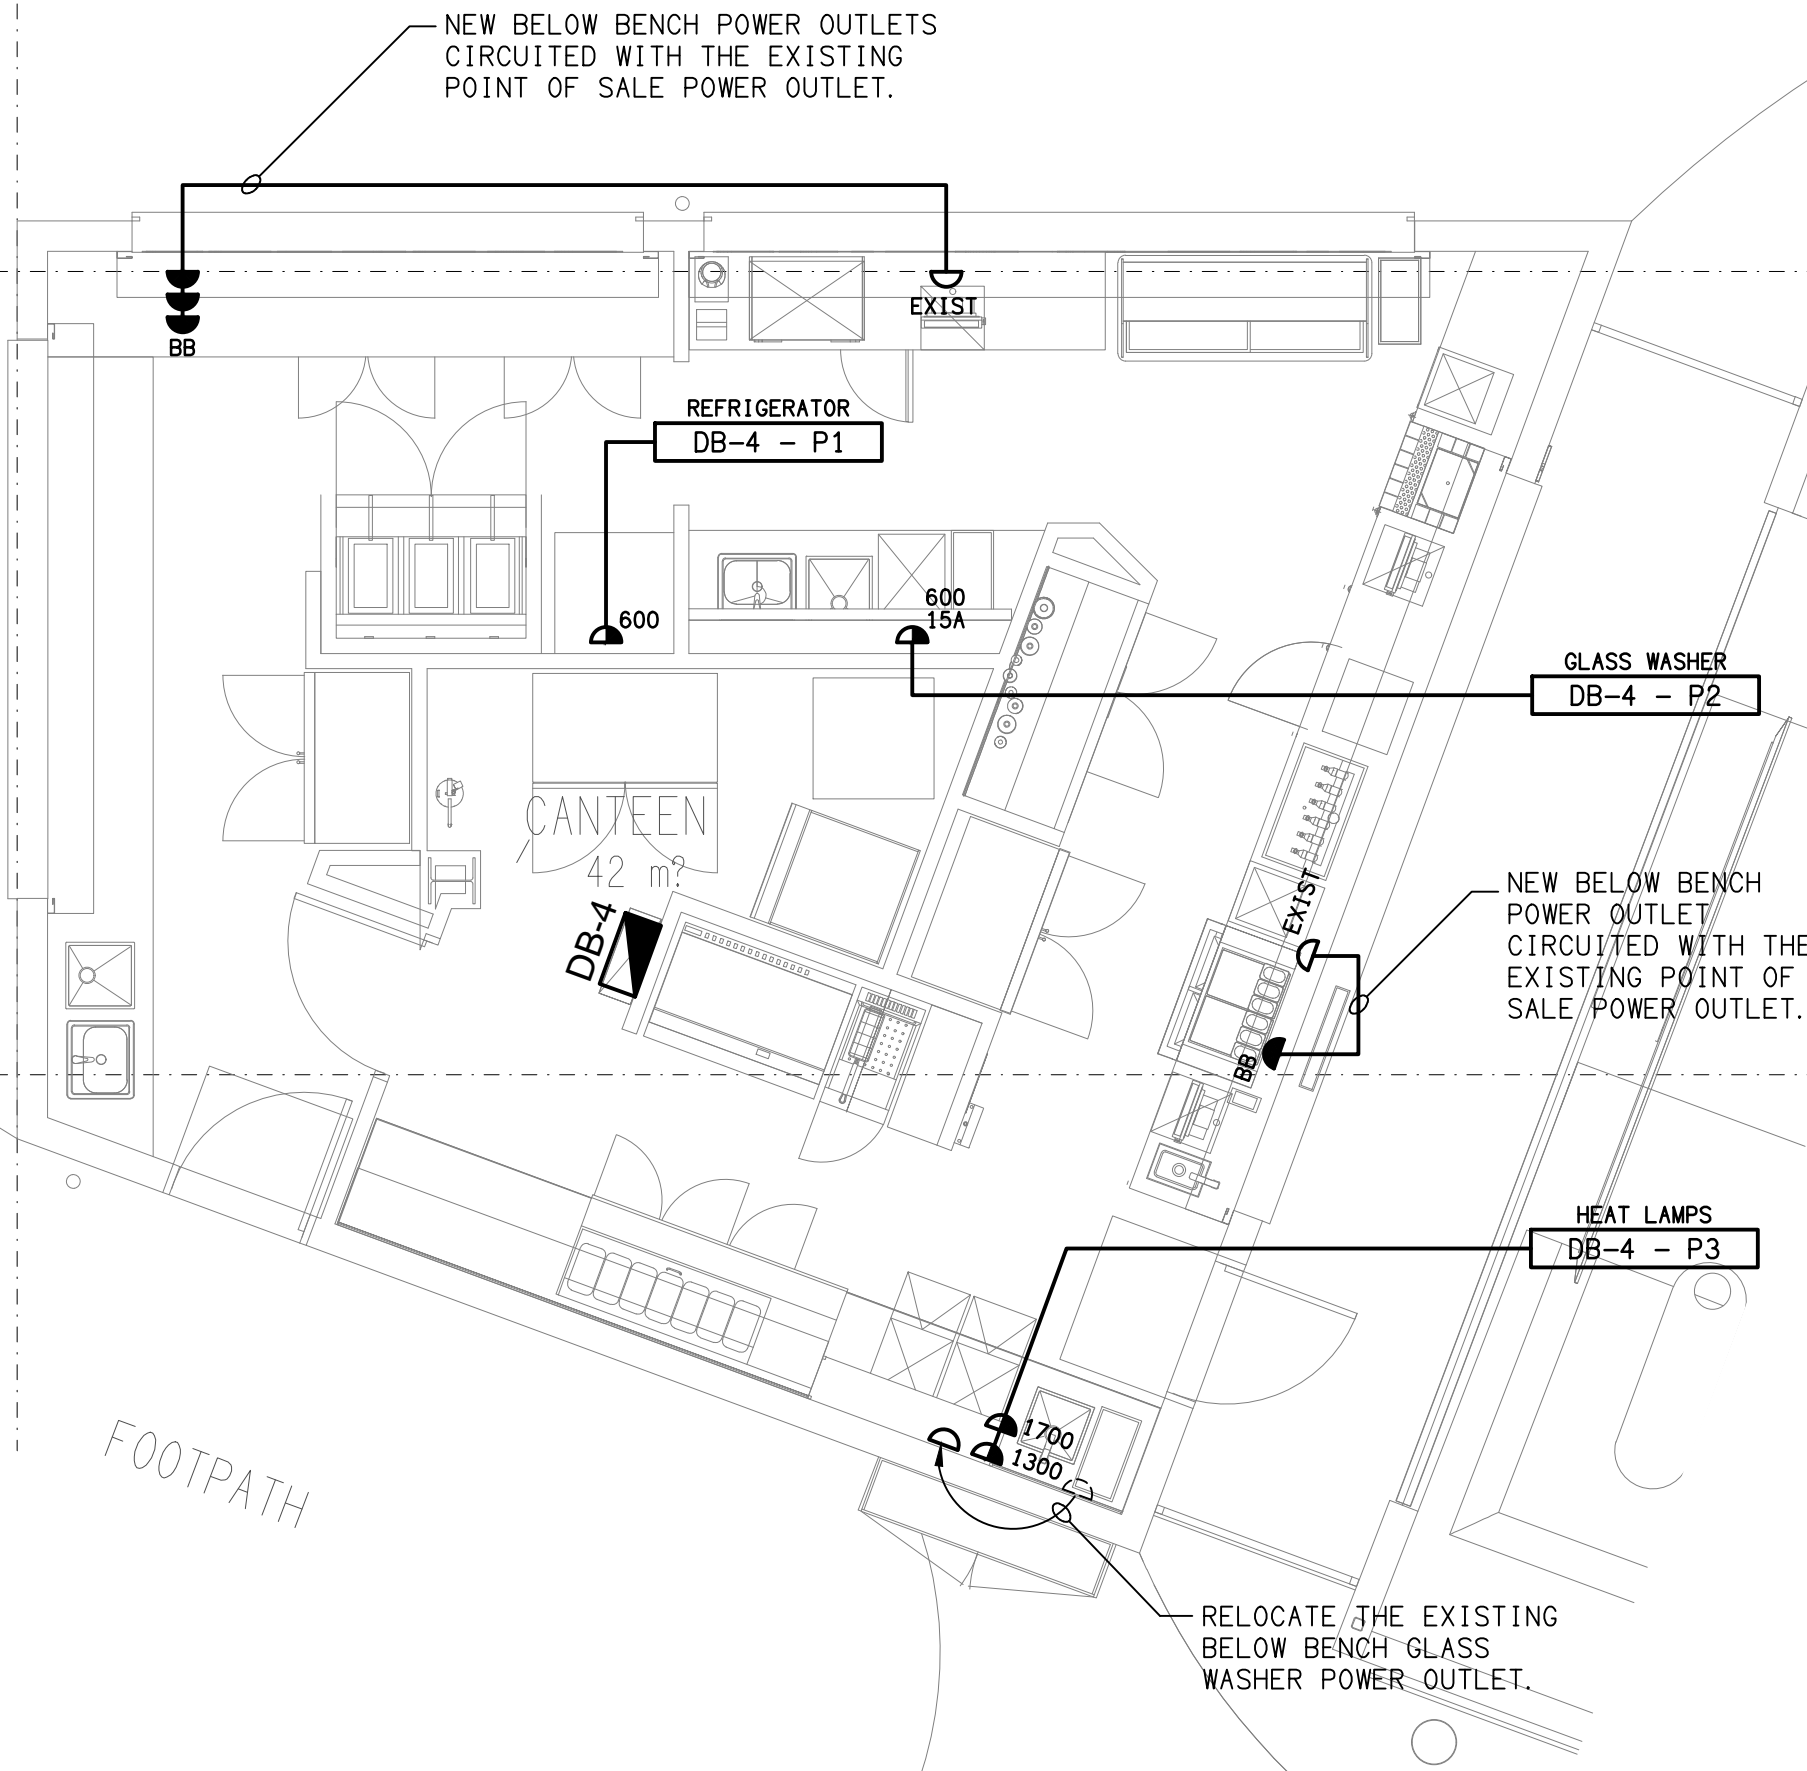

CANTEEN
FLOOR PLAN
SCALE 1: 50

ELECTRICAL DESIGN GROUP BRISBANE
PTY LTD
ACN 092 710 793
TRADING AS:
ELECTRICAL DESIGN GROUP

THE COPYRIGHT OF THIS DRAWING
REMAINS THE PROPERTY OF THE
ELECTRICAL DESIGN GROUP.
USE FIGURED DIMENSIONS
IN PREFERENCE TO SCALE.
ALL DIMENSIONS TO BE
VERIFIED ONSITE.

ELECTRICAL DESIGN GROUP
ELECTRICAL BUILDING SERVICES CONSULTANTS
BRISBANE GOLD COAST

P.O.Box 15, Sherwood Q.4075
Phone: (07) 3278 4375
Email: brisbane@edg.net.au
Web: www.edg.net.au


PROJECT:
COOLUM BEACH HOTEL

CORNER BIRTWILL STREET & DAVID LOW WAY, COOLUM BEACH


C	TENDER	27/05/2026
REV.	DESCRIPTION:	DATE:

DRAWING:
**ELECTRICAL SERVICES
CANTEEN PLANS**


SCALE: 1:50 UNO	AT A1	PROJECT NO: C3743a	DRAWING NO: E06	REVISION: C
--------------------	-------	------------------------------	---------------------------	-----------------------

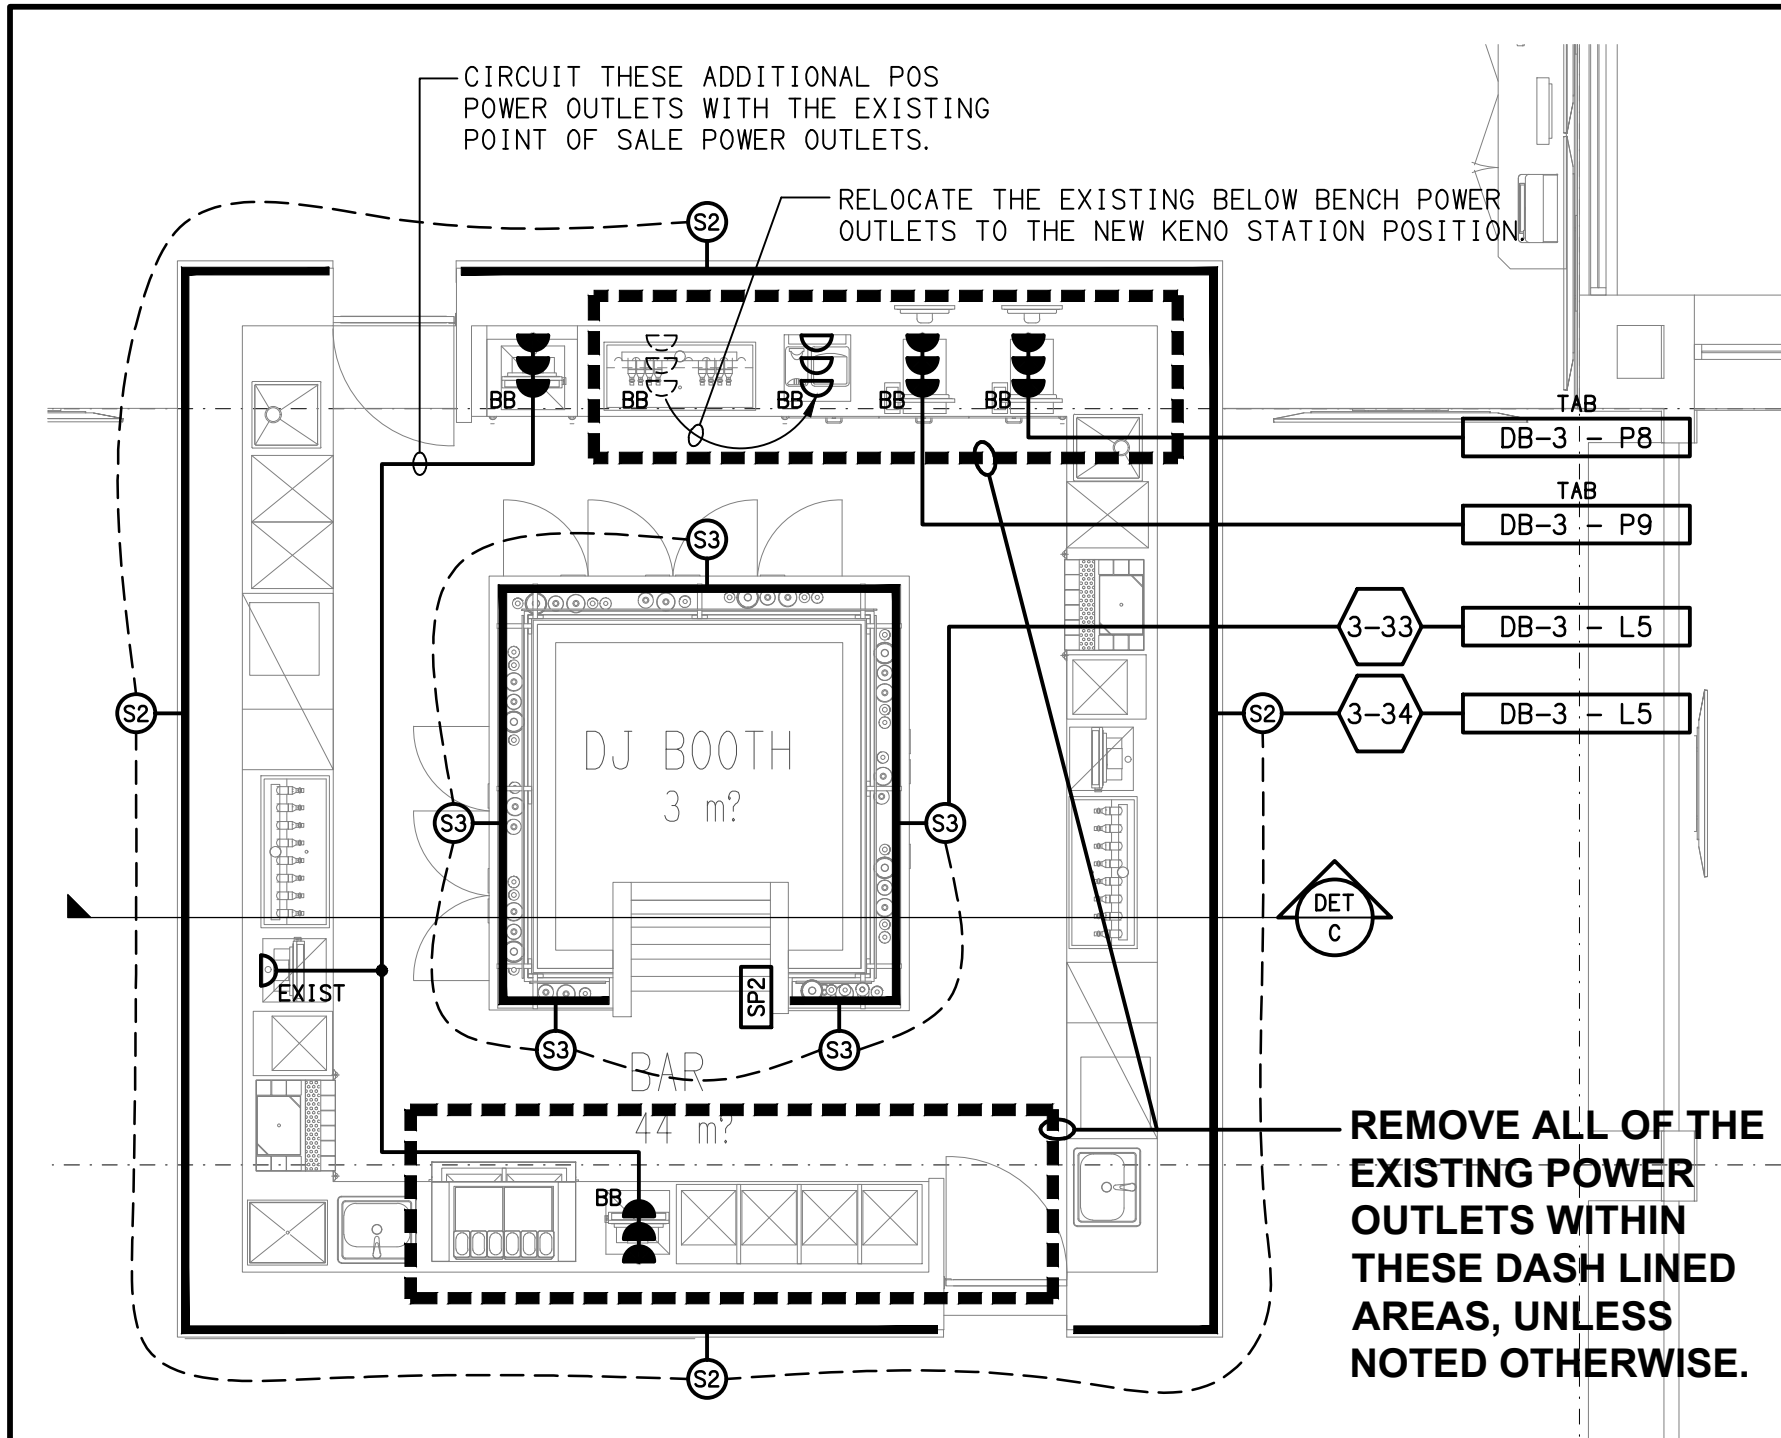


DETAIL A
SPORTS BAR FLOOR PLAN
SCALE 1: 50

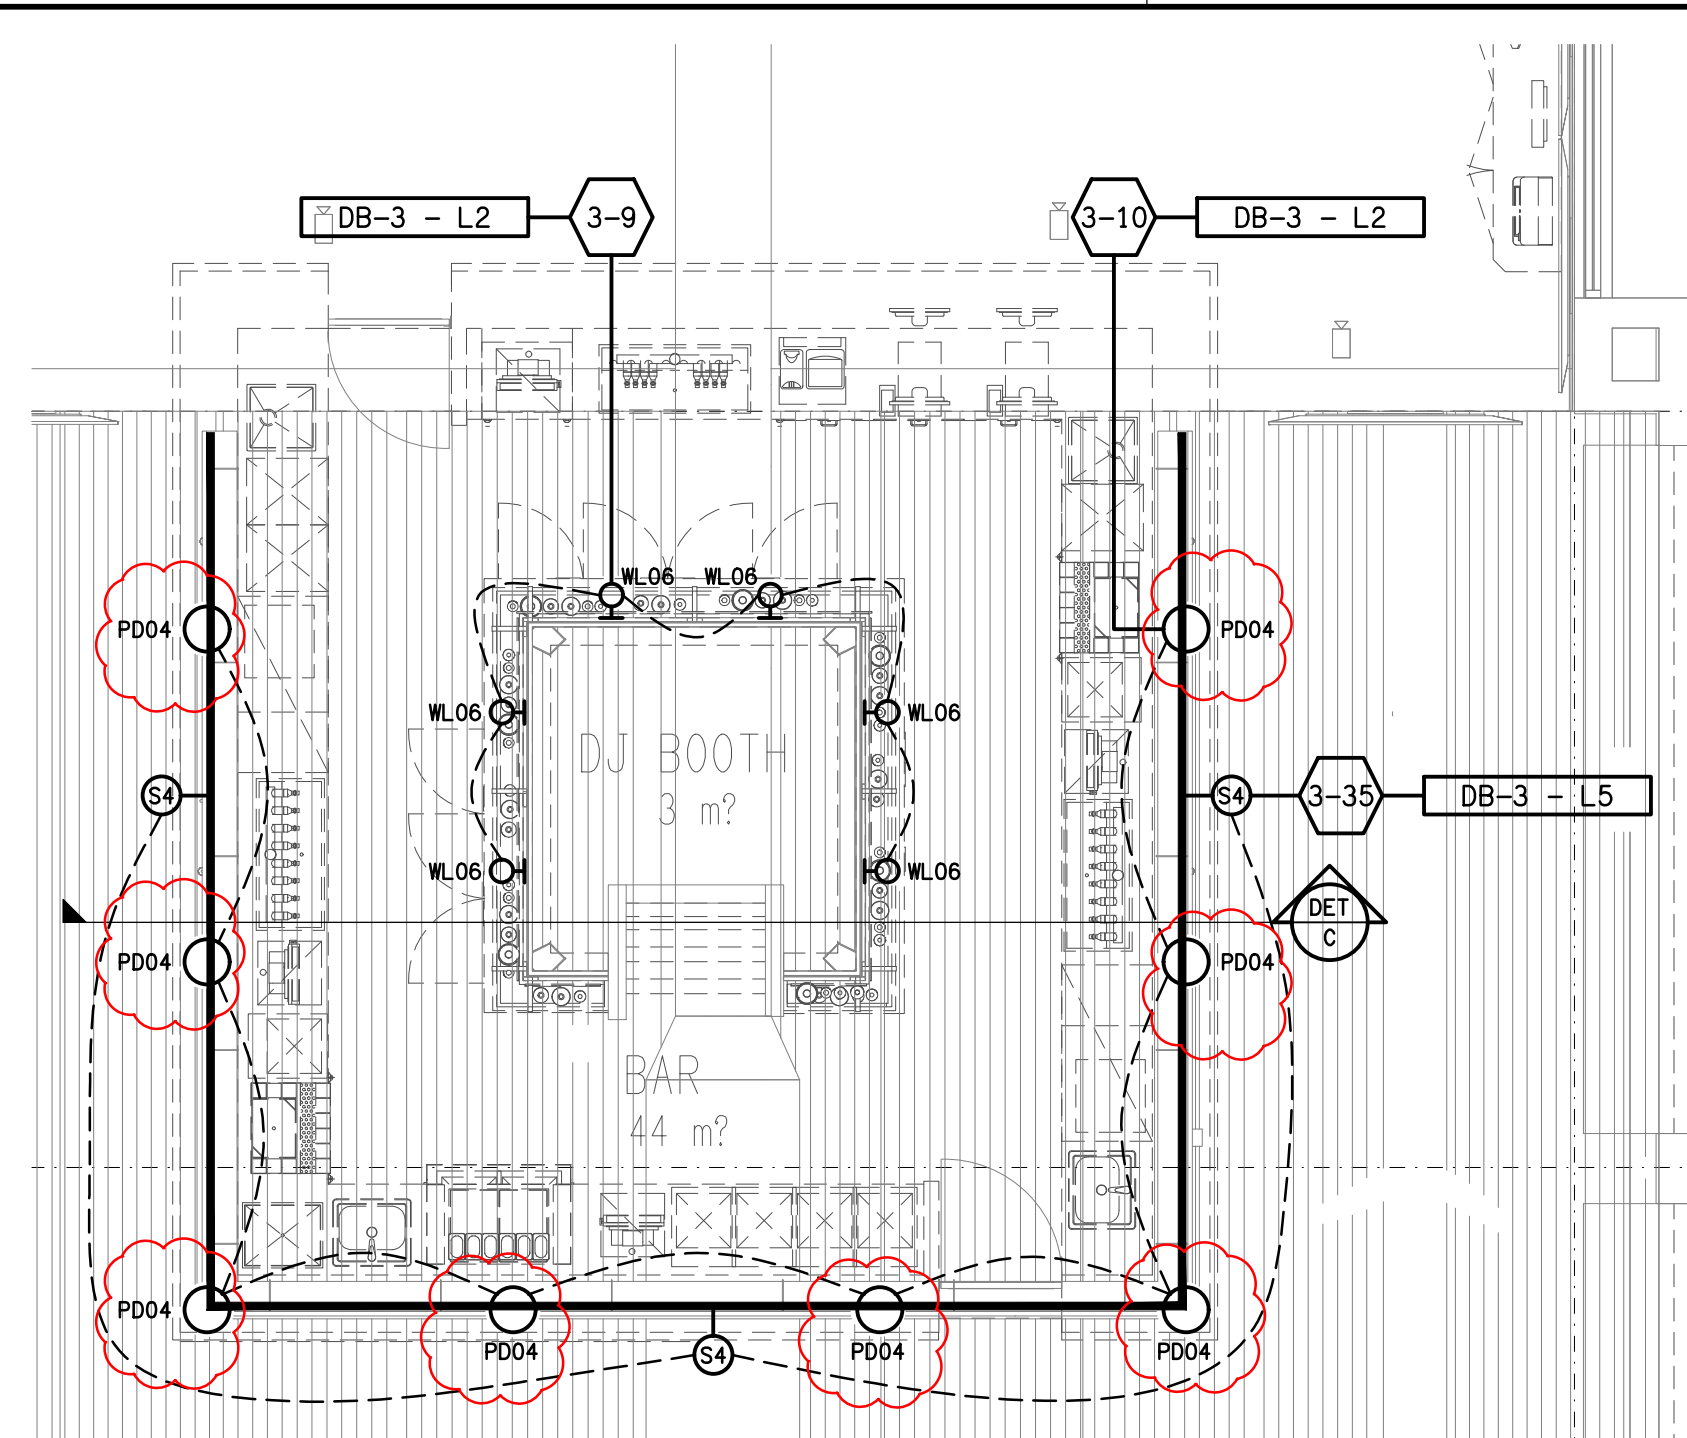


DETAIL B
SPORTS BAR CEILING LIGHTING
SCALE 1: 50

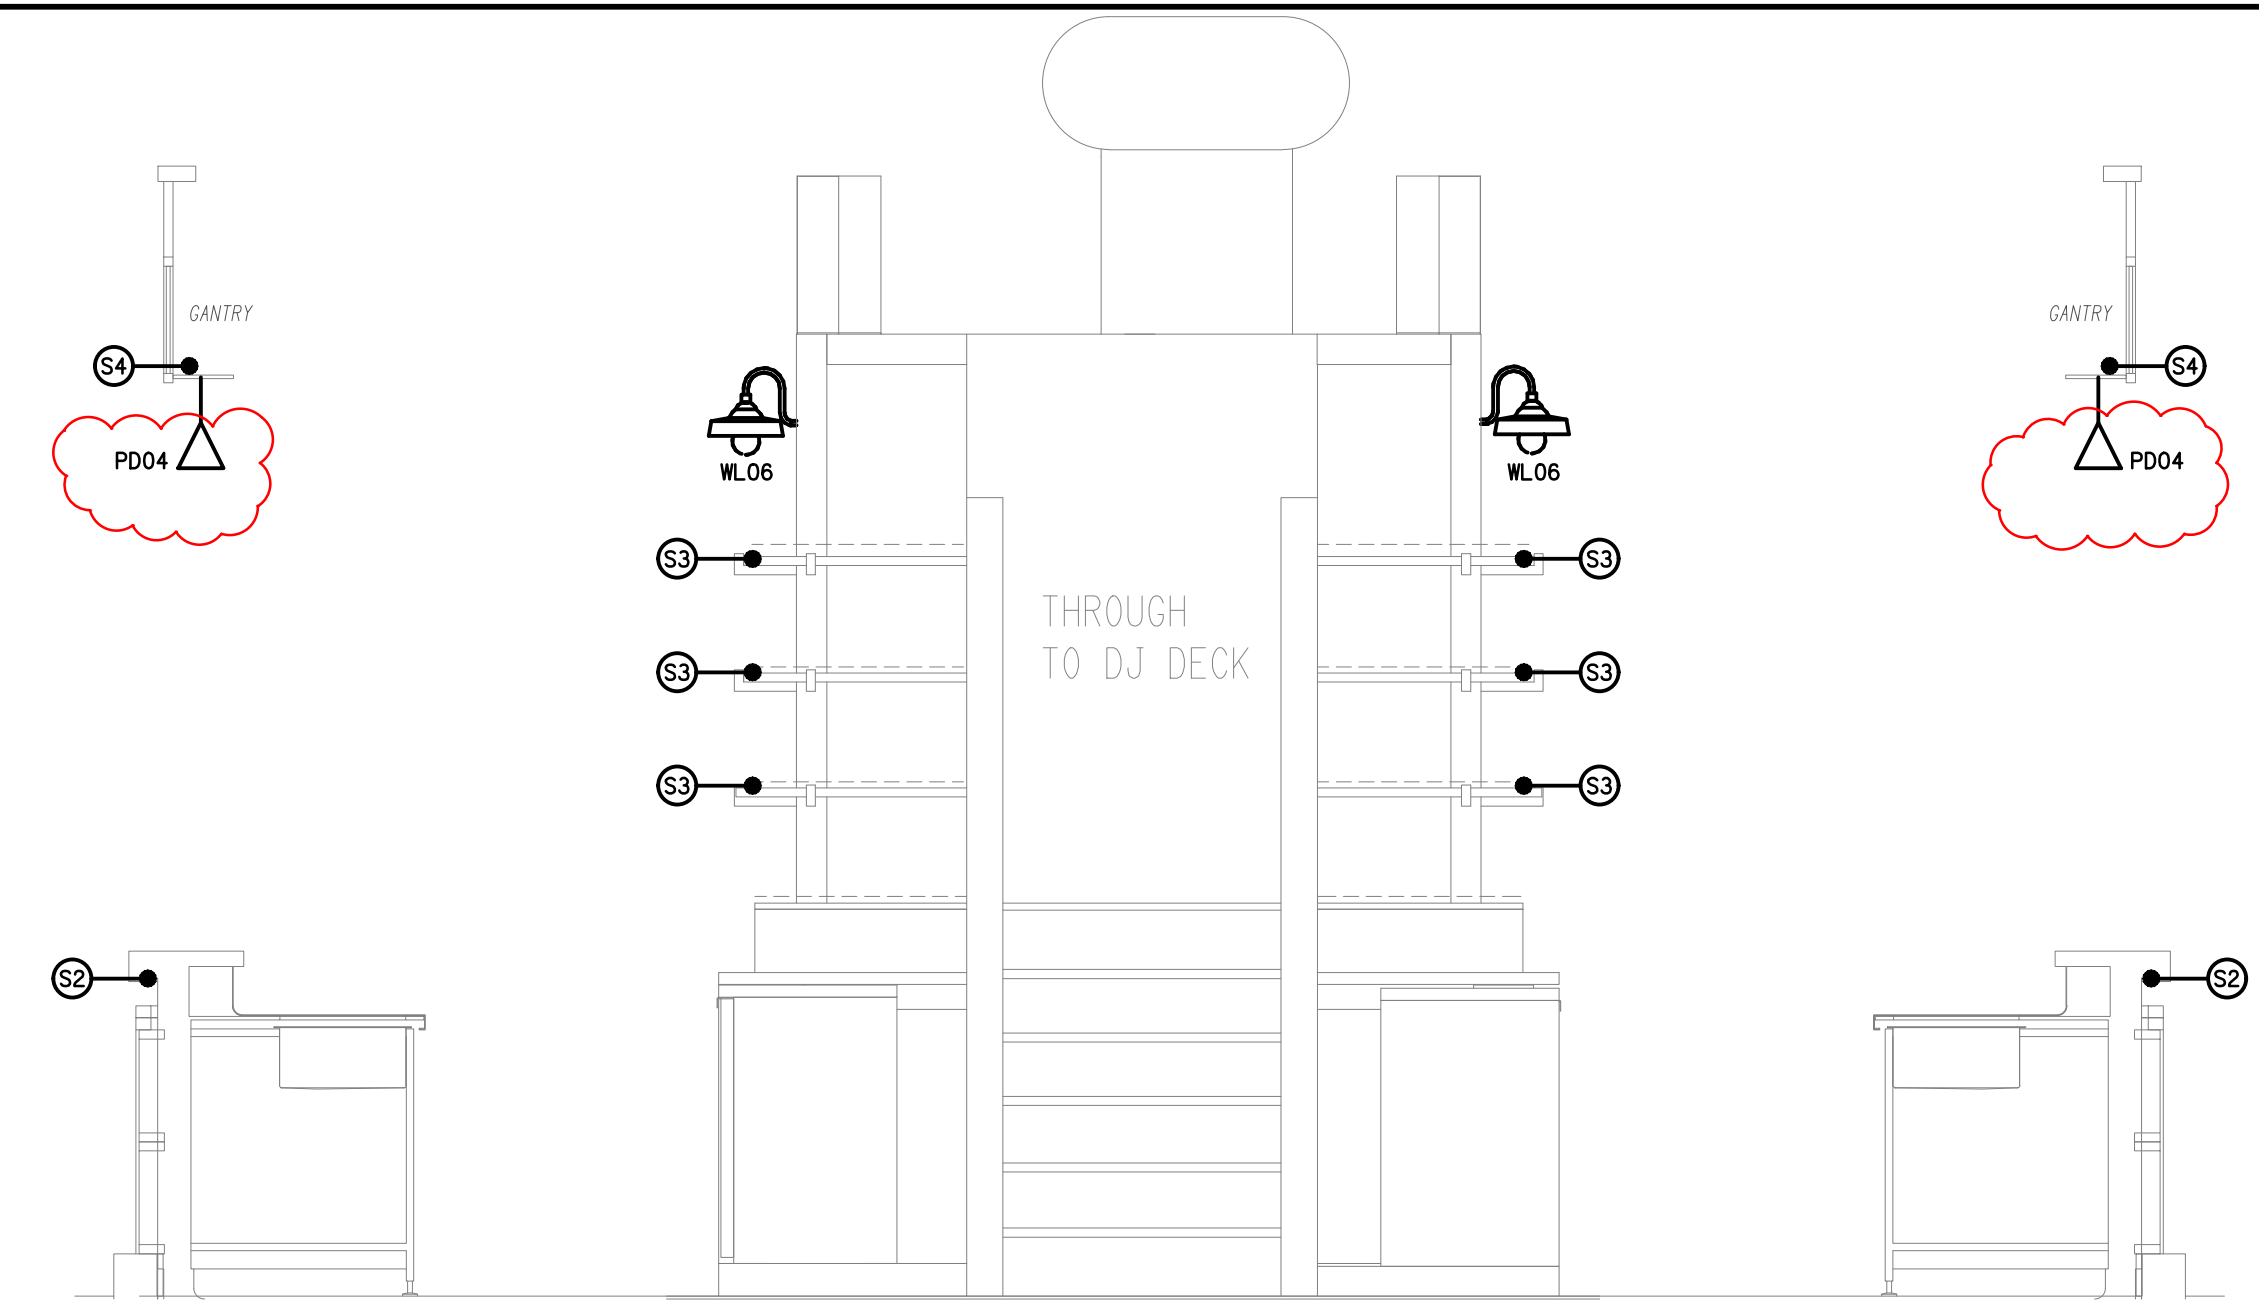


DETAIL C
SPORTS BAR LIGHTING SECTION
SCALE 1: 25

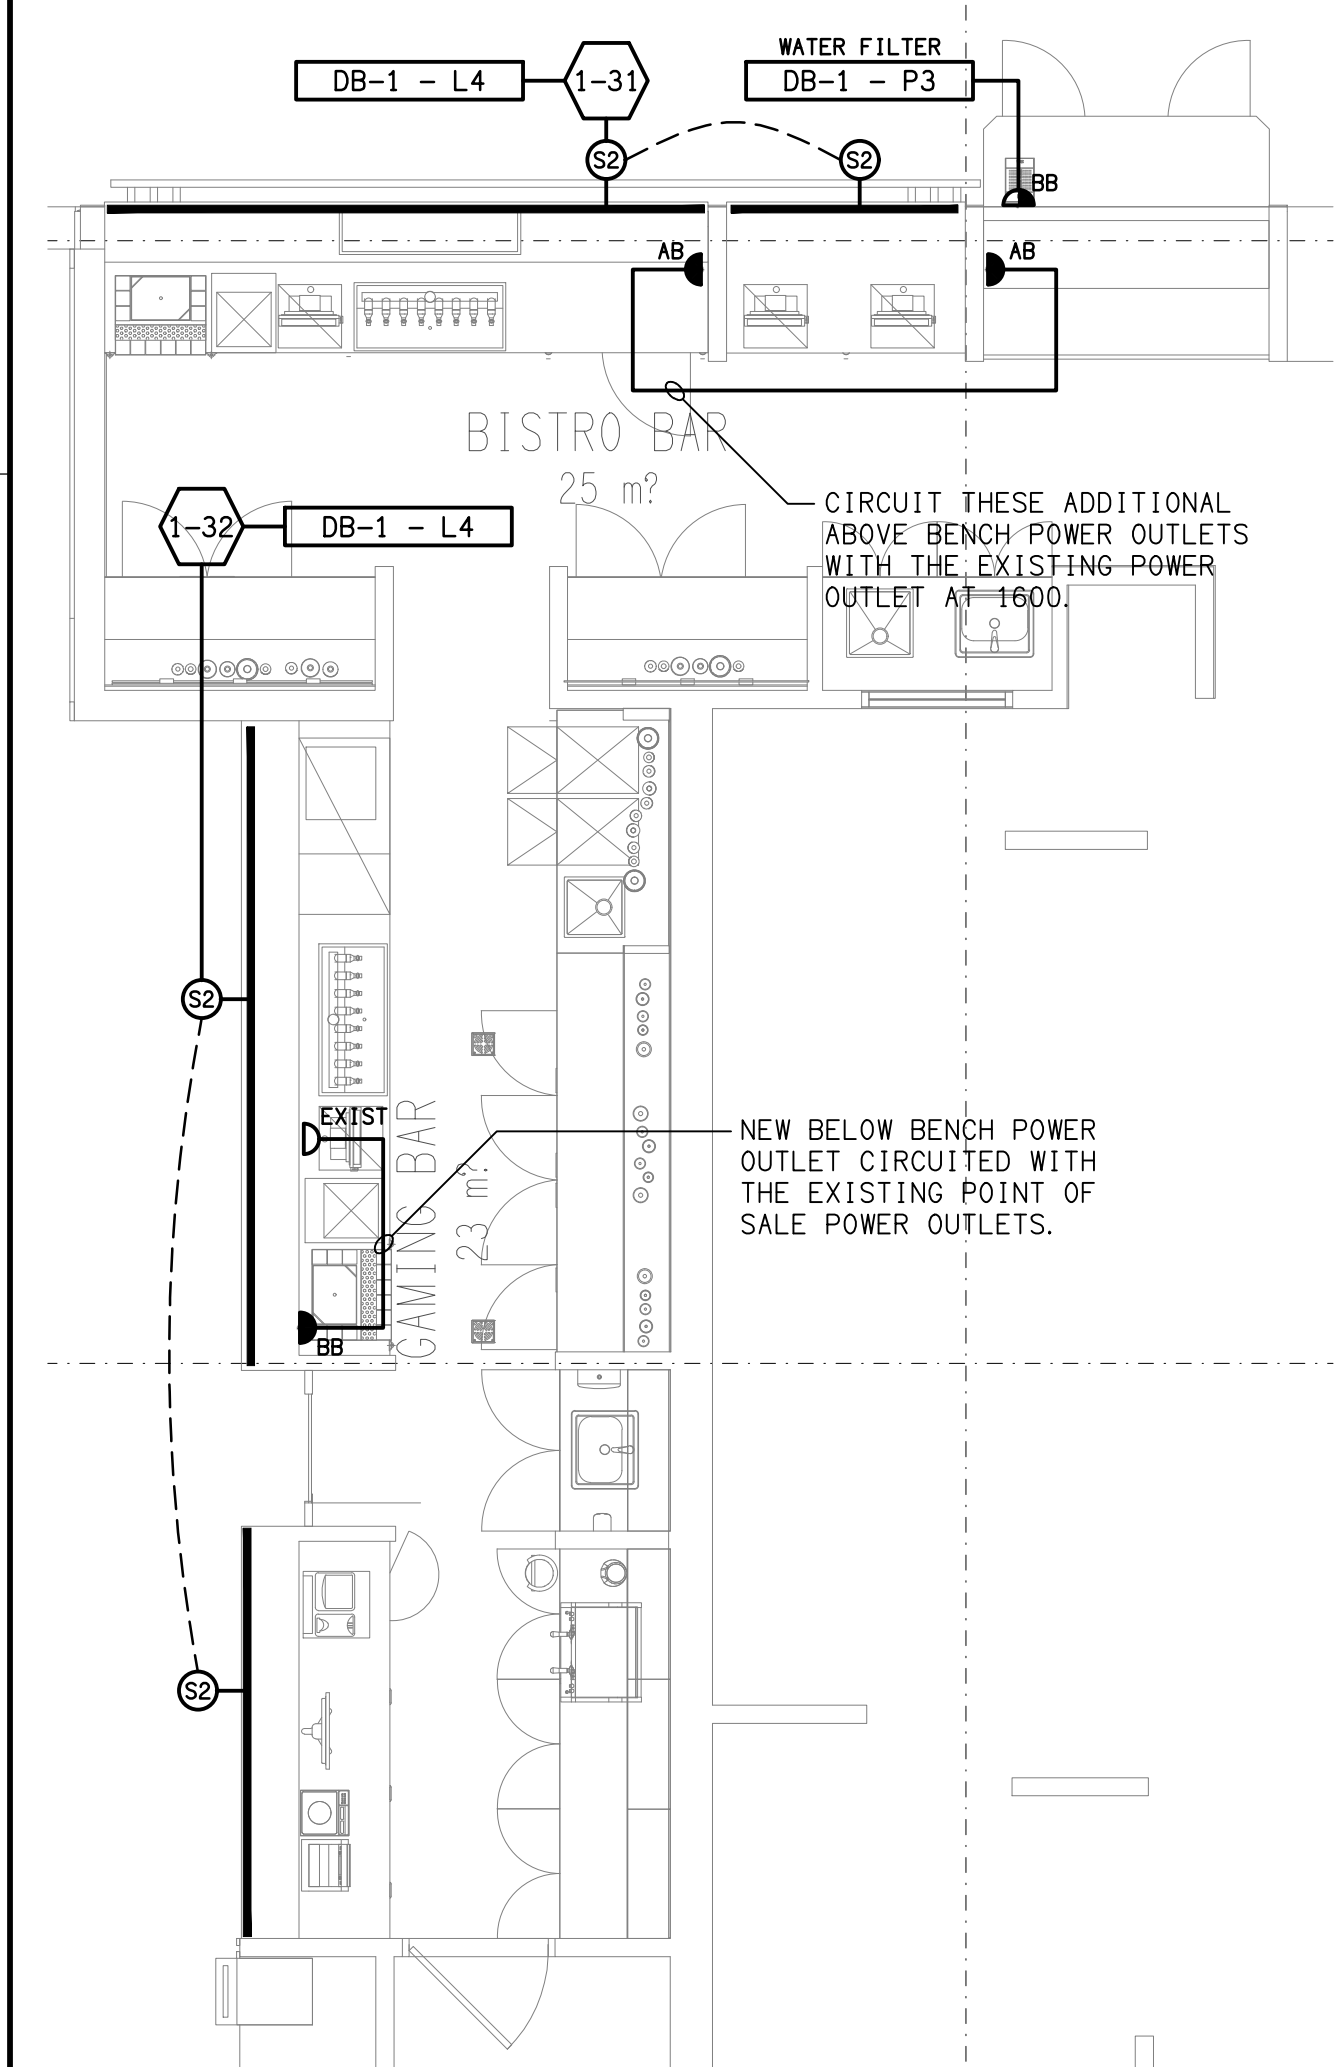


DETAIL D
GAMING & BISTRO BAR FLOOR PLAN
SCALE 1: 50

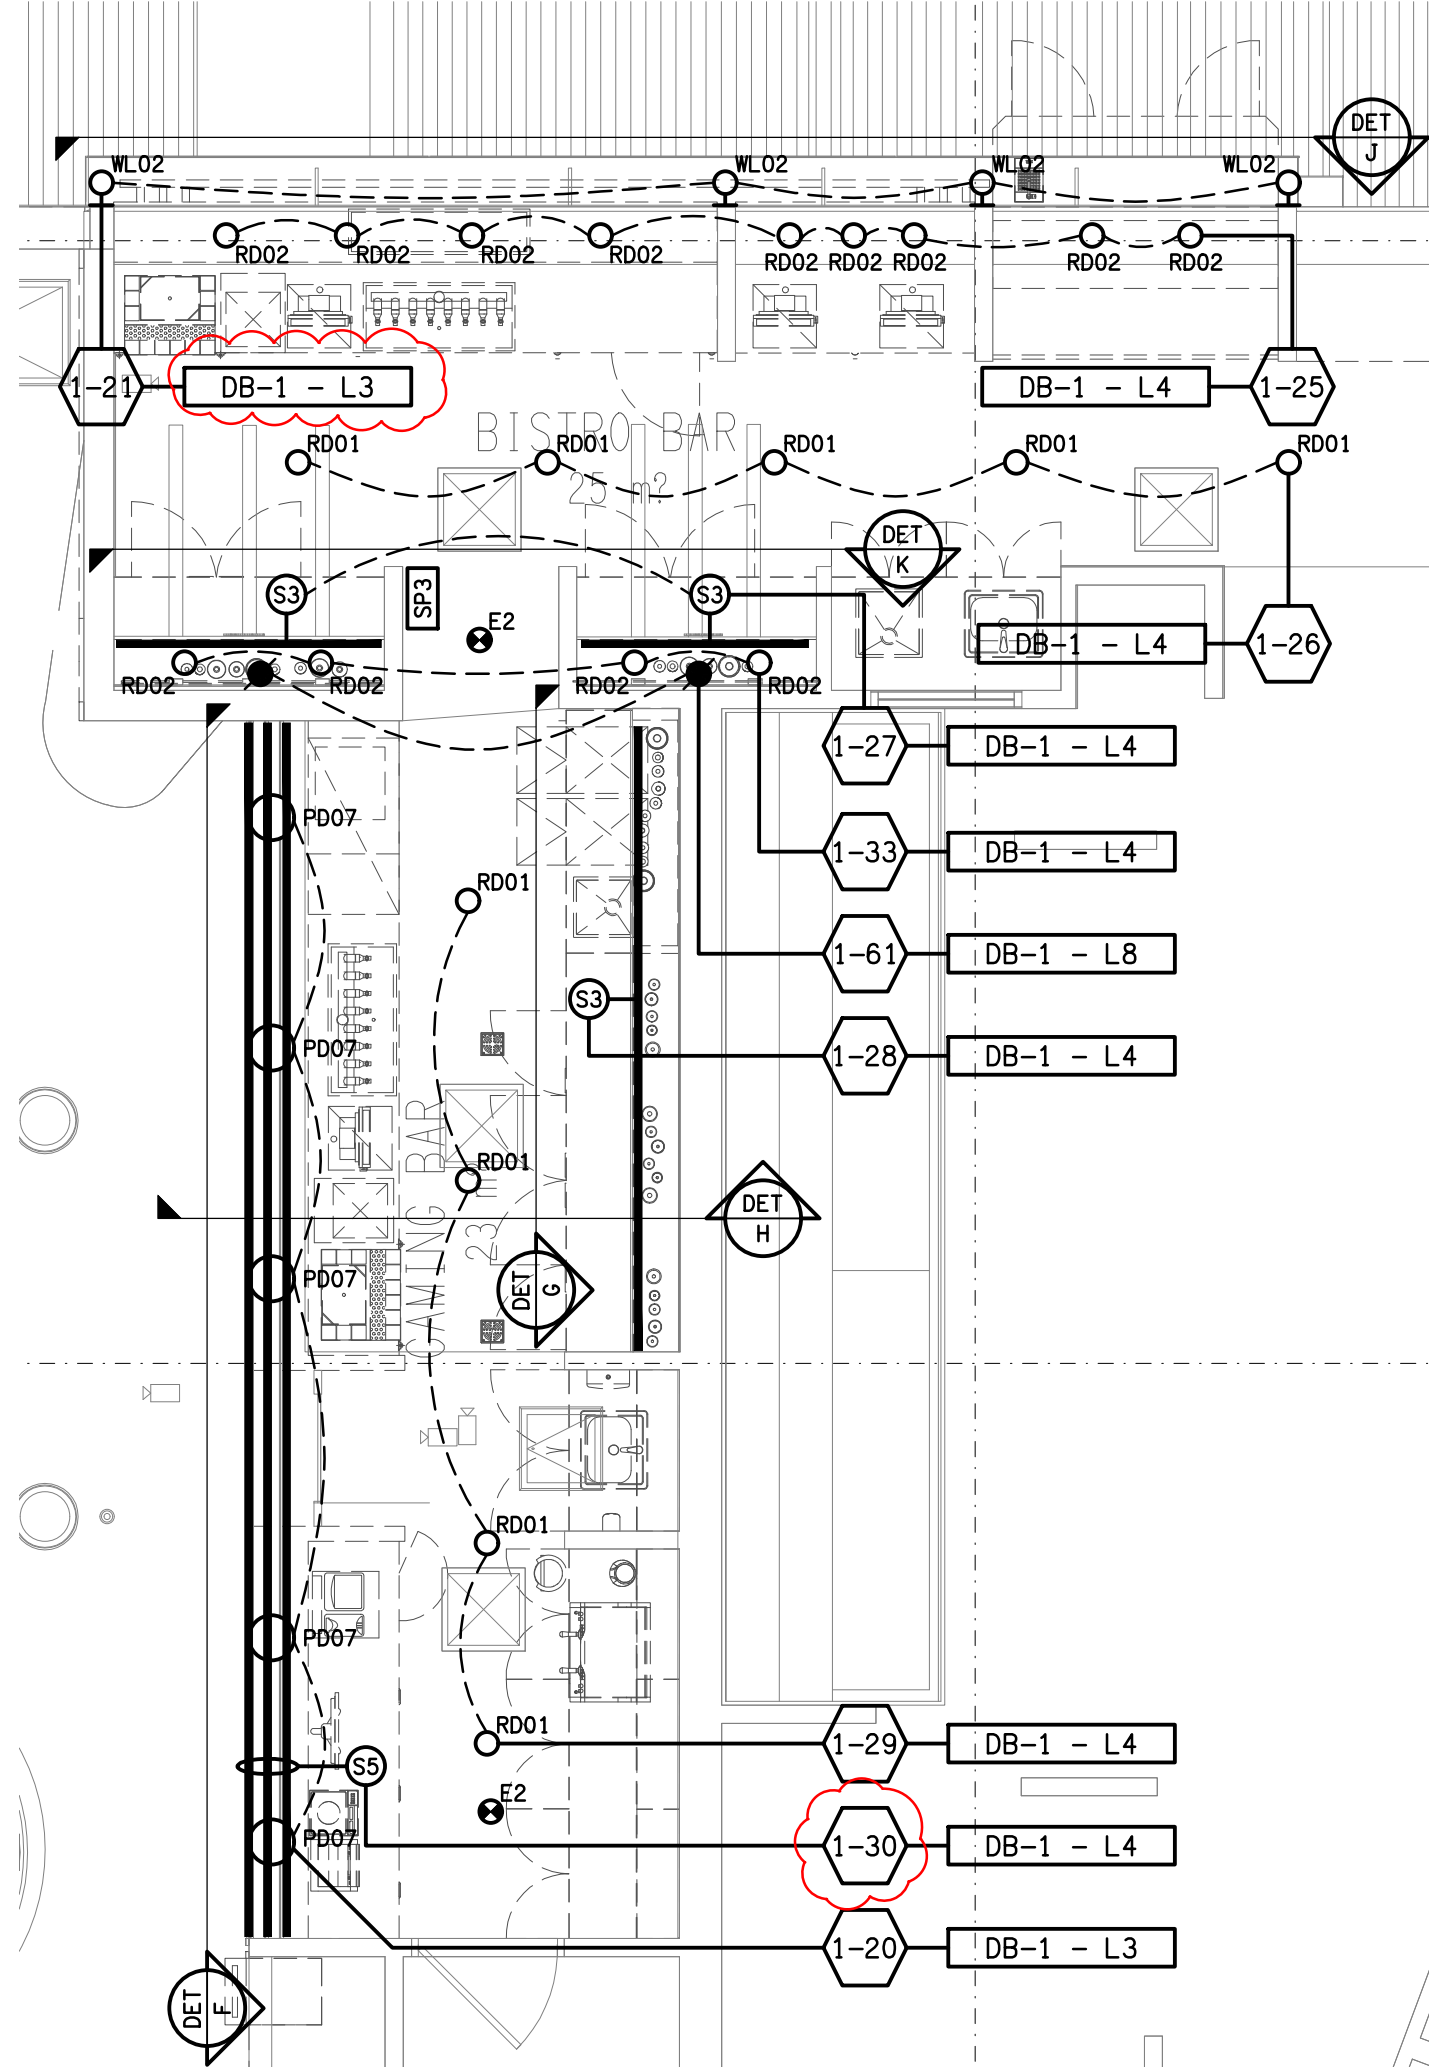


DETAIL E
GAMING & BISTRO BAR CEILING PLAN
SCALE 1: 50

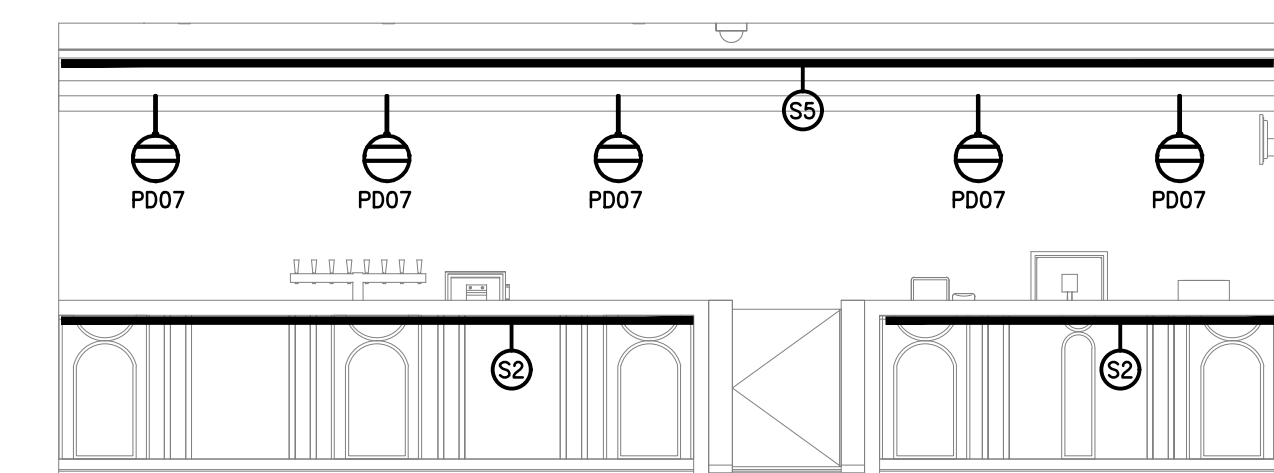


DETAIL F
GAMING BAR COUNTER LIGHTING ELEVATION
SCALE 1: 50

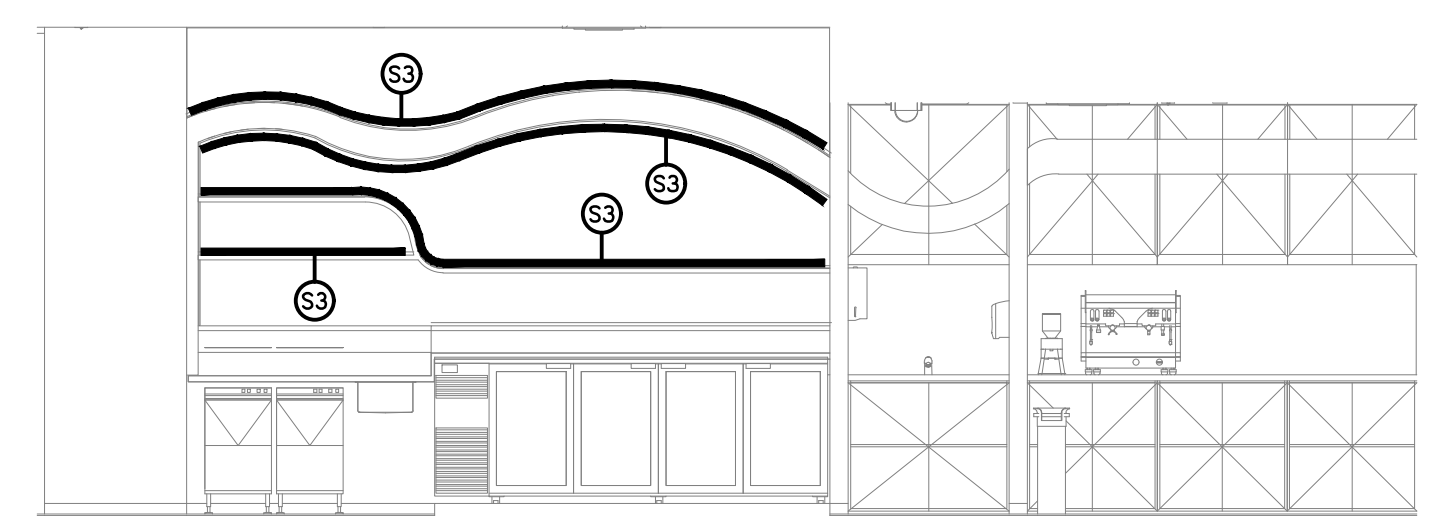

DETAIL G
GAMING BAR REAR WALL LIGHTING ELEVATION
SCALE 1: 50

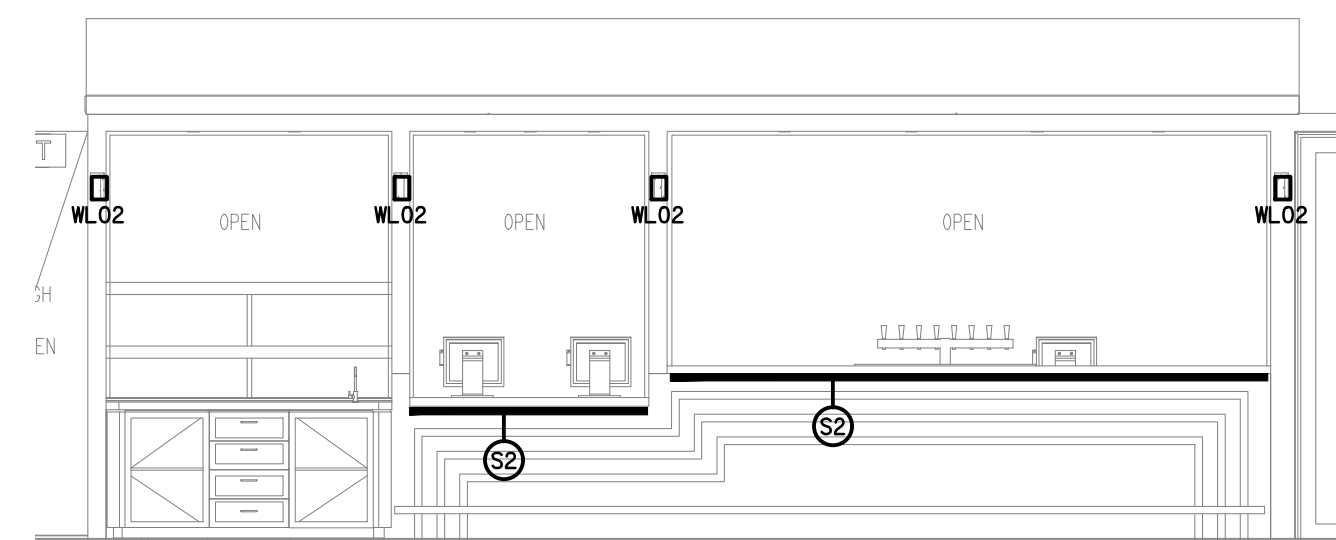



DETAIL J
BISTRO BAR COUNTER LIGHTING ELEVATION
SCALE 1: 50

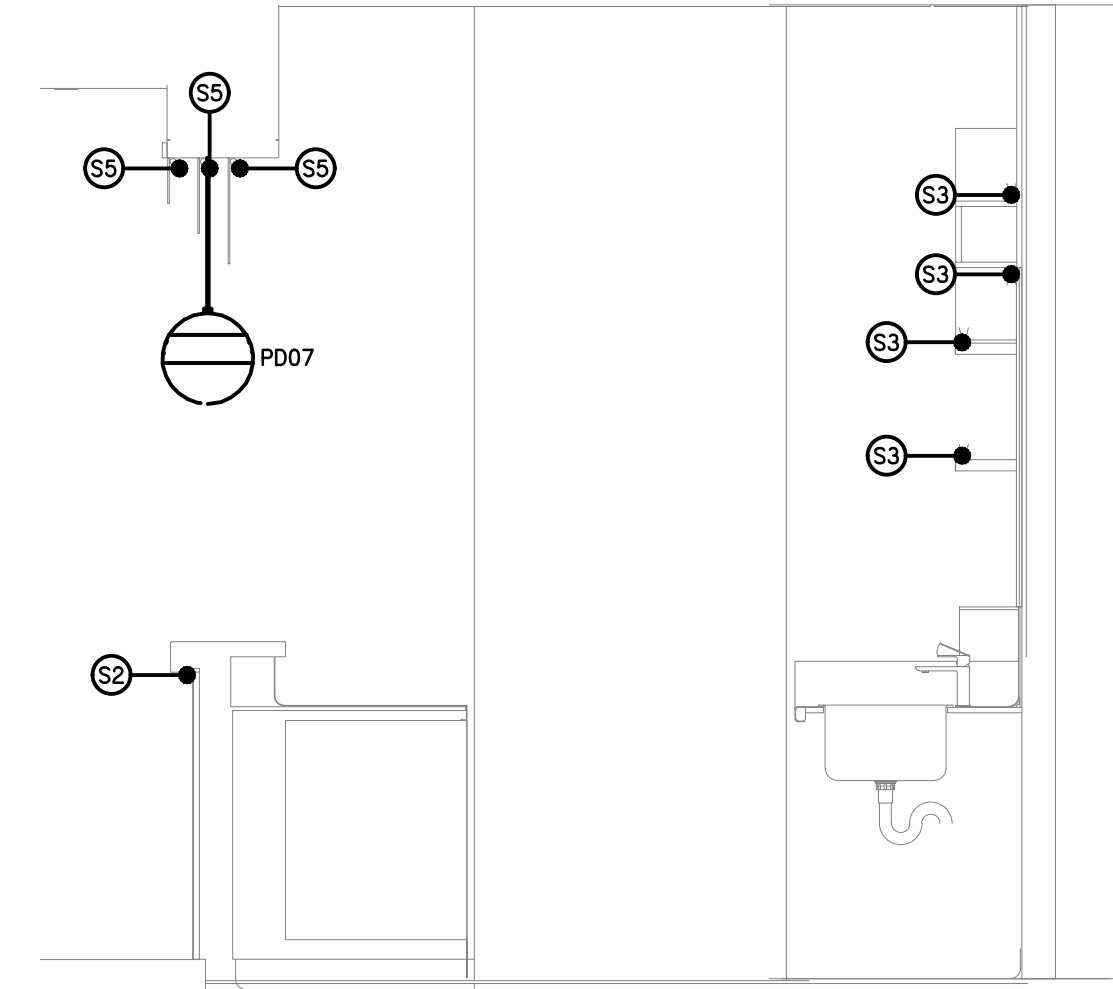


DETAIL H
GAMING BAR LIGHTING SECTION
SCALE 1: 25




DETAIL K
BISTRO BAR REAR WALL LIGHTING ELEVATION
SCALE 1: 50

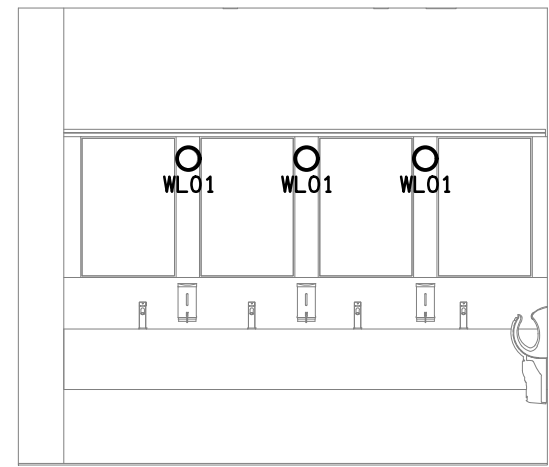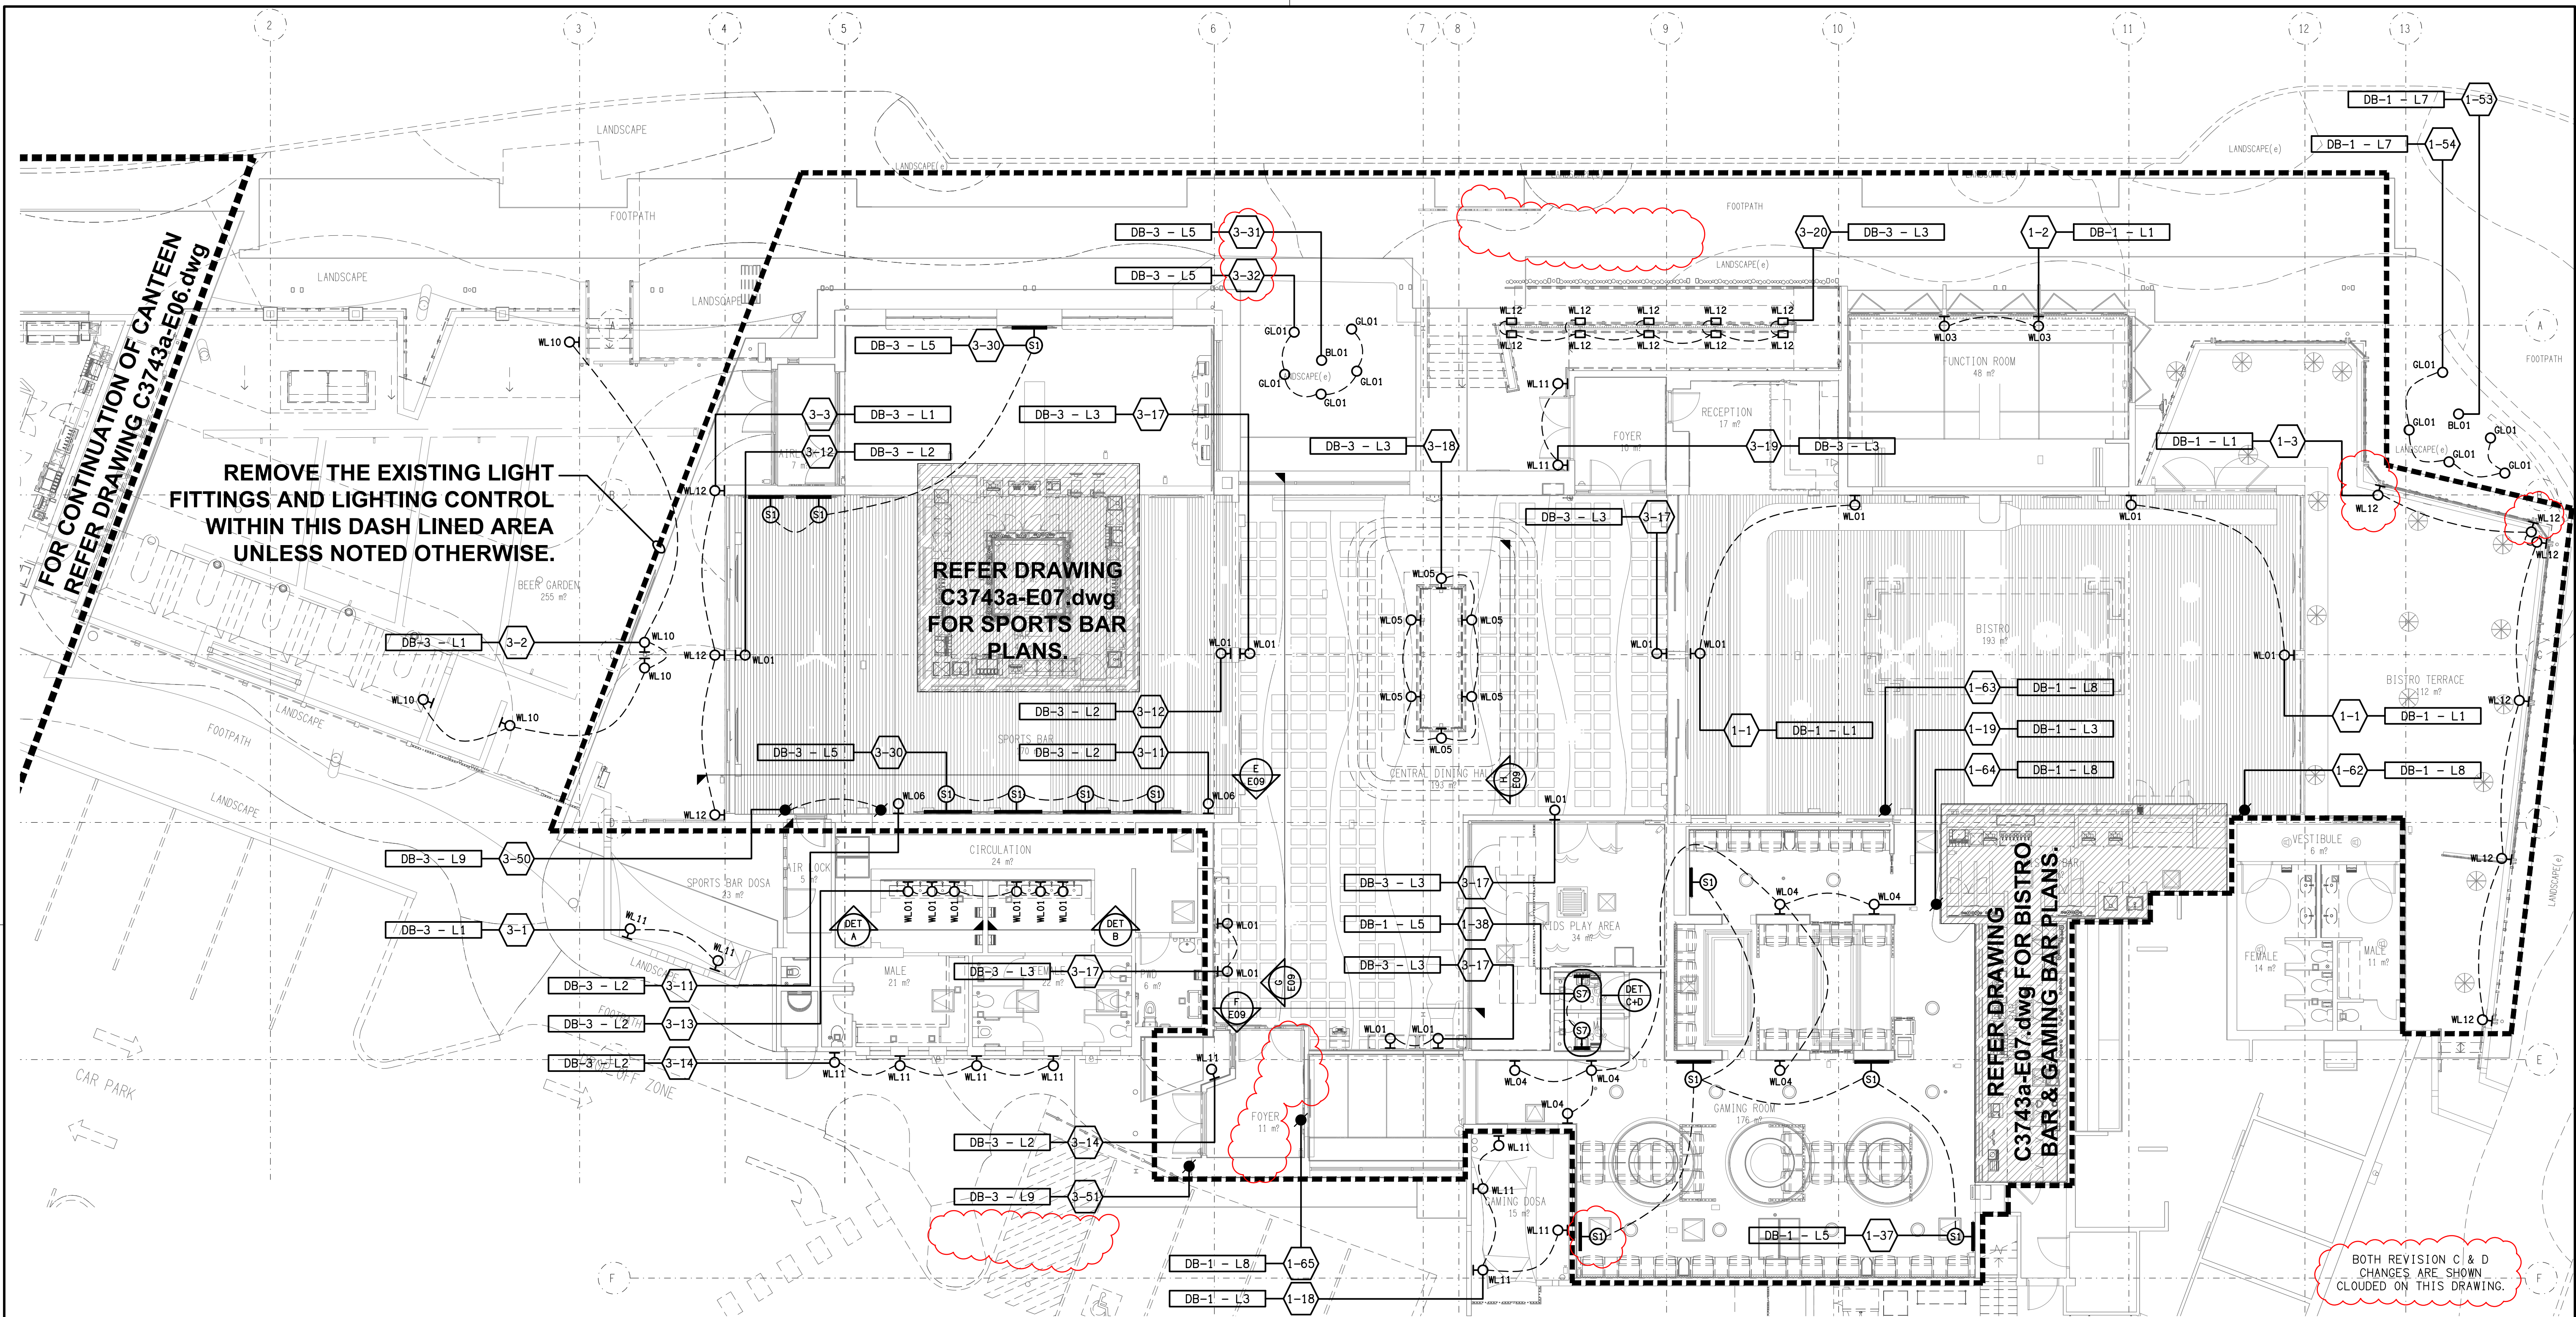


DETAIL A
SPORTS BAR MALE ELEVATION
SCALE 1:50

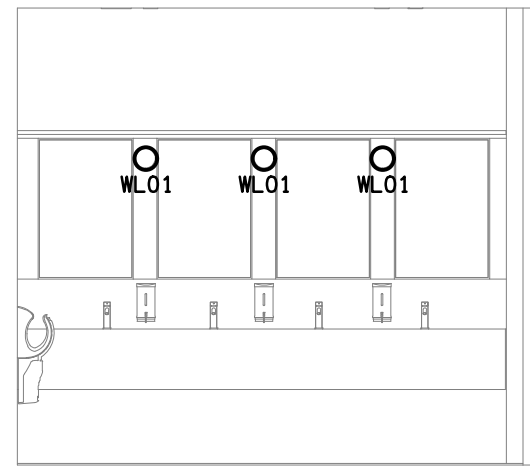

DETAIL B
SPORTS BAR FEMALE ELEVATION
SCALE 1:50

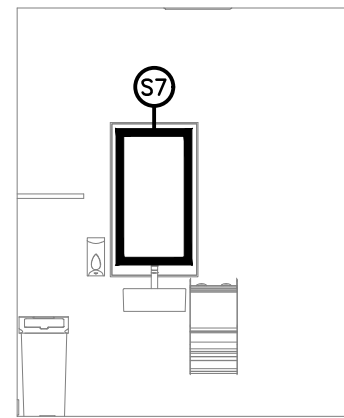

DETAIL C
GAMING FEMALE ELEVATION
SCALE 1:50

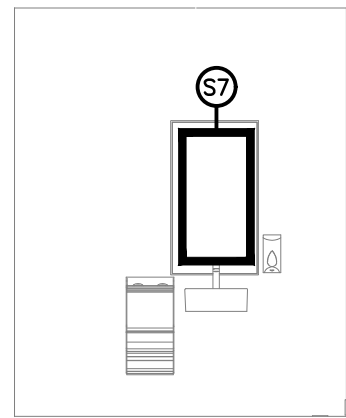

DETAIL D
GAMING MALE ELEVATION
SCALE 1:50

ELECTRICAL DESIGN GROUP BRISBANE
PTY LTD
ACN 092 710 793
TRADING AS:
ELECTRICAL DESIGN GROUP

THE COPYRIGHT OF THIS DRAWING
REMAINS THE PROPERTY OF THE
ELECTRICAL DESIGN GROUP.
USE FIGURED DIMENSIONS
IN PREFERENCE TO SCALE.
ALL DIMENSIONS TO BE
VERIFIED ONSITE.

ELECTRICAL DESIGN GROUP
ELECTRICAL BUILDING SERVICES CONSULTANTS
BRISBANE GOLD COAST

P.O. Box 15, Sherwood Q.4075
Phone: (07) 3278 4375
Email: brisbane@edg.net.au
Web: www.edg.net.au

PROJECT:
COOLUM BEACH HOTEL

CORNER BIRTWILL STREET & DAVID LOW WAY, COOLUM BEACH

D	TENDER	29/05/2026
REV.	DESCRIPTION:	DATE:

DRAWING:
**ELECTRICAL SERVICES
JOINERY & WALL LIGHTING
PLAN**


SCALE:
1:100 UNO

AT A1


PROJECT NO:
C3743a

DRAWING NO:
E08


REVISION:
D

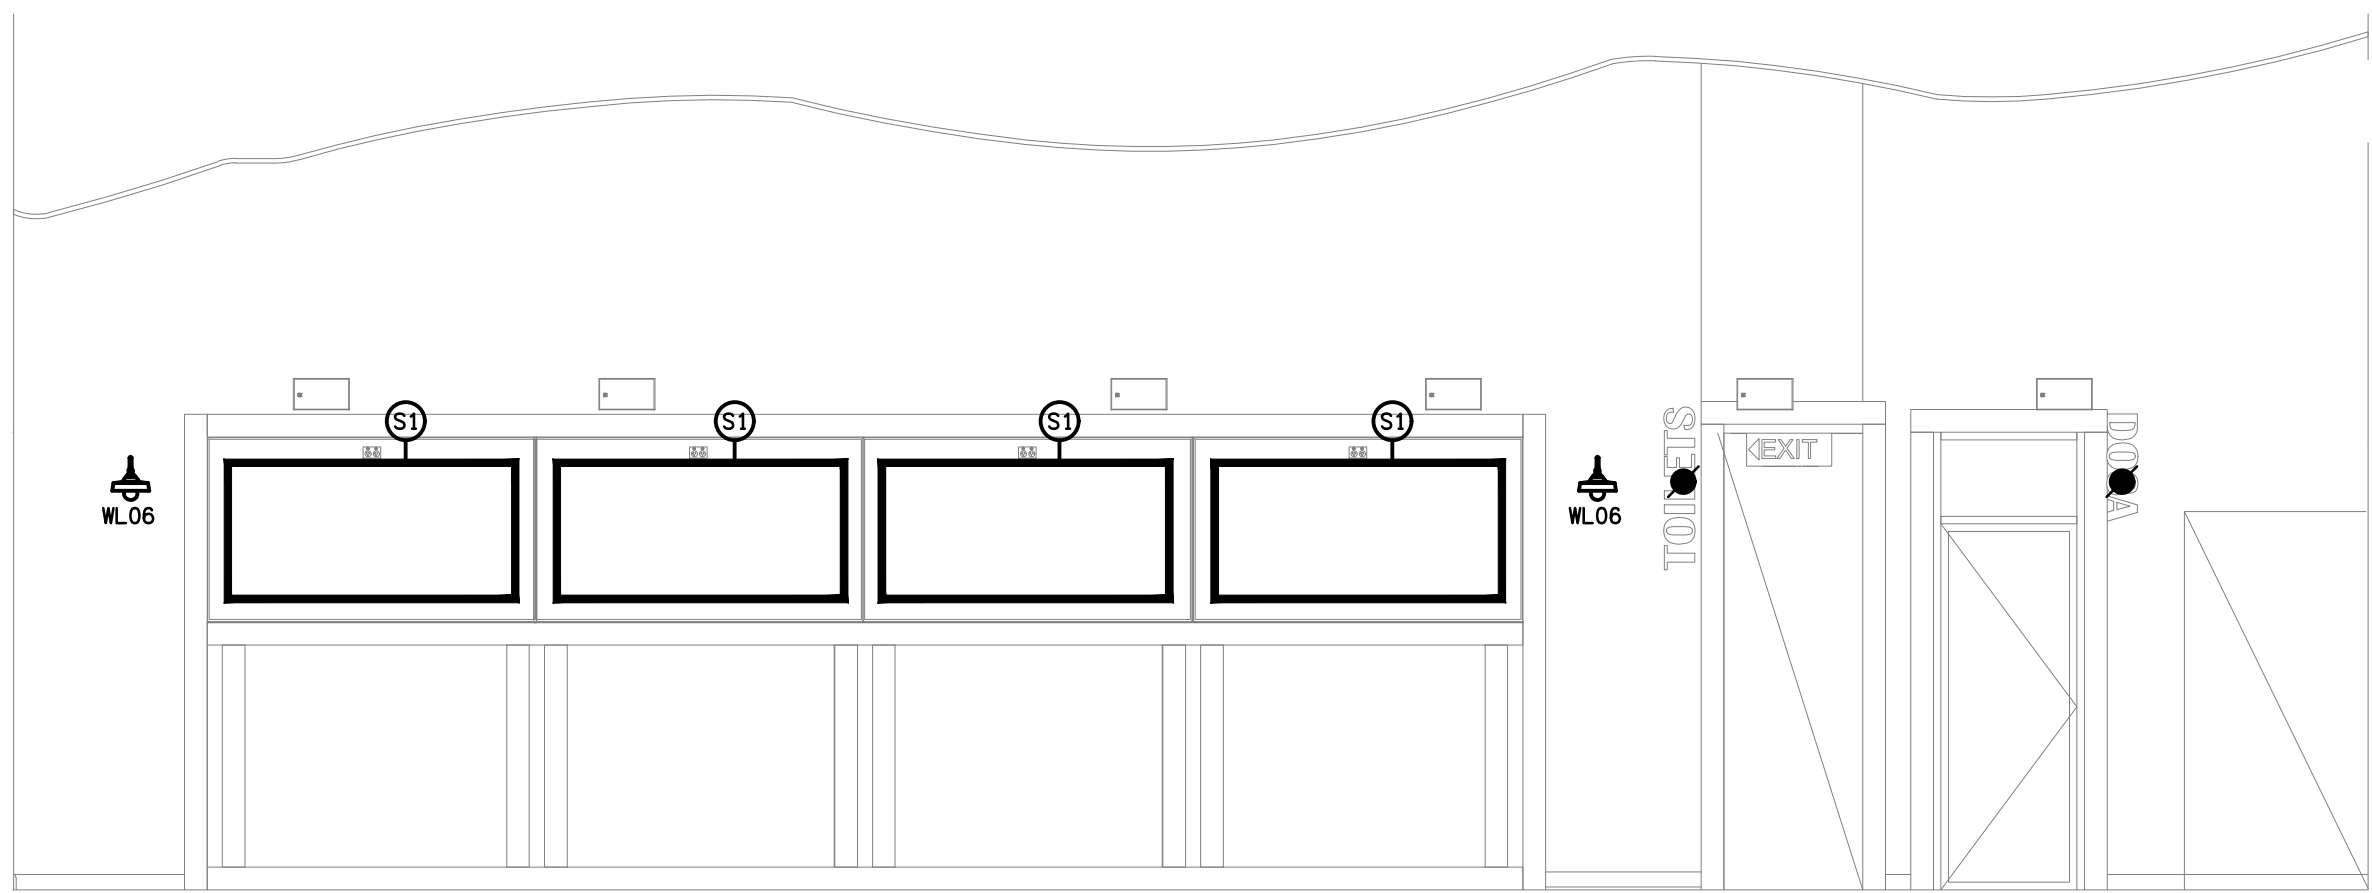


DETAIL E
SPORTS BAR ELEVATION 1
SCALE 1: 50

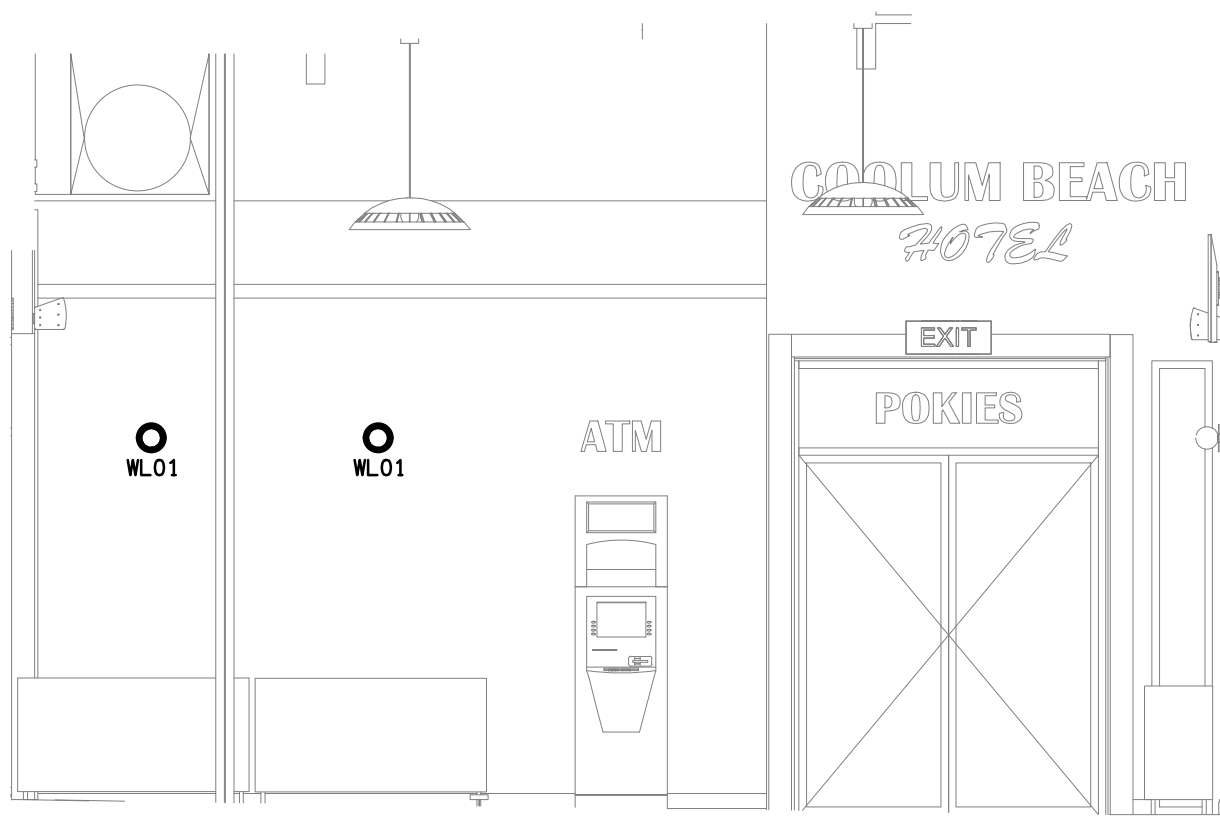


DETAIL F
DINING HALL ELEVATION 1
SCALE 1: 50

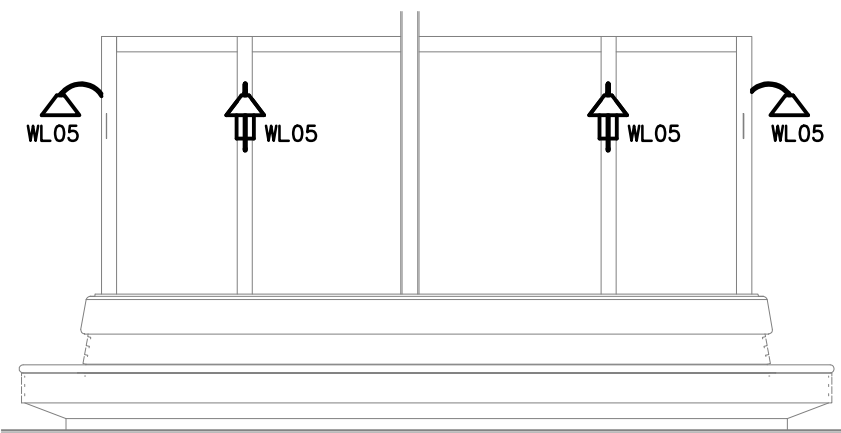


DETAIL H
DINING BANQUETTE SEAT ELEVATION
SCALE 1: 50

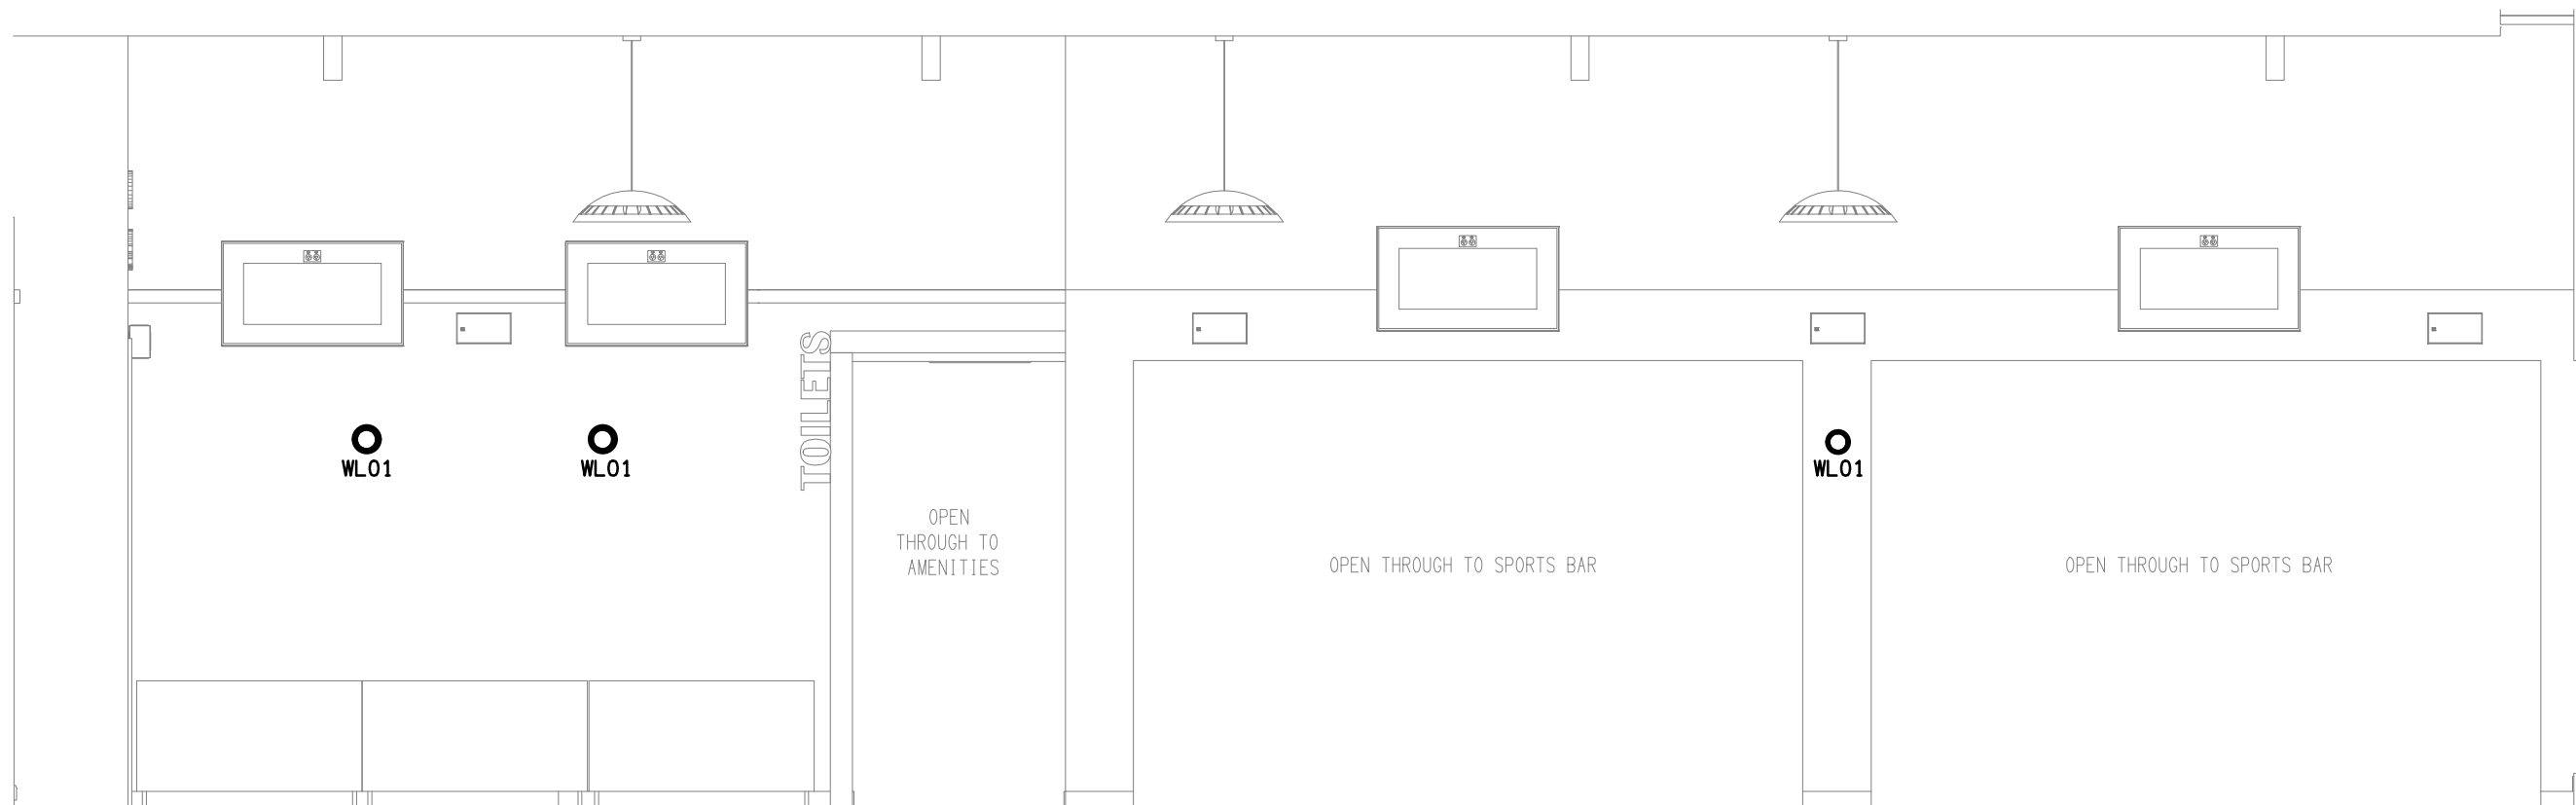

DETAIL G
DINING HALL ELEVATION 2
SCALE 1: 50

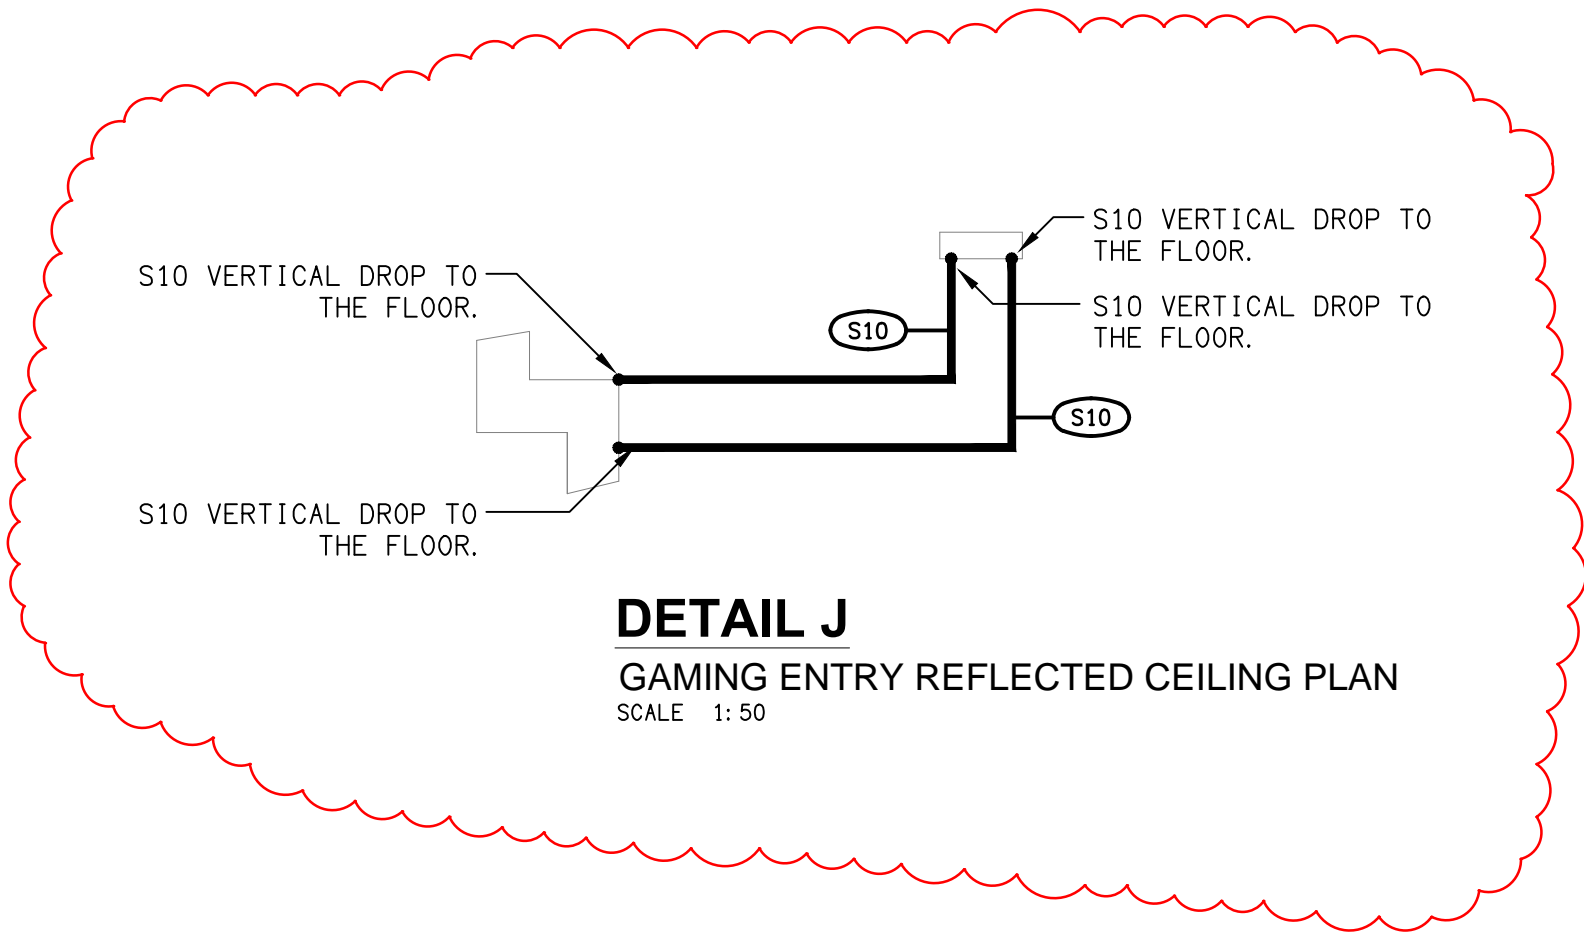

DETAIL J
GAMING ENTRY REFLECTED CEILING PLAN
SCALE 1: 50

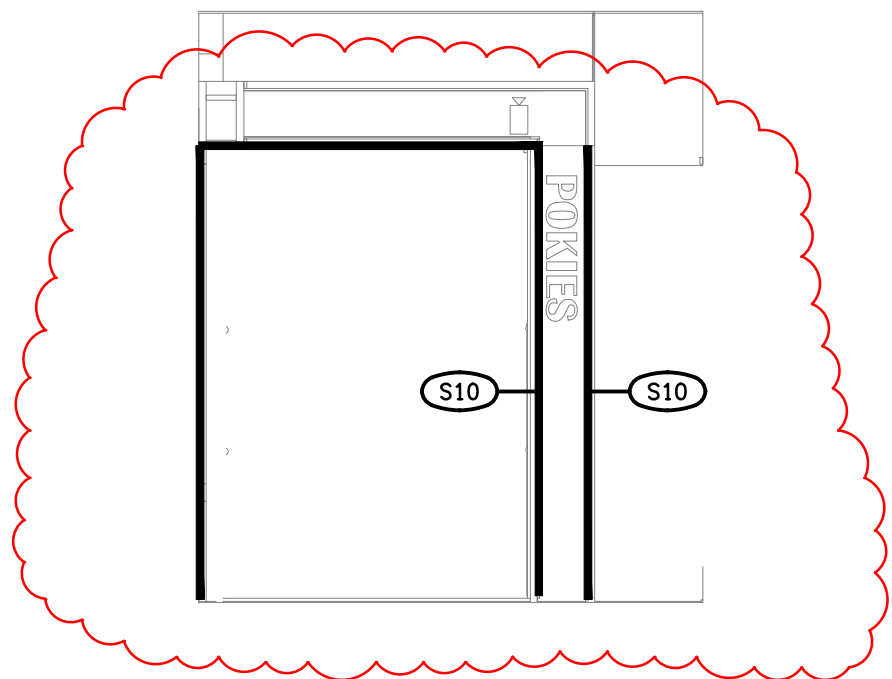

DETAIL J
GAMING ENTRY ELEVATION
SCALE 1: 50