



ELECTRICAL DESIGN GROUP

ELECTRICAL BUILDING SERVICES CONSULTANTS

P.O. Box 15, SHERWOOD Q. 4075

Phone: (07) 3278 4375

Website: www.edg.net.au Email: brisbane@edg.net.au

C3771a - HIGHFIELDS TAVERN

C3771a-0001(C).xls


ELECTRICAL SERVICES CONTRACT DOCUMENT SCHEDULE

REVISION C - 24 AUGUST 2026

ISSUING INFORMATION				DATE OF ISSUE							
	DAY	MONTH	YEAR	24	05	24					
				06	08	08					
				26	26	26					
				T	T	T					
REASON FOR ISSUE											
A = APPROVAL		C = CONSTRUCTION		N = COORDINATION		P = PRELIMINARY		T = TENDER			

DISTRIBUTION				NUMBER OF COPIES							
WWW.EDG.NET.AU				1E	1E	1E					
BSPN ARCHITECTURE				1E	1E	1E					
P = PRINT T = TRACING D = DISC E = EMAIL F = FAX											

DOCUMENTS		REVISION									
C3771a-E01.dwg	LEGEND & DETAILS	A	B								
C3771a-E02.dwg	NOTES	A	B								
C3771a-E03.dwg	FLOOR PLAN	A	B								
C3771a-E04.dwg	REFLECTED CEILING PLAN	A	B								
C3771a-E05.dwg	JOINERY & WALL LIGHTING PLAN	A	B								
C3771a-E06.dwg	JOINERY & WALL LIGHTING DETAILS		A								
C3771a-0001.xls	CONTRACT DOCUMENT SCHEDULE	A	B	C							
C3771a-0002.xls	EQUIPMENT SCHEDULE	A	B	C							
C3771a-0004.xls	LIGHTING CONTROL SCHEDULE	A	B	C							
C3771a-0005.xls	DISTRIBUTION BOARD DB-A SCHEDULE	A									
C3771a-0001.zip	FITTING & OUTLET DATASHEETS			A							

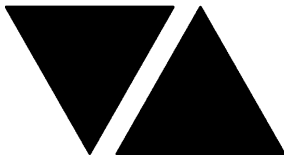

ELECTRICAL DESIGN GROUP

ELECTRICAL BUILDING SERVICES CONSULTANTS

P.O. Box 15, SHERWOOD Q. 4075

Phone: (07) 3278 4375 Fax: (07) 3716 0222

Web Site: www.edg.net.au Email: brisbane@edg.net.au

C3771a - HIGHFIELDS TAVERN


C3771a-0002(C).xls

ELECTRICAL EQUIPMENT SCHEDULE

REVISION C - 24 AUGUST 2026

THE LIGHT FITTING SUPPLIER CONTACT DETAILS MAY BE AVAILABLE ON THE EDG WEBSITE VIA THE FOLLOWING LINK
www.edg.net.au/Links/Lighting.htm

TYPE	LAMPS	DESCRIPTION	COLOUR / ACCESSORY	CATALOGUE No	REV
S1	14.4W/M 2700K LED	LED STRIP WITHIN A SCREW FIXED EXTRUSION C/W DIFFUSER BEHIND THE TV AS PER THE ARCHITECTURAL DETAIL AND ELEVATION. CONFIRM THE LENGTHS ON SITE. PROVIDE THE STRIP WITH REMOTE DALI DIMMABLE POWER SUPPLIES AS REQUIRED LOCATE THE POWER SUPPLIES IN A CONCEALED ACCESSIBLE POSITION NOTED ON THE AS CONSTRUCTED DOCUMENTS.	NATURAL	RAPID LED R2334 PLUS ALUMINIUM EXTRUSION AND POWER SUPPLY & DALI CONTROLLER	A
S2	14.4W/M 2700K LED	LED STRIP WITHIN A SCREW FIXED EXTRUSION C/W DIFFUSER WITHIN COUNTER FACE PELMET AS PER THE ARCHITECTURAL DETAIL. PROVIDE THE STRIP WITH REMOTE DALI DIMMABLE POWER SUPPLIES AS REQUIRED LOCATE THE POWER SUPPLIES IN A CONCEALED ACCESSIBLE POSITION NOTED ON THE AS CONSTRUCTED DOCUMENTS.	NATURAL	RAPID LED R2334 2700 K PLUS ALUMINIUM EXTRUSION OPAL DIFFUSER AND POWER SUPPLY & DALI CONTROLLER	A
S3	10W/M 2700K LED	IP67 LED FLEX SCREW FIXED RECESSED ONTO THE EXTERNAL SIGN AS PER THE ELEVATION / SECTION. MOUNT AS PER THE ARCHITECTURAL DETAIL. PROVIDE THE STRIP WITH A REMOTE POWER SUPPLY LOCATED IN A CONCEALED ACCESSIBLE POSITION NOTED ON THE AS CONSTRUCTED DOCUMENTS. CONFIRM THE BEND PLANE (TOP OR SIDE) ON SITE WITH THE ARCHITECT.	WHITE	RAPID LED R2321 OR R2322 - 2700K + POWER SUPPLY & DALI CONTROLLER	A
S4	14.4W/M 2700K LED	LED STRIP WITHIN A SCREW FIXED EXTRUSION C/W DIFFUSER WITHIN CEILING PELMET AS PER THE ARCHITECTURAL DETAIL. PROVIDE THE STRIP WITH REMOTE DALI DIMMABLE POWER SUPPLIES AS REQUIRED LOCATE THE POWER SUPPLIES IN A CONCEALED ACCESSIBLE POSITION NOTED ON THE AS CONSTRUCTED DOCUMENTS.	NATURAL	RAPID LED R2334 PLUS ALUMINIUM EXTRUSION AND POWER SUPPLY & DALI CONTROLLER	A
S5	14.4W/M 2700K LED	LED STRIP WITHIN A SCREW FIXED EXTRUSION C/W DIFFUSER WITHIN CEILING PELMET AS PER THE ARCHITECTURAL DETAIL. PROVIDE THE STRIP WITH REMOTE DALI DIMMABLE POWER SUPPLIES AS REQUIRED LOCATE THE POWER SUPPLIES IN A CONCEALED ACCESSIBLE POSITION NOTED ON THE AS CONSTRUCTED DOCUMENTS.	WHITE EXTRUSION	RAPID LED R2334 PLUS ALUMINIUM EXTRUSION AND POWER SUPPLY & DALI CONTROLLER	A

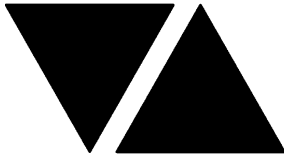

ELECTRICAL DESIGN GROUP

ELECTRICAL BUILDING SERVICES CONSULTANTS

P.O. Box 15, SHERWOOD Q. 4075

Phone: (07) 3278 4375 Fax: (07) 3716 0222

Web Site: www.edg.net.au Email: brisbane@edg.net.au

C3771a - HIGHFIELDS TAVERN


C3771a-0002(C).xls

ELECTRICAL EQUIPMENT SCHEDULE

REVISION C - 24 AUGUST 2026

THE LIGHT FITTING SUPPLIER CONTACT DETAILS MAY BE AVAILABLE ON THE EDG WEBSITE VIA THE FOLLOWING LINK
www.edg.net.au/Links/Lighting.htm

TYPE	LAMPS	DESCRIPTION	COLOUR / ACCESSORY	CATALOGUE No	REV
S6	10W/M 2700K LED	IP67 LED FLEX SCREW FIXED RECESSED ONTO THE GAMING CEILING FEATURE. MOUNT AS PER THE ARCHITECTURAL DETAIL. PROVIDE THE STRIP WITH REMOTE DALI DIMMABLE POWER SUPPLIES AS REQUIRED LOCATE THE POWER SUPPLIES IN A CONCEALED ACCESSIBLE POSITION NOTED ON THE AS CONSTRUCTED DOCUMENTS. CONFIRM THE BEND PLANE (TOP OR SIDE) ON SITE WITH THE ARCHITECT.	WHITE	RAPID LED R2321 OR R2322 - 2700K + POWER SUPPLY & DALI CONTROLLER	A
S7	14.4W/M 2700K LED	LED STRIP WITHIN A SCREW FIXED EXTRUSION C/W DIFFUSER WITHIN CEILING PELMET AS PER THE ARCHITECTURAL DETAIL. PROVIDE THE STRIP WITH REMOTE DALI DIMMABLE POWER SUPPLIES AS REQUIRED LOCATE THE POWER SUPPLIES IN A CONCEALED ACCESSIBLE POSITION NOTED ON THE AS CONSTRUCTED DOCUMENTS.	NATURAL	RAPID LED R2334 PLUS ALUMINIUM EXTRUSION AND POWER SUPPLY & DALI CONTROLLER	A
S8	10W/M 2700K LED	IP67 LED FLEX SCREW FIXED RECESSED ONTO THE ENTRY ROOF AS PER THE ARCHITECTURAL DETAIL. PROVIDE THE STRIP WITH REMOTE POWER SUPPLY LOCATED IN A CONCEALED ACCESSIBLE POSITION NOTED ON THE AS CONSTRUCTED DOCUMENTS. CONFIRM THE BEND PLANE (TOP OR SIDE) ON SITE WITH THE ARCHITECT.	WHITE	RAPID LED R2321 OR R2322 - 2700K + POWER SUPPLY & DALI CONTROLLER	A
S9	14.4W/M 2700K LED	MULTIPLE LED STRIP WITHIN A SCREW FIXED EXTRUSION C/W DIFFUSER RECESSED INTO THE REAR BAR JOINERY AS PER THE ELEVATION. MOUNT AS PER THE ARCHITECTURAL DETAIL. PROVIDE THE STRIP WITH REMOTE DALI DIMMABLE POWER SUPPLIES AS REQUIRED LOCATE THE POWER SUPPLIES IN A CONCEALED ACCESSIBLE POSITION NOTED ON THE AS CONSTRUCTED DOCUMENTS.	NATURAL	RAPID LED R2334 PLUS ALUMINIUM EXTRUSION AND POWER SUPPLY & DALI CONTROLLER	A
S10	14.4W/M 2700K LED	LED STRIP WITHIN A SCREW FIXED EXTRUSION C/W DIFFUSER WITHIN CURTAIN PELMET AS PER THE ARCHITECTURAL DETAIL. PROVIDE THE STRIP WITH REMOTE DALI DIMMABLE POWER SUPPLIES AS REQUIRED LOCATE THE POWER SUPPLIES IN A CONCEALED ACCESSIBLE POSITION NOTED ON THE AS CONSTRUCTED DOCUMENTS.	NATURAL	RAPID LED R2334 PLUS ALUMINIUM EXTRUSION AND POWER SUPPLY & DALI CONTROLLER	A

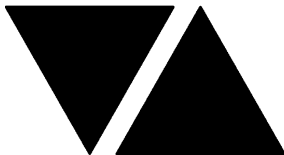

ELECTRICAL DESIGN GROUP

ELECTRICAL BUILDING SERVICES CONSULTANTS

P.O. Box 15, SHERWOOD Q. 4075

Phone: (07) 3278 4375 Fax: (07) 3716 0222

Web Site: www.edg.net.au Email: brisbane@edg.net.au

C3771a - HIGHFIELDS TAVERN


C3771a-0002(C).xls

ELECTRICAL EQUIPMENT SCHEDULE

REVISION C - 24 AUGUST 2026

THE LIGHT FITTING SUPPLIER CONTACT DETAILS MAY BE AVAILABLE ON THE EDG WEBSITE VIA THE FOLLOWING LINK
www.edg.net.au/Links/Lighting.htm

TYPE	LAMPS	DESCRIPTION	COLOUR / ACCESSORY	CATALOGUE No	REV
S11	14.4W/M 2700K LED	LED STRIP WITHIN A SCREW FIXED EXTRUSION C/W DIFFUSER WITHIN THE SERVERY SUSPENDED GANTRY AS PER THE ARCHITECTURAL DETAIL. PROVIDE THE STRIP WITH REMOTE DALI DIMMABLE POWER SUPPLIES AS REQUIRED LOCATE THE POWER SUPPLIES IN A CONCEALED ACCESSIBLE POSITION NOTED ON THE AS CONSTRUCTED DOCUMENTS.	WHITE EXTRUSION	RAPID LED R2334 PLUS ALUMINIUM EXTRUSION AND POWER SUPPLY & DALI CONTROLLER	A
S12	14.4W/M 2700K LED	LED STRIP WITHIN A SCREW FIXED EXTRUSION C/W DIFFUSER WITHIN THE LOWER STRUCTURE OF THE HIGH LEVEL GAMING ENTRY FEATURE TO UPLIGHT AS PER THE ARCHITECTURAL DETAIL. PROVIDE THE STRIP WITH REMOTE DALI DIMMABLE POWER SUPPLIES AS REQUIRED LOCATE THE POWER SUPPLIES IN A CONCEALED ACCESSIBLE POSITION NOTED ON THE AS CONSTRUCTED DOCUMENTS.	WHITE EXTRUSION	RAPID LED R2334 PLUS ALUMINIUM EXTRUSION AND POWER SUPPLY & DALI CONTROLLER	B
S13	14.4W/M 2700K LED	LED STRIP WITHIN A SCREW FIXED EXTRUSION C/W DIFFUSER WITHIN THE REAR JOINERY WINE BOTTLE DISPLAY AS PER THE ARCHITECTURAL DETAIL. PROVIDE THE STRIP WITH REMOTE DALI DIMMABLE POWER SUPPLIES AS REQUIRED LOCATE THE POWER SUPPLIES IN A CONCEALED ACCESSIBLE POSITION NOTED ON THE AS CONSTRUCTED DOCUMENTS.	WHITE EXTRUSION	RAPID LED R2334 PLUS ALUMINIUM EXTRUSION AND POWER SUPPLY & DALI CONTROLLER	B
S14	14.4W/M 2700K LED	FIVE HORIZONTAL RUNS OF LED STRIP WITHIN A SCREW FIXED EXTRUSION C/W DIFFUSER WITHIN THE TROPHY CABINET JOINERY WINE BOTTLE DISPLAY AS PER THE ARCHITECTURAL DETAIL. PROVIDE THE STRIP WITH REMOTE DALI DIMMABLE POWER SUPPLIES AS REQUIRED LOCATE THE POWER SUPPLIES IN A CONCEALED ACCESSIBLE POSITION NOTED ON THE AS CONSTRUCTED DOCUMENTS.	WHITE EXTRUSION	RAPID LED R2334 PLUS ALUMINIUM EXTRUSION AND POWER SUPPLY & DALI CONTROLLER	B
S15	14.4W/M 2700K LED	LED STRIP WITHIN A SCREW FIXED EXTRUSION C/W DIFFUSER WITHIN CEILING PELMET AS PER THE ARCHITECTURAL DETAIL. PROVIDE THE STRIP WITH REMOTE DALI DIMMABLE POWER SUPPLIES AS REQUIRED LOCATE THE POWER SUPPLIES IN A CONCEALED ACCESSIBLE POSITION NOTED ON THE AS CONSTRUCTED DOCUMENTS.	WHITE EXTRUSION	RAPID LED R2334 PLUS ALUMINIUM EXTRUSION AND POWER SUPPLY & DALI CONTROLLER	B
BL01	24W 3000K LED	REPLACE THE EXISTING BOLLARD WITH A NEW 1000 HIGH BOLLARD C/W INTEGRAL DRIVER PROVIDE A NEW CONCRETE FOOTING	BLACK	RAPID LED ZEUS-24 3000K	C

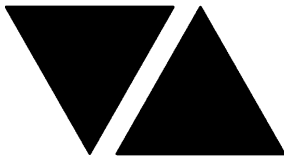

ELECTRICAL DESIGN GROUP

ELECTRICAL BUILDING SERVICES CONSULTANTS

P.O. Box 15, SHERWOOD Q. 4075

Phone: (07) 3278 4375 Fax: (07) 3716 0222

Web Site: www.edg.net.au Email: brisbane@edg.net.au

C3771a - HIGHFIELDS TAVERN


C3771a-0002(C).xls

ELECTRICAL EQUIPMENT SCHEDULE

REVISION C - 24 AUGUST 2026

THE LIGHT FITTING SUPPLIER CONTACT DETAILS MAY BE AVAILABLE ON THE EDG WEBSITE VIA THE FOLLOWING LINK
www.edg.net.au/Links/Lighting.htm

TYPE	LAMPS	DESCRIPTION	COLOUR / ACCESSORY	CATALOGUE No	REV
BL02	24W 3000K LED	NEW 1000 HIGH BOLLARD C/W INTEGRAL DRIVER AND CONCRETE FOOTING	BLACK	RAPID LED ZEUS-24 3000K	C
FS01	1W LED AT 500 CENTRES	FESTOON LIGHTS WITH NEW 24V DC IP65 FESTOON LIGHTING TO BE FIXED TO A 316 STAINLESS STEEL WIRE SUPPORT SYSTEM. SUPPLY THE NEW FESTOON LIGHTS VIA REMOTE DALI DIMMABLE DRIVERS IN A CONCEALED ACCESSIBLE POSITIONS NOTED ON THE AS CONSTRUCTED DOCUMENTS. CONFIRM THE LENGTH AND POSITION ON SITE	BLACK CABLE AND FIXINGS 316 STAINLESS STEEL SUPPORT AND FIXINGS	FIRE FLY FFC-LS-50-24VE27-BK	B
PD01	TRAILING EDGE DIMMABLE 27 9W 240 VOLT 2200K LED LAMP	DECORATIVE 360 HIGH X 120 DIA PENDANT. CONFIRM THE SUSPENSION HEIGHT ON SITE WITH THE ARCHITECT	OLD BRASS WHITE	LIGHTERIOR ELONG PENDANT LR.i02.25.OB + LR.A01.007.WH	A
PD02	TRAILING EDGE DIMMABLE 27 9W 240 VOLT 2200K LED LAMP	DECORATIVE 260 HIGH X 210 DIA PENDANT. CONFIRM THE SUSPENSION HEIGHT ON SITE WITH THE ARCHITECT	OLD BRASS WHITE	LIGHTERIOR GEO PENDANT LR.i02.25.OB + LR.A01.005.WH	A
PD03	TRAILING EDGE DIMMABLE 240 VOLT 2200K LED LAMP	DECORATIVE 600 LONG PENDANT. CONFIRM THE SUSPENSION HEIGHT ON SITE WITH THE ARCHITECT	DEEP RED	IN GOOD COMPANY FINE SUSPENSION LAMP	A
PD04	INTEGRAL 3000K 8W TRAILING EDGE DIMMABLE LED	DECORATIVE 316 HIGH X 60 DIA PENDANT. CONFIRM THE SUSPENSION HEIGHT ON SITE WITH THE ARCHITECT	MATT BRASS	LIGHTERIOR ISON PENDANT ARO.C1298/1/ORO	A
PD05	INTEGRAL 3000K 3W NON DIMMABLE LED	DECORATIVE 110 HIGH X 80 DIA PENDANT. CONFIRM THE SUSPENSION HEIGHT ON SITE WITH THE ARCHITECT	BRASS	LIGHTERIOR NEURON PENDANT LUX.NEURON.3W.BRS	C
WL01	TRAILING EDGE DIMMABLE 240 VOLT 2200K G9 LED 200 LUMENS +/- 10% 15,000 HOUR LIFE LAMP	DECORATIVE 160 DIA WALL LIGHT MOUNTED AS PER THE ARCHITECTURAL DETAILS	OLD BRASS	LIGHTERIOR DOME SUR WALL LIGHT LR.i01.54e.L.OB + LR.i01.54M.OB+ A03.DM.WH	C
WL02	INTEGRAL 3000K 4W TRAILING EDGE DIMMABLE LED	DECORATIVE 230 HIGH WALL LIGHT MOUNTED AS PER THE ARCHITECTURAL DETAILS	OLD BRASS	LIGHTERIOR EDGE WALL LIGHT LR.i01.75.OB + LR.A05.001.FR	A

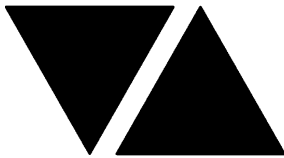

ELECTRICAL DESIGN GROUP

ELECTRICAL BUILDING SERVICES CONSULTANTS

P.O. Box 15, SHERWOOD Q. 4075

Phone: (07) 3278 4375 Fax: (07) 3716 0222

Web Site: www.edg.net.au Email: brisbane@edg.net.au

C3771a - HIGHFIELDS TAVERN


C3771a-0002(C).xls

ELECTRICAL EQUIPMENT SCHEDULE

REVISION C - 24 AUGUST 2026

THE LIGHT FITTING SUPPLIER CONTACT DETAILS MAY BE AVAILABLE ON THE EDG WEBSITE VIA THE FOLLOWING LINK
www.edg.net.au/Links/Lighting.htm

TYPE	LAMPS	DESCRIPTION	COLOUR / ACCESSORY	CATALOGUE No	REV
WL03	TRAILING EDGE DIMMABLE 240 VOLT 2200K G9 LED 200 LUMENS +/- 10% 15,000 HOUR LIFE LAMP	DECORATIVE 160 DIA WALL LIGHT MOUNTED AS PER THE ARCHITECTURAL DETAILS	RIVERGUM	LIGHTERIOR DISH WALL LIGHT RGA.225506	A
WL04	2 X TRAILING EDGE DIMMABLE 240 VOLT 2200K GU10 LED 200 LUMENS +/- 10% 15,000 HOUR LIFE LAMP	DECORATIVE 350 HIGH WALL LIGHT MOUNTED AS PER THE ARCHITECTURAL DETAILS	BRASS	LIGHTERIOR NIMAL WALL LIGHT NL.6N2310521035	A
WL05	TRAILING EDGE DIMMABLE 240 VOLT 2200K GU10 LED 200 LUMENS +/- 10% 15,000 HOUR LIFE LAMP	DECORATIVE 139 HIGH WALL LIGHT MOUNTED AS PER THE ARCHITECTURAL DETAILS	RUSTY	LIGHTERIOR KYKLOP CONE WALL LIGHT NL.6N2318071009	A
WL06	2 X TRAILING EDGE DIMMABLE 240 VOLT 2200K GU10 LED 200 LUMENS +/- 10% 15,000 HOUR LIFE LAMP	DECORATIVE 254 HIGH UP / DOWN WALL LIGHT MOUNTED AS PER THE ARCHITECTURAL DETAILS	RUSTY	LIGHTERIOR KYKLOP RIPPLE WALL LIGHT NL.6N2318051009	C
CL01	15W 3000K LED	SURFACE MOUNTED 100 DIA x 100 DEEP CAN DOWNLIGHT C/W REMOTE DALI DIMMABLE DRIVER	WHITE	LUMEN 8 SOL IDLSD	A
CL02	15W 3000K LED	75 DIA RECESSED ADJUSTABLE DOWNLIGHT C/W REMOTE DALI DIMMABLE DRIVER	WHITE	RAPID R1077-WH- 15W-WW-DALI	A
E1	LED	EMERGENCY LIGHT: RECESSED NON-MAINTAINED EMERGENCY LIGHT. AS2293 CLASSIFICATION C0-D40 - C90-D40.	WHITE	CLEVERTRONICS CLIFE	A
EX	LED	EXIT LIGHT : MAINTAINED 24M VIEWING DISTANCE EXIT LIGHT C/W DIFFUSERS & DIRECTIONAL ARROWS AS SHOWN. CEILING OR WALL MOUNT BETWEEN 2100mm & 2700mm AFFL IF THERE IS NO VERTICAL SURFACE TO MOUNT THE FITTING ON WITHIN THIS RANGE CONFIRM THE MOUNTING HEIGHT WITH THE ENGINEER. LITHIUM ION BATTERY	WHITE	CLEVERTRONICS CSBLED	A
CHANNEL x		CONTROL CHANNEL WITH A NUMERICAL REFERENCE. REFER TO THE POWER AND LIGHTING CONTROL SCHEDULE			A
LIGHTING CONTROL SWITCH PANEL 1 (SP1)		PROGRAMMABLE SWITCH PANEL C/W CENTRAL LCD DISPLAY MOUNTED AT 1000mm AFFL UNLESS NOTED OTHERWISE. BLANK OFF / REMOVE THE EXISTING ADJACENT MANUAL LIGHTING CONTROLS THAT BECOME REDUNDANT.	WHITE	ZEN CONTROL SSD	A

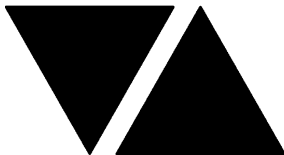

ELECTRICAL DESIGN GROUP

ELECTRICAL BUILDING SERVICES CONSULTANTS

P.O. Box 15, SHERWOOD Q. 4075

Phone: (07) 3278 4375 Fax: (07) 3716 0222

Web Site: www.edg.net.au Email: brisbane@edg.net.au

C3771a - HIGHFIELDS TAVERN

C3771a-0002(C).xls

ELECTRICAL EQUIPMENT SCHEDULE


REVISION C - 24 AUGUST 2026

THE LIGHT FITTING SUPPLIER CONTACT DETAILS MAY BE AVAILABLE ON THE EDG WEBSITE VIA THE FOLLOWING LINK
www.edg.net.au/Links/Lighting.htm

TYPE	LAMPS	DESCRIPTION	COLOUR / ACCESSORY	CATALOGUE No	REV
LIGHTING CONTROL SWITCH PANEL 2 (SP2)		PROGRAMMABLE SWITCH PANEL C/W CENTRAL LCD DISPLAY MOUNTED AT 1000mm AFFL UNLESS NOTED OTHERWISE. BLANK OFF / REMOVE THE EXISTING ADJACENT MANUAL LIGHTING CONTROLS THAT BECOME REDUNDANT.	WHITE	ZEN CONTROL SSD	A
LIGHTING CONTROL SWITCH PANEL 3 (SP3)		PROGRAMMABLE SWITCH PANEL C/W CENTRAL LCD DISPLAY MOUNTED AT 1000mm AFFL UNLESS NOTED OTHERWISE. BLANK OFF / REMOVE THE EXISTING ADJACENT MANUAL LIGHTING CONTROLS THAT BECOME REDUNDANT.	WHITE	ZEN CONTROL SSD	A
LIGHTING CONTROL SWITCH PANEL 4 (SP4)		PROGRAMMABLE SWITCH PANEL C/W CENTRAL LCD DISPLAY MOUNTED AT 1000mm AFFL UNLESS NOTED OTHERWISE. BLANK OFF / REMOVE THE EXISTING ADJACENT MANUAL LIGHTING CONTROLS THAT BECOME REDUNDANT.	WHITE	ZEN CONTROL SSD	A
SINGLE POWER OUTLET		SINGLE POWER OUTLET C/W CIRCUIT IDENTIFICATION ON THE FACEPLATE BEHIND THE SURROUND MOUNT AT 300mm AFFL U.N.O. RATING 10A U.N.O.	WHITE UNLESS NOTED AS BLACK (BK)	CLIPSAL C2000 SERIES	A
AUTO DOOR SINGLE POWER OUTLET (AD)		SINGLE POWER OUTLET C/W CIRCUIT IDENTIFICATION LOCATED CONCEALED WITHIN THE AUTO DOOR HEAD MULLION RATING 10A U.N.O.	WHITE	CLIPSAL C2000 SERIES	A
DOUBLE POWER OUTLET		DOUBLE POWER OUTLET C/W CIRCUIT IDENTIFICATION ON THE FACEPLATE BEHIND THE SURROUND MOUNT AT 300mm AFFL U.N.O. RATING 10A U.N.O.	WHITE UNLESS NOTED AS BLACK (BK)	CLIPSAL C2000 SERIES	A
FLOOR BOX (FB)		INSITU FLUSH FLOOR BOX C/W A DOUBLE GPO AND A 32 DIA COMMUNICATIONS CONDUIT TO THE ACCESSIBLE CEILING SPACES. PROVIDE THE GPOS AS PER THE STANDARD DESCRIPTIONS. PROVIDE CHASING WITHIN THE EXISTING FLOOR TO INSTALL THE CONDUITS AND FLOOR BOX.	STAINLESS STEEL	ECD FB2SHD	B
SIGN CONNECTION		COORDINATE THE LOCATION AND CONNECTION WITH THE SIGN CONTRACTOR ENSURING THE CONNECTION ARE PROVIDED WITH APPROPRIATE WEATHER PROTECTION AND ARE CONCEALED FROM VIEW.			A
DB-A		WALL MOUNTED DISTRIBUTION BOARD DB-A REFER TO THE NOTES AND DISTRIBUTION BOARD DB-A SCHEDULE FOR ADDITIONAL INFORMATION AND REQUIREMENTS. PROVIDE DB-A WITH A 4C+E 35mm SUBMAIN FROM A NEW 100A MCCB THE MSB. PROVIDE A SHOP DRAWING OF THE DB FOR APPROVAL.			A
DB-G		GAMING DISTRIBUTION BOARD AND ITS ASSOCIATED SUBMAIN TO BE PROVIDED BY THE GAMING ELECTRICIAN.			B
MSB		EXISTING MAIN SWITCHBOARD TO REMAIN. AND BE PROVIDED WITH A MCCB TO SUPPLY DB-A. ALL EXISTING SWITCHGEAR THAT BECOMES REDUNDANT IS TO BE REMOVED.			A

C3771a-0002(C).xls

Pages inc. any attach. 6 of 6

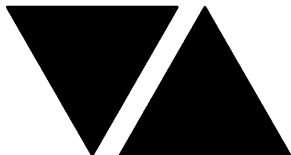

ELECTRICAL DESIGN GROUP

ELECTRICAL BUILDING SERVICES CONSULTANTS

P.O. Box 15, SHERWOOD Q. 4075

Phone: (07) 3278 4375 Fax: (07) 3716 0222

Web Site: www.edg.net.au Email: brisbane@edg.net.au


C3771a - HIGHFIELDS TAVERN

C3771a-0004(C).xls

LIGHTING CONTROL SCHEDULE

REVISION C - 24 AUGUST 2026


MISCELLANEOUS EQUIPMENT			REV
ITEM	DESCRIPTION		A
SP1	WALL MOUNTED WHITE ZENCONTROL SSD MOUNTED AT 1000 AFFL CONFIGURE THE CONTROLS AS PER THE NOTES		A
SP2	WALL MOUNTED WHITE ZENCONTROL SSD MOUNTED AT 1000 AFFL CONFIGURE THE CONTROLS AS PER THE NOTES		A
SP3	WALL MOUNTED WHITE ZENCONTROL SSD MOUNTED AT 1000 AFFL CONFIGURE THE CONTROLS AS PER THE NOTES		A
SP4	WALL MOUNTED WHITE ZENCONTROL SSD MOUNTED AT 1000 AFFL CONFIGURE THE CONTROLS AS PER THE NOTES		A
CONTROL MODULE 1			A
TYPE:		ZENCONTROL ZC-CONTROLLER-PRO-3	A
DESCRIPTION		3 LINE DALI APPLICATION CONTROLLER	A
LOCATION		DIN RAIL MOUNTED WITHIN DB-A	A
CHANNEL	CONTROL	CIRCUIT	A
A1	DALI DIM	DB-A - L1 AND L2	A
A2	DALI DIM	DB-A - L3 AND L4	A
A3	DALI DIM	DB-A - L5 AND L6	A
CONTROL MODULE 2			A
TYPE:		ZENCONTROL ZC-PSU	A
DESCRIPTION		DALI POWER SUPPLY	A
LOCATION		DIN RAIL MOUNTED WITHIN DB-A	A
CONTROL MODULE 3			A
TYPE:		ZENCONTROL ZC-PSU	A
DESCRIPTION		DALI POWER SUPPLY	A
LOCATION		DIN RAIL MOUNTED WITHIN DB-A	A
CONTROL MODULE 4			A
TYPE:		ZENCONTROL ZC-PSU	A
DESCRIPTION		DALI POWER SUPPLY	A
LOCATION		DIN RAIL MOUNTED WITHIN DB-A	A
CONTROL MODULE 5			A
TYPE:		ZENCONTROL ZC-CONTROLLER-PRO-3	A
DESCRIPTION		3 LINE DALI APPLICATION CONTROLLER	A
LOCATION		DIN RAIL MOUNTED WITHIN DB-A	A
BUS:		A	A
CHANNEL	CONTROL	CIRCUIT	A
A4	DALI DIM	DB-A - L7 AND L8	A
A5	DALI DIM	DB-A - L9 AND L10	A
A6	DALI DIM	DB-A - L11 AND L12	A
CONTROL MODULE 6			A
TYPE:		ZENCONTROL ZC-PSU	A
DESCRIPTION		DALI POWER SUPPLY	A
LOCATION		DIN RAIL MOUNTED WITHIN DB-A	A

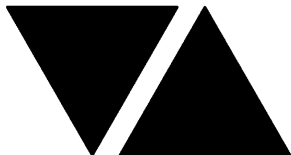

C3771a - HIGHFIELDS TAVERN
LIGHTING CONTROL SCHEDULE
REVISION C - 24 AUGUST 2026

C3771a-0004(C).xls

CONTROL MODULE 7				A
TYPE:		ZENCONTROL ZC-PSU		A
DESCRIPTION		DALI POWER SUPPLY		A
LOCATION		DIN RAIL MOUNTED WITHIN DB-A		A
CONTROL MODULE 8				A
TYPE:		ZENCONTROL ZC-PSU		A
DESCRIPTION		DALI POWER SUPPLY		A
LOCATION		DIN RAIL MOUNTED WITHIN DB-A		A
CONTROL MODULE 9				A
TYPE:		ZENCONTROL ZC-CONTROLLER-PRO-3		A
DESCRIPTION		3 LINE DALI APPLICATION CONTROLLER		A
LOCATION		DIN RAIL MOUNTED WITHIN DB-A		A
BUS:		A		A
CHANNEL	CONTROL	CIRCUIT		A
A7	DALI DIM	DB-A - L13		A
A8				A
A9				A
CONTROL MODULE 10				A
TYPE:		LUMILINK LL-D2PH-2C-DIN		A
DESCRIPTION		2 CHANNEL DALI TRAILING EDGE PHASE DIMMER		A
LOCATION		MOUNTED WITHIN DB-A		A
BUS:		A		A
CHANNEL	CONTROL	CIRCUIT		A
A10	TE DIM	DB-A - L14		A
A11				A
CONTROL MODULE 11				A
TYPE:		LUMILINK LL-D2PH-4C-DIN		A
DESCRIPTION		4 CHANNEL DALI TRAILING EDGE PHASE DIMMER		A
LOCATION		DIN RAIL MOUNTED WITHIN DB-A		A
CHANNEL	CONTROL	CIRCUIT		A
A12	TE DIM	DB-A - L15		A
A13	TE DIM			A
A14	TE DIM			A
A15	TE DIM			A
CONTROL MODULE 12				A
TYPE:		LUMILINK LL-D2PH-4C-DIN		A
DESCRIPTION		4 CHANNEL DALI TRAILING EDGE PHASE DIMMER		A
LOCATION		DIN RAIL MOUNTED WITHIN DB-A		A
CHANNEL	CONTROL	CIRCUIT		A
A16	TE DIM	DB-A - L16		C
A17	TE DIM			C
A18	TE DIM			C
A19	TE DIM			C

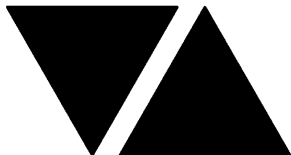

ELECTRICAL DESIGN GROUP

ELECTRICAL BUILDING SERVICES CONSULTANTS

P.O. Box 15, SHERWOOD Q. 4075

Phone: (07) 3278 4375 Fax: (07) 3716 0222

Web Site: www.edg.net.au Email: brisbane@edg.net.au

C3771a - HIGHFIELDS TAVERN

C3771a-0004(C).xls

LIGHTING CONTROL SCHEDULE

REVISION C - 24 AUGUST 2026

CONTROL MODULE 13					A
TYPE:		LUMILINK LL-D2PH-4C-DIN			A
DESCRIPTION		4 CHANNEL DALI TRAILING EDGE PHASE DIMMER			A
LOCATION		DIN RAIL MOUNTED WITHIN DB-A			A
CHANNEL	CONTROL	CIRCUIT			A
A20	TE DIM	DB-A - L17			C
A21	TE DIM				C
A22	TE DIM				C
A23	TE DIM				C
CONTROL MODULE 14					A
TYPE:		ZENCONTROL 4 CHANNEL DALI RELAY CONTROLLER			A
DESCRIPTION		4 CHANNEL DALI RELAY CONTROLLER			A
LOCATION		DIN RAIL MOUNTED WITHIN DB-A			A
CHANNEL	CONTROL	CIRCUIT			A
A24	SWITCH	DB-A - L18			A
A25	SWITCH				A
A26	SWITCH				A
A27	SWITCH				A
CONTROL MODULE 15					A
TYPE:		ZENCONTROL 4 CHANNEL DALI RELAY CONTROLLER			A
DESCRIPTION		4 CHANNEL DALI RELAY CONTROLLER			A
LOCATION		DIN RAIL MOUNTED WITHIN DB-A			A
CHANNEL	CONTROL	CIRCUIT			A
A28	SWITCH	DB-A - L19			A
A29	SWITCH				A
A30	SWITCH				A
A31	SWITCH				A
CONTROL MODULE 16					A
TYPE:		ZENCONTROL 4 CHANNEL DALI RELAY CONTROLLER			A
DESCRIPTION		4 CHANNEL DALI RELAY CONTROLLER			A
LOCATION		DIN RAIL MOUNTED WITHIN DB-A			A
CHANNEL	CONTROL	CIRCUIT			A
A32	SWITCH	DB-A - L20			A
A33	SWITCH				A
A34	SWITCH				A
A35	SWITCH				A
CONTROL MODULE 17					C
TYPE:		LUMILINK LL-D2PH-4C-DIN			C
DESCRIPTION		4 CHANNEL DALI TRAILING EDGE PHASE DIMMER			C
LOCATION		DIN RAIL MOUNTED WITHIN DB-A			C
CHANNEL	CONTROL	CIRCUIT			C
A36	TE DIM	DB-A - L15			C
A37	TE DIM				C
A38	TE DIM				C
A39	TE DIM				C



ELECTRICAL DESIGN GROUP

ELECTRICAL BUILDING SERVICES CONSULTANTS

P.O. Box 15, SHERWOOD Q. 4075

Phone: (07) 3278 4375

Website: www.edg.net.au Email: brisbane@edg.net.au

C3771a - HIGHFIELDS TAVERN











C3771a-0005(A).xls

DISTRIBUTION BOARD DB-A

REVISION A - 25 JUNE 2026


							REV
FAULT CURRENT:		6kA UTILISING CASCADING		MAIN SWITCH:		160A NON AUTO LOAD BREAK SWITCH	A
CHASSIS SIZE:		60 POLES		SUPPLIED FROM:		MSB	A
CHASSIS RATING:		250A		SUPPLY CABLE:		4C+E 35	A
PHASES:		3					A
PROVIDE THE DB WITH A FULL WIDTH EMPTY DIN RAIL TO ACCOMMODATE FUTURE CONTACTORS AND CONTROLS IN ADDITION TO THE INITIAL CONTROL EQUIPMENT. PROVIDE THE DB WITH AN AS2293 EMERGENCY LIGHTING CONTROL SYSTEM TO CONTROL THE ASSOCIATED EMERGENCY LIGHTS. PROVIDE THE DB WITH SURGE PROTECTION. PROVIDE A SHOP DRAWING INCLUDING THE LIGHTING CONTROL EQUIPMENT.							A
CIRC	PH	CIRCUIT BREAKER (amps)	CONTROL EQUIPMENT	CABLE SIZE (mm2)	LOCATION	CIRCUIT USE	A
P1	1	20	RCBO	2.5		TV	A
P2	1	20	RCBO	2.5		TV	A
P3	1	20	RCBO	2.5		TV	A
P4	1	20	RCBO	2.5		TV	A
P5	1	20	RCBO	2.5		AUTO DOOR	A
P6	1	20	RCBO	2.5		CLEANING	A
P7	1	20	RCBO	2.5		LED SCREEN	A
P8	1	20	RCBO	2.5		LED SCREEN	A
P9	1	20	RCBO	2.5		TV	A
P10	1	20	RCBO	2.5		ATM	A
P11	1	20	RCBO	2.5		TV	A
							A
							A
L1	1	20	RCBO	2.5		LIGHTING	A
L2	1	20	RCBO	2.5		LIGHTING	A
							A
							A
LEGEND

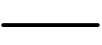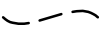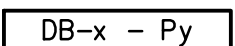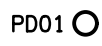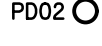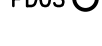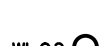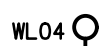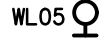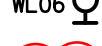-  ELECTRICAL SERVICES SWITCHBOARD.
-  SWITCHBOARD / CONTROL PANEL NOT PROVIDED AS PART OF THE ELECTRICAL SUBCONTRACT.
-  SINGLE POWER OUTLET.
-  DOUBLE POWER OUTLET.
-  EXIST  EXISTING POWER OUTLET TO REMAIN AS NOTED.
-  SIGNAGE CONNECTION.
-  RECESSED FLOOR BOX.
-  LIGHTING CONTROL SWITCHPANEL, TYPE x.
-  CIRCUIT LINE.
-  SWITCH LINE.
-  POWER CIRCUIT DESIGNATION. DENOTES DB AND CIRCUIT.
-  LIGHTING CONTROL CHANNEL REFERENCE.
-  ELECTRICAL EQUIPMENT AS NOTED.
-  REFER TO DETAIL NOTED FOR THE AREA SHOWN HATCHED. ADDITIONAL OUTLETS & FITTINGS MAY BE SHOWN ON DETAIL.
-  E1: GENERAL CEILING RECESSED LED EMERGENCY LIGHT, WHITE.
-  EX: EMERGENCY LED EXIT LIGHT, WHITE.
-  PD01: DECORATIVE SUSPENDED PENDANT.
-  PD02: DECORATIVE SUSPENDED PENDANT.
-  PD03: DECORATIVE SUSPENDED PENDANT.
-  PD04: DECORATIVE SUSPENDED PENDANT.
-  PD05: DECORATIVE SUSPENDED PENDANT.
-  WL01: DECORATIVE WALL LIGHT.
-  WL02: DECORATIVE WALL LIGHT.
-  WL03: DECORATIVE WALL LIGHT.
-  WL04: DECORATIVE WALL LIGHT.
-  WL05: DECORATIVE WALL LIGHT.
-  WL06: DECORATIVE WALL LIGHT.
-  FS01: FESTOON LIGHTS.
-  BL01: EXISTING BOLLARD LIGHT TO BE REPLACED.
-  BL02: NEW BOLLARD LIGHT.

LEGEND

-  CL01: SURFACE MOUNTED CAN DALI DIMMABLE DOWNLIGHT, WHITE.
-  CL02: 90 DIA RECESSED DALI DIMMABLE DOWNLIGHT, WHITE.
-  S1: WARM WHITE STRAIGHT LED STRIP LIGHT MOUNTED BEHIND THE FOUR SIDES OF THE TV.
-  S2: WARM WHITE STRAIGHT LED STRIP LIGHT MOUNTED WITHIN THE CEILING PELMET.
-  S3: WARM WHITE FLEXIBLE LED STRIP LIGHT MOUNTED WITHIN THE EXTERNAL SIGN STRUCTURE.
-  S4: WARM WHITE STRAIGHT LED STRIP LIGHT MOUNTED WITHIN THE CEILING PELMET.
-  S5: WARM WHITE STRAIGHT LED STRIP LIGHT MOUNTED WITHIN THE CEILING PELMET.
-  S6: WARM WHITE FLEXIBLE LED STRIP LIGHT MOUNTED WITHIN THE GAMING ROOM CEILING FEATURE PELMET.
-  S7: WARM WHITE STRAIGHT LED STRIP LIGHT MOUNTED WITHIN THE CEILING PELMET.
-  S8: WARM WHITE FLEXIBLE LED STRIP LIGHT MOUNTED WITHIN THE EXTERNAL ENTRY ROOF STRUCTURE.
-  S9: MULTIPLE WARM WHITE STRAIGHT LED STRIP LIGHTS MOUNTED WITHIN THE REAR BAR DISPLAY.
-  S10: WARM WHITE STRAIGHT LED STRIP LIGHT MOUNTED WITHIN THE GAMING CEILING CURTAIN PELMET.
-  S11: WARM WHITE STRAIGHT LED STRIP LIGHT MOUNTED WITHIN THE SUSPENDED SERVERY GANTRY.
-  S12: WARM WHITE STRAIGHT LED STRIP LIGHT MOUNTED WITHIN THE HIGH LEVEL GAMING ENTRY FEATURE AS AN UPLIGHT.
-  S13: WARM WHITE STRAIGHT LED STRIP LIGHT MOUNTED WITHIN THE FOUR SIDES OF THE WINE DISPLAY JOINERY.
-  S14: FIVE RUNS OF WARM WHITE STRAIGHT LED STRIP LIGHT MOUNTED WITHIN THE TROPHY CABINET.
-  S15: WARM WHITE STRAIGHT LED STRIP LIGHT MOUNTED WITHIN THE CEILING PELMET.

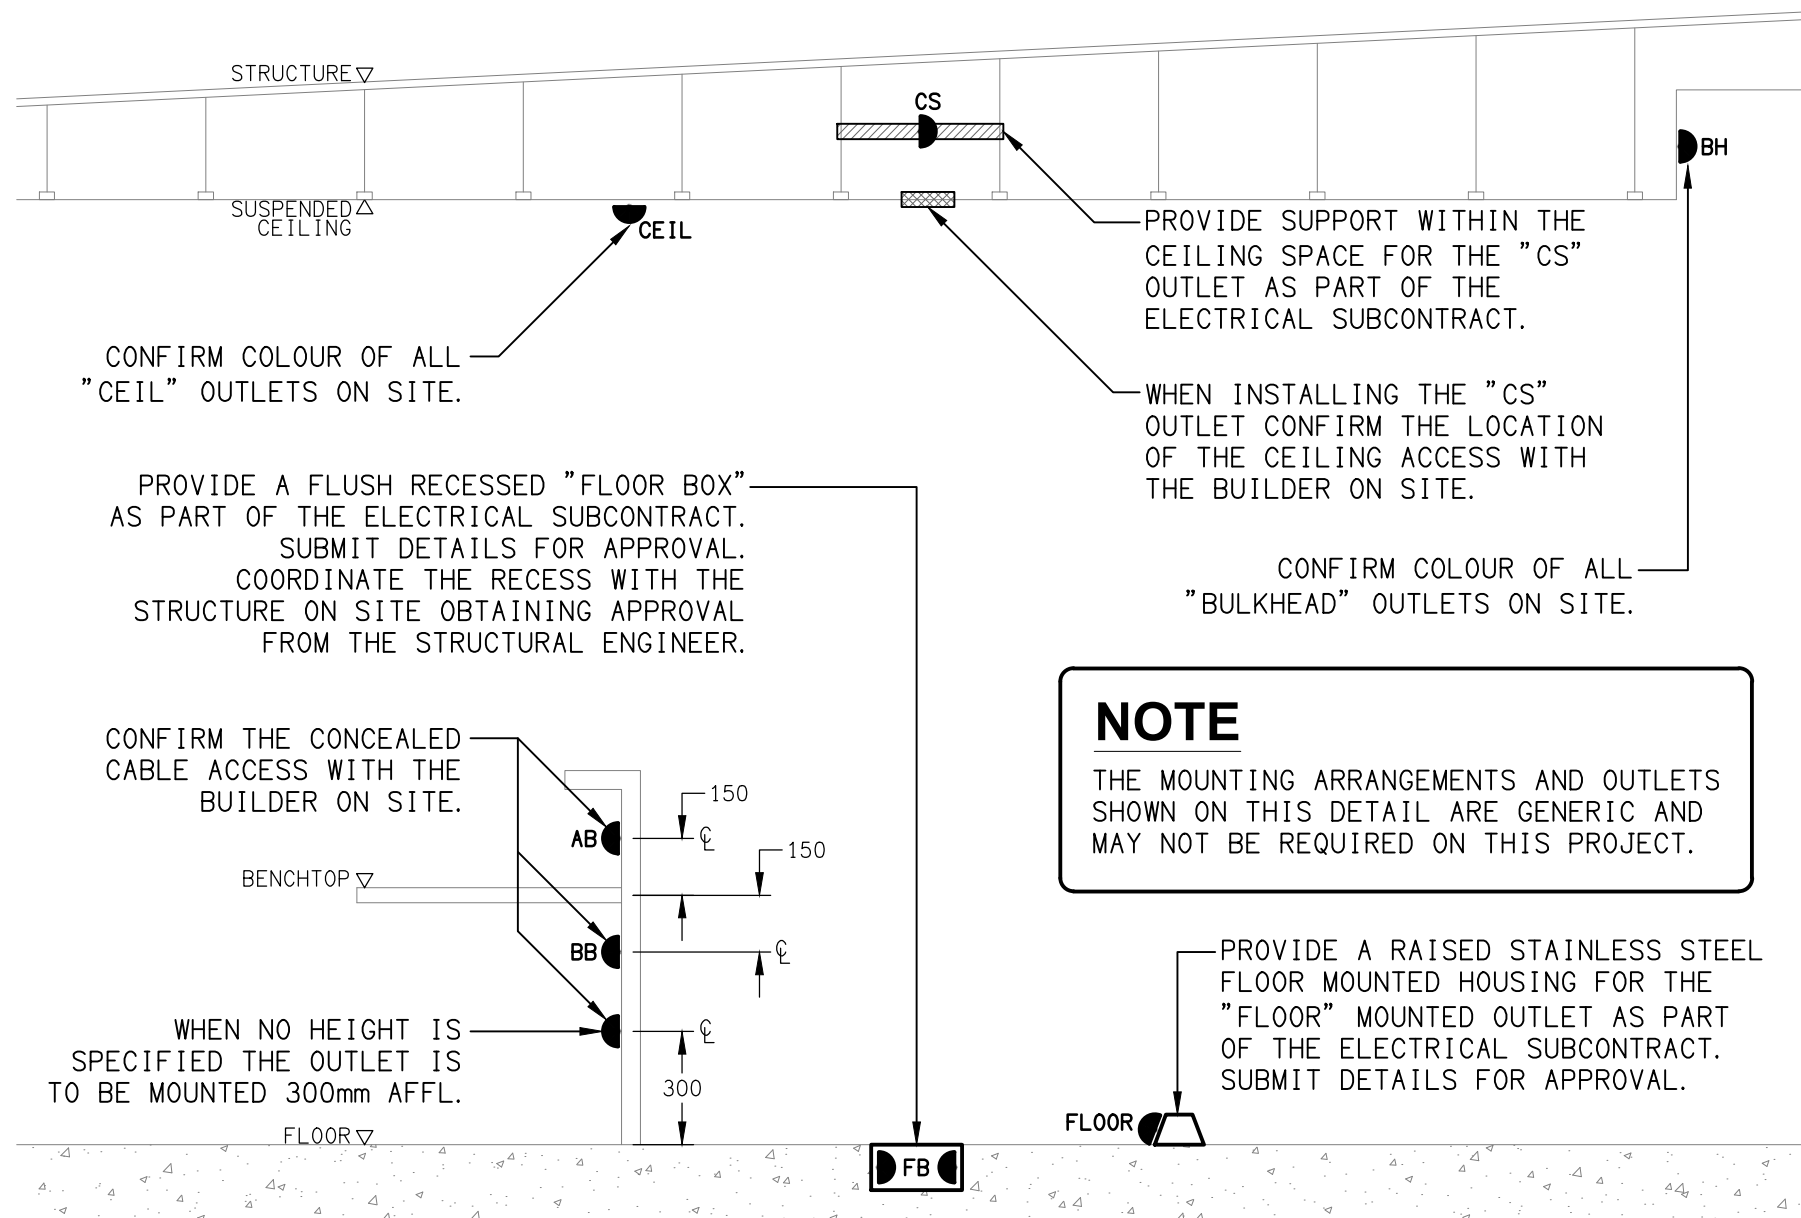

DETAIL
TYPICAL OUTLET MOUNTINGS
NOT TO SCALE

NOTES

1. EXTENT OF WORKS

THE ELECTRICAL SERVICES SUB-CONTRACT INCLUDES BUT IS NOT LIMITED TO THE FOLLOWING:

- SUPPLY AND INSTALLATION OF ALL COMPONENTS FORMING PART OF THE ELECTRICAL SERVICES.
- INSPECTIONS.
- TESTING AND COMMISSIONING.
- MAINTENANCE.
- CABLING, CABLE SUPPORT SYSTEMS AND ACCESS.
- POWER DISTRIBUTION.
- LIGHTING.
- MODIFICATION, RELOCATION AND EXTENSION AS NECESSARY OF ALL EXISTING SERVICES THAT ARE IMPACTED BY THE WORKS OR REQUIRED TO BE EXTENDED BY THE WORKS.
- REMOVAL OF ALL EXISTING SERVICES MADE REDUNDANT BY THE WORKS.
- DOCUMENTS.
- ANY TEMPORARY WORKS REQUIRED TO KEEP THE HOTEL OPERATING DURING THE CONSTRUCTION PROCESS AND ACCOMMODATE STAGING OF THE WORKS TO REFLECT THE EXECUTION OF THE MAIN CONTRACT WORKS.
- ALL MINOR COMPONENTS AND INCIDENTAL WORKS NOT SPECIFICALLY REFERRED TO, HOWEVER NECESSARY TO COMPLETE THE ELECTRICAL SERVICES INSTALLATION SUCH THAT IT IS HANDED OVER COMPLETE, OPERATIONAL AND FIT FOR THE INTENDED USE.

PRIOR TO COMMENCING WORK CONSULT SITE MANAGEMENT FOR ANY HAZARDOUS MATERIAL AND OR ASBESTOS REGISTERS AS WELL AS UNDERTAKE A THOROUGH INSPECTION OF THE SITE TO IDENTIFY ANY POTENTIAL HAZARDOUS MATERIALS, ASBESTOS AND HEALTH OR SAFETY RISKS. ADVISE THE CONTRACTOR OF ANY POTENTIAL HAZARDOUS MATERIALS, ASBESTOS AND HEALTH OR SAFETY RISKS IF IDENTIFIED AND DO NOT COMMENCE WORK UNTIL AN APPROPRIATE MANAGEMENT PLAN HAS BEEN DEVELOPED AND AGREED TO BY ALL PARTIES.

SUPPLY ALL LABOUR, MATERIALS, EQUIPMENT, AND ALL OTHER ITEMS, WHETHER MENTIONED IN DETAIL OR NOT, REQUIRED FOR THE SATISFACTORY COMPLETION OF THE ELECTRICAL SERVICES INSTALLATION, LEAVING IN FULL WORKING ORDER TO THE SATISFACTION OF THE PROJECT MANAGER.

ACCEPT FULL RESPONSIBILITY FOR LIASING, ARRANGING AND CO-ORDINATION OF ALL WORKS THAT HAVE AN EFFECT ON OR WILL BE AFFECTED BY THE ELECTRICAL SERVICES.

REFER TO THE EQUIPMENT SCHEDULE FOR ADDITIONAL REQUIREMENTS.

2. WORKMANSHIP

ENSURE THAT THE ELECTRICAL WORK IS PERFORMED BY THE HOLDER OF A CURRENT ELECTRICAL SUB CONTRACTOR LICENSE AND THE SERVICES COVERED BY THE ACMA IS PERFORMED BY THE HOLDER OF THE APPROPRIATE CURRENT ACMA LICENSE. ENSURE THE INSTALLATION AND ALL COMPONENTS, FIXTURES, FITTINGS, OUTLETS AND CABLES ARE SUPPLIED AND INSTALLED TO A HIGH STANDARD THROUGHOUT, AND INSTALLED IN A NEAT AND TRADESMAN LIKE MANNER, TO THE CURRENT INDUSTRY STANDARDS. ENSURE ALL MATERIALS AND COMPONENTS OF A SIMILAR TYPE ARE OF THE SAME MANUFACTURER AND INSTALLED IN A UNIFORM MANNER.

IT IS THE ELECTRICAL SUB CONTRACTOR'S RESPONSIBILITY TO ENSURE THAT THE INSTALLATION IS FIT FOR PURPOSE AND IS PROVIDED AS A COMPLETE WORKING INSTALLATION. IT IS THE ELECTRICAL SUB CONTRACTOR'S RESPONSIBILITY TO PROVIDE ALL COMPONENTS, FITTINGS, FIXTURES, SYSTEMS, PROGRAMMING ETC IRRESPECTIVE OF THE LEVEL DETAILED IN THE DOCUMENTS SUCH THAT THE INSTALLATION IS PROVIDED AS A COMPLETE WORKING INSTALLATION.

CONCEAL ALL WIRING AND CONDUITS. EXPOSED CABLING OR CONDUITS ARE GENERALLY NOT ACCEPTABLE. IT IS NOTED THAT CHASING AND REINSTATEMENT WILL BE REQUIRED. ENSURE ALL COMPONENTS, EQUIPMENT AND MATERIALS SUPPLIED ARE NEW, UNUSED, DESIGNED AND SELECTED TO ENSURE SATISFACTORY OPERATION UNDER VARYING ATMOSPHERIC, CLIMATIC, HUMID TROPICAL CONDITIONS WITHOUT DISTORTION AND DETERIORATION IN ANY PART AFFECTING EFFICIENCY AND RELIABILITY OF THE SYSTEMS. DESIGN AND SELECT ALL EQUIPMENT TO PROVIDE THE NECESSARY SAFETY TO HUMAN LIFE AND PROPERTY DURING OPERATION AND MAINTENANCE WITH PARTICULAR ATTENTION GIVEN TO ELECTRICAL SAFETY AND SEGREGATION PRECAUTIONS.

CHECK THE FINISHED PAINTWORK AROUND THE AREA OF EACH INSTALLATION AND TOUCH UP ALL DAMAGED PARTS AND FINISHES AFTER THE INSTALLATION OF THE ELECTRICAL SERVICES.

ALL WORKS ARE TO BE CARRIED OUT IN ACCORDANCE WITH THE BUILDER'S PROGRAM. ENSURE ALL FINAL LOCATIONS OF OUTLETS AND FITTINGS ARE CO-ORDINATED ONSITE WITH THE ARCHITECT AND ALL OTHER SERVICES, TO THE APPROVAL OF THE PROJECT MANAGER. ALLOW TO CO-ORDINATE THE FINAL LOCATION OF ALL EQUIPMENT, FITTINGS, & OUTLETS, SUCH THAT THEY ARE INSTALLED IN ACCORDANCE WITH THE AS3000 RESTRICTED ZONES, AND ARE NOT COVERED INAPPROPRIATELY.

ENSURE THAT ALL METAL SURFACES ARE SUITABLY PROTECTED AGAINST CORROSION, AND THAT ALL PLASTIC MATERIALS ARE UV STABILISED.

PROVIDE ALL MATERIALS AS NEW, AND OF THE HIGHEST CLASS AVAILABLE FOR THEIR RESPECTIVE TYPES. ENSURE ALL ASPECTS OF THE WORK ARE OF A HIGH STANDARD THROUGHOUT, AND INSTALLED IN A NEAT AND TRADESMAN LIKE MANNER, TO THE CURRENT INDUSTRY STANDARDS.

MODIFICATION, RELOCATION AND EXTENSION AS NECESSARY OF ALL EXISTING SERVICES THAT ARE IMPACTED BY THE WORKS OR REQUIRED TO BE EXTENDED BY THE WORKS.

PROVIDE ALL TEMPORARY WORKS REQUIRED TO KEEP THE VENUE AND ALL CONSTRUCTION STAGES OPERATING INCLUDING STAGED COMMISSIONING DURING THE CONSTRUCTION PROCESS.

ALL MINOR COMPONENTS AND INCIDENTAL WORKS NOT SPECIFICALLY REFERRED TO, HOWEVER NECESSARY TO COMPLETE THE ELECTRICAL SERVICES INSTALLATION SUCH THAT IT IS HANDED OVER COMPLETE, OPERATIONAL AND FIT FOR THE INTENDED USE.

CORRUGATED CONDUITS MUST NOT BE USED WITHIN ANY FOOD OR DRINK PREPARATION OR SERVERY AREAS.

CABLE JOINS ARE NOT ACCEPTABLE. ALL CABLING, WIRING, CONDUCTORS AND CONDUITS MUST BE CONCEALED. ALL EXISTING ELECTRICAL SERVICES INCLUDING CABLING AND SWITCHGEAR THAT IS FOUND TO BE REDUNDANT OR MADE REDUNDANT BY THE WORKS MUST BE REMOVED.

IT IS ACCEPTABLE TO USE EXISTING SWITCHGEAR, OUTLETS AND CABLING IF THEY ARE APPROPRIATELY RATED AND THE ELECTRICIAN ACCEPTS RESPONSIBILITY OVER THE SWITCHGEAR / OUTLETS / CABLE AND PROVIDES A WARRANTY OVER IT AS IF IT WAS INSTALLED NEW BY THE ELECTRICIAN.

3. STANDARDS

IRRESPECTIVE OF INFORMATION CONTAINED IN THE ELECTRICAL SERVICES DOCUMENTS OR IN INSTRUCTIONS, IT IS THE ELECTRICAL SUB CONTRACTORS RESPONSIBILITY TO ENSURE ALL ELECTRICAL SERVICES WORKS ARE INSTALLED IN ACCORDANCE WITH THE REQUIREMENTS OF THE FOLLOWING. REFER ANY DISCREPANCIES BETWEEN THE REQUIREMENTS OF THE FOLLOWING AND/OR THE ELECTRICAL SERVICES DOCUMENTS AND INSTRUCTIONS TO THE ARCHITECT FOR CLARIFICATION PRIOR TO THE PLACING OF ORDERS, FABRICATION OR INSTALLATION OF THE ITEMS/METHODS IN DISCREPANCY.

- NCC BUILDING CODE OF AUSTRALIA.
- ELECTRICITY ACT.
- ELECTRICAL SAFETY ACT.
- AS/NZS3000.
- AS3008.
- WORKPLACE HEALTH AND SAFETY ACT.
- TELECOMMUNICATIONS ACT.
- ACMA REQUIREMENTS.

NOTES

4. AUTHORITIES

ENSURE ALL OF THE ELECTRICAL SERVICES COMPLY WITH THE REQUIREMENTS OF ALL REGULATORY AUTHORITIES HAVING JURISDICTION OVER THE SITE INCLUDING BUT NOT LIMITED TO THE FOLLOWING:

- ACMA.
- LOCAL COUNCIL.
- LOCAL SUPPLY AUTHORITY.
- STATE GOVERNMENT DEPARTMENT OF ENVIRONMENT AND HERITAGE.
- QLD GOVERNMENT, DIVISION OF WORKPLACE, HEALTH AND SAFETY.
- QLD FIRE AND EMERGENCY SERVICES.

5. DOCUMENTATION

WITHIN TWO WEEKS OF PRACTICAL COMPLETION PROVIDE THE FOLLOWING DOCUMENTATION.

AS CONSTRUCTED DRAWINGS INCLUDING:

- ELECTRICIANS NAME AND CONTACT DETAILS.
- PROJECT NAME, ADDRESS AND DATE OF PRACTICAL COMPLETION.
- FITTING POSITIONS AND TYPES CROSS REFERENCED TO A FITTING / EQUIPMENT SCHEDULE.
- OUTLET, SWITCH, AND CONNECTION POSITIONS CROSS REFERENCED TO A FITTING / EQUIPMENT SCHEDULE.
- REMOTE DRIVER LOCATIONS.
- CIRCUITS CROSS REFERENCED TO A DISTRIBUTION BOARD SCHEDULE.
- LIGHTING CONTROL CHANNELS CROSS REFERENCED TO A LIGHTING CONTROL SCHEDULE.
- POWER SCHEMATIC.
- SWITCHBOARD SHOP DRAWINGS.
- CABLE ACCESS ROUTES.

A FITTING / EQUIPMENT SCHEDULE INCLUDING.

- FITTING DETAILS INCLUDING THE MANUFACTURERS CATALOGUE NUMBERS WITH THE TYPES CROSS REFERENCED TO THE AS CONSTRUCTED DRAWINGS.
- OUTLETS AND SWITCHES INCLUDING THE MANUFACTURERS CATALOGUE NUMBERS WITH THE TYPES CROSS REFERENCED TO THE AS CONSTRUCTED DRAWINGS.

DISTRIBUTION BOARD SCHEDULES CROSS REFERENCED TO THE AS CONSTRUCTED DRAWINGS.

LIGHTING CONTROL SCHEDULE CROSS REFERENCED TO THE AS CONSTRUCTED DRAWINGS.

PHOTOS OF EACH SWITCHBOARD INCLUDING:

- CLOSED POSITION SUCH THAT THE SWITCHBOARD DESIGNATION AND CLEARANCE IS VISIBLE.
- THE SUBMAIN LABEL.
- DOOR/S OPEN ESCUTCHEON/S CLOSED SUCH THAT THE SPARE CAPACITY AND LABELLING IS VISIBLE.
- DOOR/S OPEN ESCUTCHEON/S REMOVED SUCH THAT THE SWITCHGEAR AND INTERNAL CABLING IS VISIBLE.

6. CABLES

UNLESS OTHERWISE SPECIFIED, INSTALL AND TERMINATE CABLES IN ACCORDANCE WITH THE MANUFACTURERS' RECOMMENDATIONS. DETERMINE THE FINAL ROUTES TO SUIT THE BUILDING STRUCTURE AND SITE CONDITIONS. UNLESS NOTED OTHERWISE, PROVIDE ALL 240 VOLT POWER AND LIGHTING WIRING AS 2.5mm² TWIN & EARTH STRANDED COPPER CONDUCTORS, PVC INSULATED 0.6/1kV V75 GRADE TO AS3174, PROTECTED BY A 20 AMP CIRCUIT BREAKER. ALL CONDUIT AND FITTINGS TO BE RIGID UPVC TO AS2053, UNLESS NOTED OTHERWISE.

7. POWER DISTRIBUTION

REMOVE ALL EXISTING CIRCUITS THAT BECOME REDUNDANT BY THE WORKS. PROVIDE THE EXISTING MSB WITH A 100 AMP MOLDED CASE CIRCUIT BREAKER TO PROTECT A NEW 4C+E 35MM² CU XLPE /PVC SUBMAIN RUN TO DB-A. PROVIDE DB-A AS PER THE EQUIPMENT SCHEDULE AND THE DB-A SCHEDULE.

THE EXISTING TAB LOAD CENTRE IS TO BE REMOVED.

ANY INTERRUPTION TO THE POWER SUPPLY TO ANY SERVICES OUTSIDE OF THE AREA OF WORKS MUST BE RESTRICTED TO OUTSIDE OF THE HOTELS OPERATING HOURS AND MUST BE ADVISED TO THE OPERATOR IN WRITING AT LEAST ONE WEEK PRIOR.

ALL CIRCUIT BREAKERS AND CIRCUIT SCHEDULES MUST BE LABELLED / CONTAIN THE SUBMAIN / CIRCUIT USE AND LOCATION SUCH THAT THE CONNECTION / OUTLET CAN BE SIMPLY IDENTIFIED.

OUTLETS ARE TO BE PROVIDED WITH A NEAT HAND WRITTEN CIRCUIT DESIGNATION BY INDELIBLE INK ON THE FACEPLATE SUCH THAT IT IS NOT VISIBLE WHEN THE COVER IS CONCEALED.

ENSURE ALL THREE PHASE CIRCUITS ARE PROVIDED WITH CORRECT PHASE ROTATION.

ENSURE ALL OUTLETS AND ISOLATORS ARE POSITIONED SUCH THAT THEY ARE NOT COVERED BY THE EQUIPMENT. THE FINAL POSITION OF ALL OUTLETS AND ISOLATORS ARE TO BE CONFIRMED ON SITE BY THE TENANTS REPRESENTATIVE.

NOTES

8. GAMING

THE GAMING ELECTRICIAN WILL BE ENGAGED DIRECTLY BY ENDEAVOUR GROUP TO UNDERTAKE THE FOLLOWING:

- COMMUNICATIONS CABLING.
- GAMING DB.
- CIRCUIT BREAKER IN DB-A AND CIRCUIT TO THE GAMING DB (DB-G).
- CIRCUITS FROM THE GAMING DB AS NECESSARY TO:
 - GAMING MACHINES.
 - GAMING MODEMS.
 - GAMING MACHINE SIGNAGE.
 - GAMING ROOM CRTS.
 - TAB OUTLETS.
- GAMING ROOM CABLE ACCESS EXCLUDING FLOOR CHASES AND REINSTATEMENT OF THE FLOOR CHASES.

ALL OTHER REMAINING ELECTRICAL SERVICES WITHIN THE GAMING ROOM ARE TO BE PROVIDED AS PART OF THE BUILDING WORKS ELECTRICAL SUB CONTRACT.

9. LIGHTING

ALL FRONT OF HOUSE LIGHTING IS TO BE 2,700K OR 3,000K AND THE BACK OF HOUSE LIGHTING IS TO BE 4,000K.

UNLESS A FITTING HAS BEEN SPECIFIED IN THE EQUIPMENT SCHEDULE THAT CONTAINS A MAIN VOLTAGE LAMP, ALL LIGHT FITTINGS MUST BE PROVIDED AS SOLID-STATE LED WITH A FIVE-YEAR MANUFACTURERS REPLACEMENT WARRANTY AND A MINIMUM TWO YEAR MANUFACTURERS REPLACEMENT AND LABOUR WARRANTY.

ALL FRONT OF HOUSE LIGHTS THAT DO NOT CONTAIN A MAIN VOLTAGE LAMP ARE TO BE DALI DIMMABLE.

REMOTE DRIVERS ARE TO BE USED IF POSSIBLE AND LOCATED IN A CONCEALED ACCESSIBLE POSITION. IF THE DRIVER CAN NOT BE REACHED FROM THE FITTING ITS POSITION MUST BE NOTED ON THE AS CONSTRUCTED DOCUMENTS.

ALL FRONT OF HOUSE LIGHTS THAT CONTAIN MAIN VOLTAGE LAMPS ARE TO BE PROVIDED WITH THE LOWEST OUTPUT PRACTICAL TO ACHIEVE THE REQUIRED ILLUMINATION / EFFECT AND BE TRAILING EDGE PHASE DIMMABLE.

ALL ILLUMINATED SIGNAGE, GAMING BASE FOOTREST LEDS, CARPARK LIGHTS, AND EXTERNAL SECURITY LIGHTS NOT CONSIDERED FRONT OF HOUSE ARE TO BE SWITCHED.

ALL LIGHTING CIRCUITS MUST BE PROTECTED BY A 20 AMP RCBO WITH THE AVERAGE NUMBER OF FITTINGS / DRIVERS SUPPLIED FROM A SINGLE CIRCUIT NOT EXCEEDING 25 WITH THE MAXIMUM NOT EXCEEDING 30.

PROVIDE A ZEN CONTROL LIGHTING CONTROL SYSTEM TO CONTROL THE LIGHTING CONFIGURED WITH THE FOLLOWING SCENES:

INTERNAL

- CLEANING – MANUAL OPERATION. 100% LIGHTS ON AND SIGNS OFF.
- DAY – AUTOMATIC OPERATION FROM 10.00 AM TO 3.30 PM.
- AFTERNOON – AUTOMATIC OPERATION FROM 3.30 PM TO DUSK.
- EVENING – AUTOMATIC OPERATION FROM DUSK TO 8.30 PM.
- NIGHT – AUTOMATIC OPERATION FROM 8.30 PM TO CLOSING.
- CLOSED – MANUAL OPERATION. 100% ON FOR 15 MINUTES THEN TO A SECURITY MODE.

EXTERNAL

- DAY – AUTOMATICALLY OFF FROM DAWN TO DUSK.
- NIGHT – AUTOMATICALLY ON FROM DUSK UNTIL 15 MINUTES PAST CLOSING.
- CLOSED – MANUAL OPERATION. NIGHT MODE FOR 15 MINUTES THEN TO A SECURITY MODE.

SET THE ILLUMINATION LEVELS IN CONSULTATION WITH THE VENUE MANAGER AND OBTAIN WRITTEN APPROVAL FROM THE VENUE MANAGER OF THEIR ACCEPTANCE OF THE ILLUMINATION SCENE LEVELS FOR EACH STAGED HANDOVER AND SUBMIT A COPY OF THE APPROVAL TO THE ARCHITECT.

EACH FUNCTIONAL AREA IS TO BE PROVIDED WITH A SWITCHPANEL IN A NON-CUSTOMER ACCESSIBLE POSITION WITH THE ABILITY TO MANUALLY INSTIGATE THE ABOVE SCENES.

DIN RAIL MOUNT THE PHILIPS DYNALITE CONTROL EQUIPMENT WITHIN THE ASSOCIATED SWITCHBOARD.

ALL OF THE LIGHT FITTINGS, LAMPS AND ACCESSORIES ARE TO BE PROVIDED AS PART OF THIS CONTRACT. THE LIGHTING COMPONENT OF THIS CONTRACT INCLUDES, BUT IS NOT LIMITED TO THE FOLLOWING EXTENT OF WORK:

- LIGHTING.
- LIGHT FITTINGS AND ACCESSORIES.
- EMERGENCY AND EXIT LIGHTING.
- EARTHING OF THE LIGHTING INSTALLATION.
- LIGHTING CONTROL.
- ZEN CONTROL LIGHTING CONTROL SYSTEM.
- LIGHTING SUBCIRCUITS.
- TESTING AND COMMISSIONING.
- RECONNECTION OF THE EXISTING LIGHTING THAT REMAINS.
- REMOVAL OF ALL EXISTING REDUNDANT LIGHTING SERVICES INCLUDING THE REDUNDANT LIGHTING CONTROL SYSTEM.

COMMISSION THE LIGHTING CONTROL AT PRACTICAL COMPLETION AND AGAIN THREE TIMES DURING THE DEFECTS AND LIABILITY PERIOD TO THE SATISFACTION OF THE OPERATOR.

NOTES

10. EMERGENCY AND EXIT LIGHTING

PROVIDE A SINGLE POINT EMERGENCY LIGHTING SYSTEM THAT COMPLIES WITH THE LATEST ISSUE OF ALL PARTS AS2293 AND THE RELEVANT PARTS OF THE NCC BCA. INSTALL EMERGENCY LIGHT FITTINGS NOMINATED AS MAINTAINED WITH THE LAMP PERMANENTLY ON SUPPLIED VIA AN UNSWITCHED ACTIVE MAINS SUPPLY WHEN THE MAINS SUPPLY IS AVAILABLE. WHEN THE MAINS SUPPLY IS NOT AVAILABLE, THE LAMP IS TO REMAIN ON SUPPLIED BY THE EMERGENCY PACK. SINGLE LAMP MAINTAINED EMERGENCY LIGHTS ARE NOT SWITCHED WITH THE LOCAL GENERAL AREA LIGHTING. (THE LAMP IS ALWAYS ON.)

INSTALL EMERGENCY LIGHT FITTINGS NOMINATED AS NON-MAINTAINED AS FOLLOWS:

- IF THE FITTING IS NOT BEING SWITCHED, THE LAMP IS TO REMAIN OFF WHEN THE MAINS SUPPLY IS AVAILABLE. WHEN THE MAINS SUPPLY IS NOT AVAILABLE THE LAMP IS TO BE SWITCHED ON SUPPLIED BY THE EMERGENCY PACK. UNSWITCHED SINGLE LAMP NON-MAINTAINED EMERGENCY LIGHTS ARE NOT SWITCHED WITH THE LOCAL GENERAL AREA LIGHTING. (THE LAMP IS ON ONLY WHEN THE MAINS SUPPLY IS NOT AVAILABLE.)
- IF THE FITTING IS BEING SWITCHED, THE LAMP IS TO BE SUPPLIED AND CONTROLLED WITH THE LOCAL GENERAL AREA LIGHTING WHEN THE MAINS SUPPLY IS AVAILABLE. WHEN THE MAINS SUPPLY IS NOT AVAILABLE THE LAMP IS TO BE SWITCHED ON, SUPPLIED BY THE EMERGENCY PACK. (THE LAMP IS ON WHEN TURNED ON WITH THE LOCAL GENERAL LIGHTING OR THE MAIN SUPPLY IS NOT AVAILABLE.)

INSTALL EMERGENCY LIGHTS SUCH THAT THE STATUS INDICATOR L.E.D. IS CLEARLY VISIBLE AND THE TEST BUTTONS ARE READILY ACCESSIBLE. LABEL EACH CIRCUIT BREAKER WHICH CONTROLS THE UNSWITCHED ACTIVE TO EXIT LIGHTS WITH A LABEL FIXED ADJACENT; ENGRAVED PLASTIC LAMINATE, GREEN BACKGROUND WITH WHITE CHARACTERS: –

WARNING
INTERRUPTING SUPPLY WILL DISCHARGE
EMERGENCY LIGHTING BATTERIES

PROVIDE WRITTEN EVIDENCE OF THE INITIAL COMMISSIONING AND TESTING AND TESTING FOR THE DURATION OF THE MAINTENANCE PERIOD IN ACCORDANCE WITH AS 2293.2.


THIS EVIDENCE IS TO BE IN THE FORM OF A LOG BOOK SIMILAR TO THE GENERAL LIGHTING SERVICE PTY LTD "EMERGENCY LIGHTING MAINTENANCE LOG BOOK AND MANUAL" WHICH IS TO BE PROVIDED BY THE ELECTRICAL SUB-CONTRACTOR AND HAVE ALL ENTRIES FULLY COMPLETED AND BE PRESENTED FOR INSPECTION AT PRACTICAL COMPLETION. THE LOG BOOK IS TO BE RETAINED BY THE ELECTRICAL SUB-CONTRACTOR FOR THE DURATION OF THE MAINTENANCE PERIOD, AND THE SIX MONTHLY TEST AND MAINTENANCE RESULTS ENTERED. THE LOG BOOK IS TO BE PRESENTED FOR APPROVAL AT FINAL COMPLETION (EXPIRY OF THE MAINTENANCE PERIOD) AND WILL BE FORWARDED TO THE OPERATOR FOR THEIR USE.


PROVIDE MAINTENANCE OF THE EMERGENCY AND EXIT LIGHTING INSTALLATION INCLUDING RECORDS IN ACCORDANCE WITH THE LATEST ISSUE OF ALL PARTS AS2293 AND THE RELEVANT PARTS OF THE NCC BCA. PROVIDE THE EMERGENCY LIGHTING SYSTEM WITH A SUPPLY SENSING AND TESTING FACILITY IN ACCORDANCE WITH AS 2293.1.

11. ABBREVIATIONS


A – AMP CURRENT RATING
AB – MOUNT ABOVE BENCH.
AFFL – ABOVE FINISHED FLOOR LEVEL.
BB – MOUNT BELOW BENCH.
BH – MOUNT ON BULKHEAD.
CEIL – MOUNT ON CEILING.
CS – MOUNT WITHIN CEILING SPACE.
C/W – COMPLETE WITH.
DW – DISHWASHER.
MCB – MINIATURE CIRCUIT BREAKER.
MCCB – MOLDED CASE CIRCUIT BREAKER.
MSB – MAIN SWITCHBOARD.
MSSB – MECHANICAL SERVICES SWITCHBOARD.
MW – MICROWAVE.
N – NEON / LED INDICATOR WHEN ON.
NTS – NOT TO SCALE.
RCBO – CIRCUIT BREAKER C/W AN INTEGRAL 30mA RESIDUAL CURRENT DEVICE.
RCD – CIRCUIT PROTECTED VIA A 30mA RESIDUAL CURRENT DEVICE.
REF – REFRIGERATOR.
UNO – UNLESS NOTED OTHERWISE.
WP – WEATHERPROOF TO IP56 UNO.
500 – NUMBER DENOTES MOUNTING HEIGHT AFFL.

ELECTRICAL DESIGN GROUP BRISBANE PTY LTD ACN 092 710 793 TRADING AS: ELECTRICAL DESIGN GROUP		THE COPYRIGHT OF THIS DRAWING REMAINS THE PROPERTY OF THE ELECTRICAL DESIGN GROUP. USE FIGURED DIMENSIONS IN PREFERENCE TO SCALE. ALL DIMENSIONS TO BE VERIFIED ONSITE.	ELECTRICAL DESIGN GROUP ELECTRICAL BUILDING SERVICES CONSULTANTS BRISBANEGOLD COAST P.O.Box 15, Sherwood Q.4075 Phone: (07) 3278 4375 Email: brisbane@edg.net.au Web: www.edg.net.au	PROJECT: HIGHFIELDS TAVERN CORNER O'BRIEN & 12 HIGHFIELDS ROAD, HIGHFIELDS QLD	B TENDER REV:DESCRIPTION: 05/08/2026 DATE: DRAWING: ELECTRICAL SERVICES NOTES SCALE: NOT TO SCALE AT A1 PROJECT NO: C3771a DRAWING NO: E02 REVISION: B
--	--	--	--	--	---

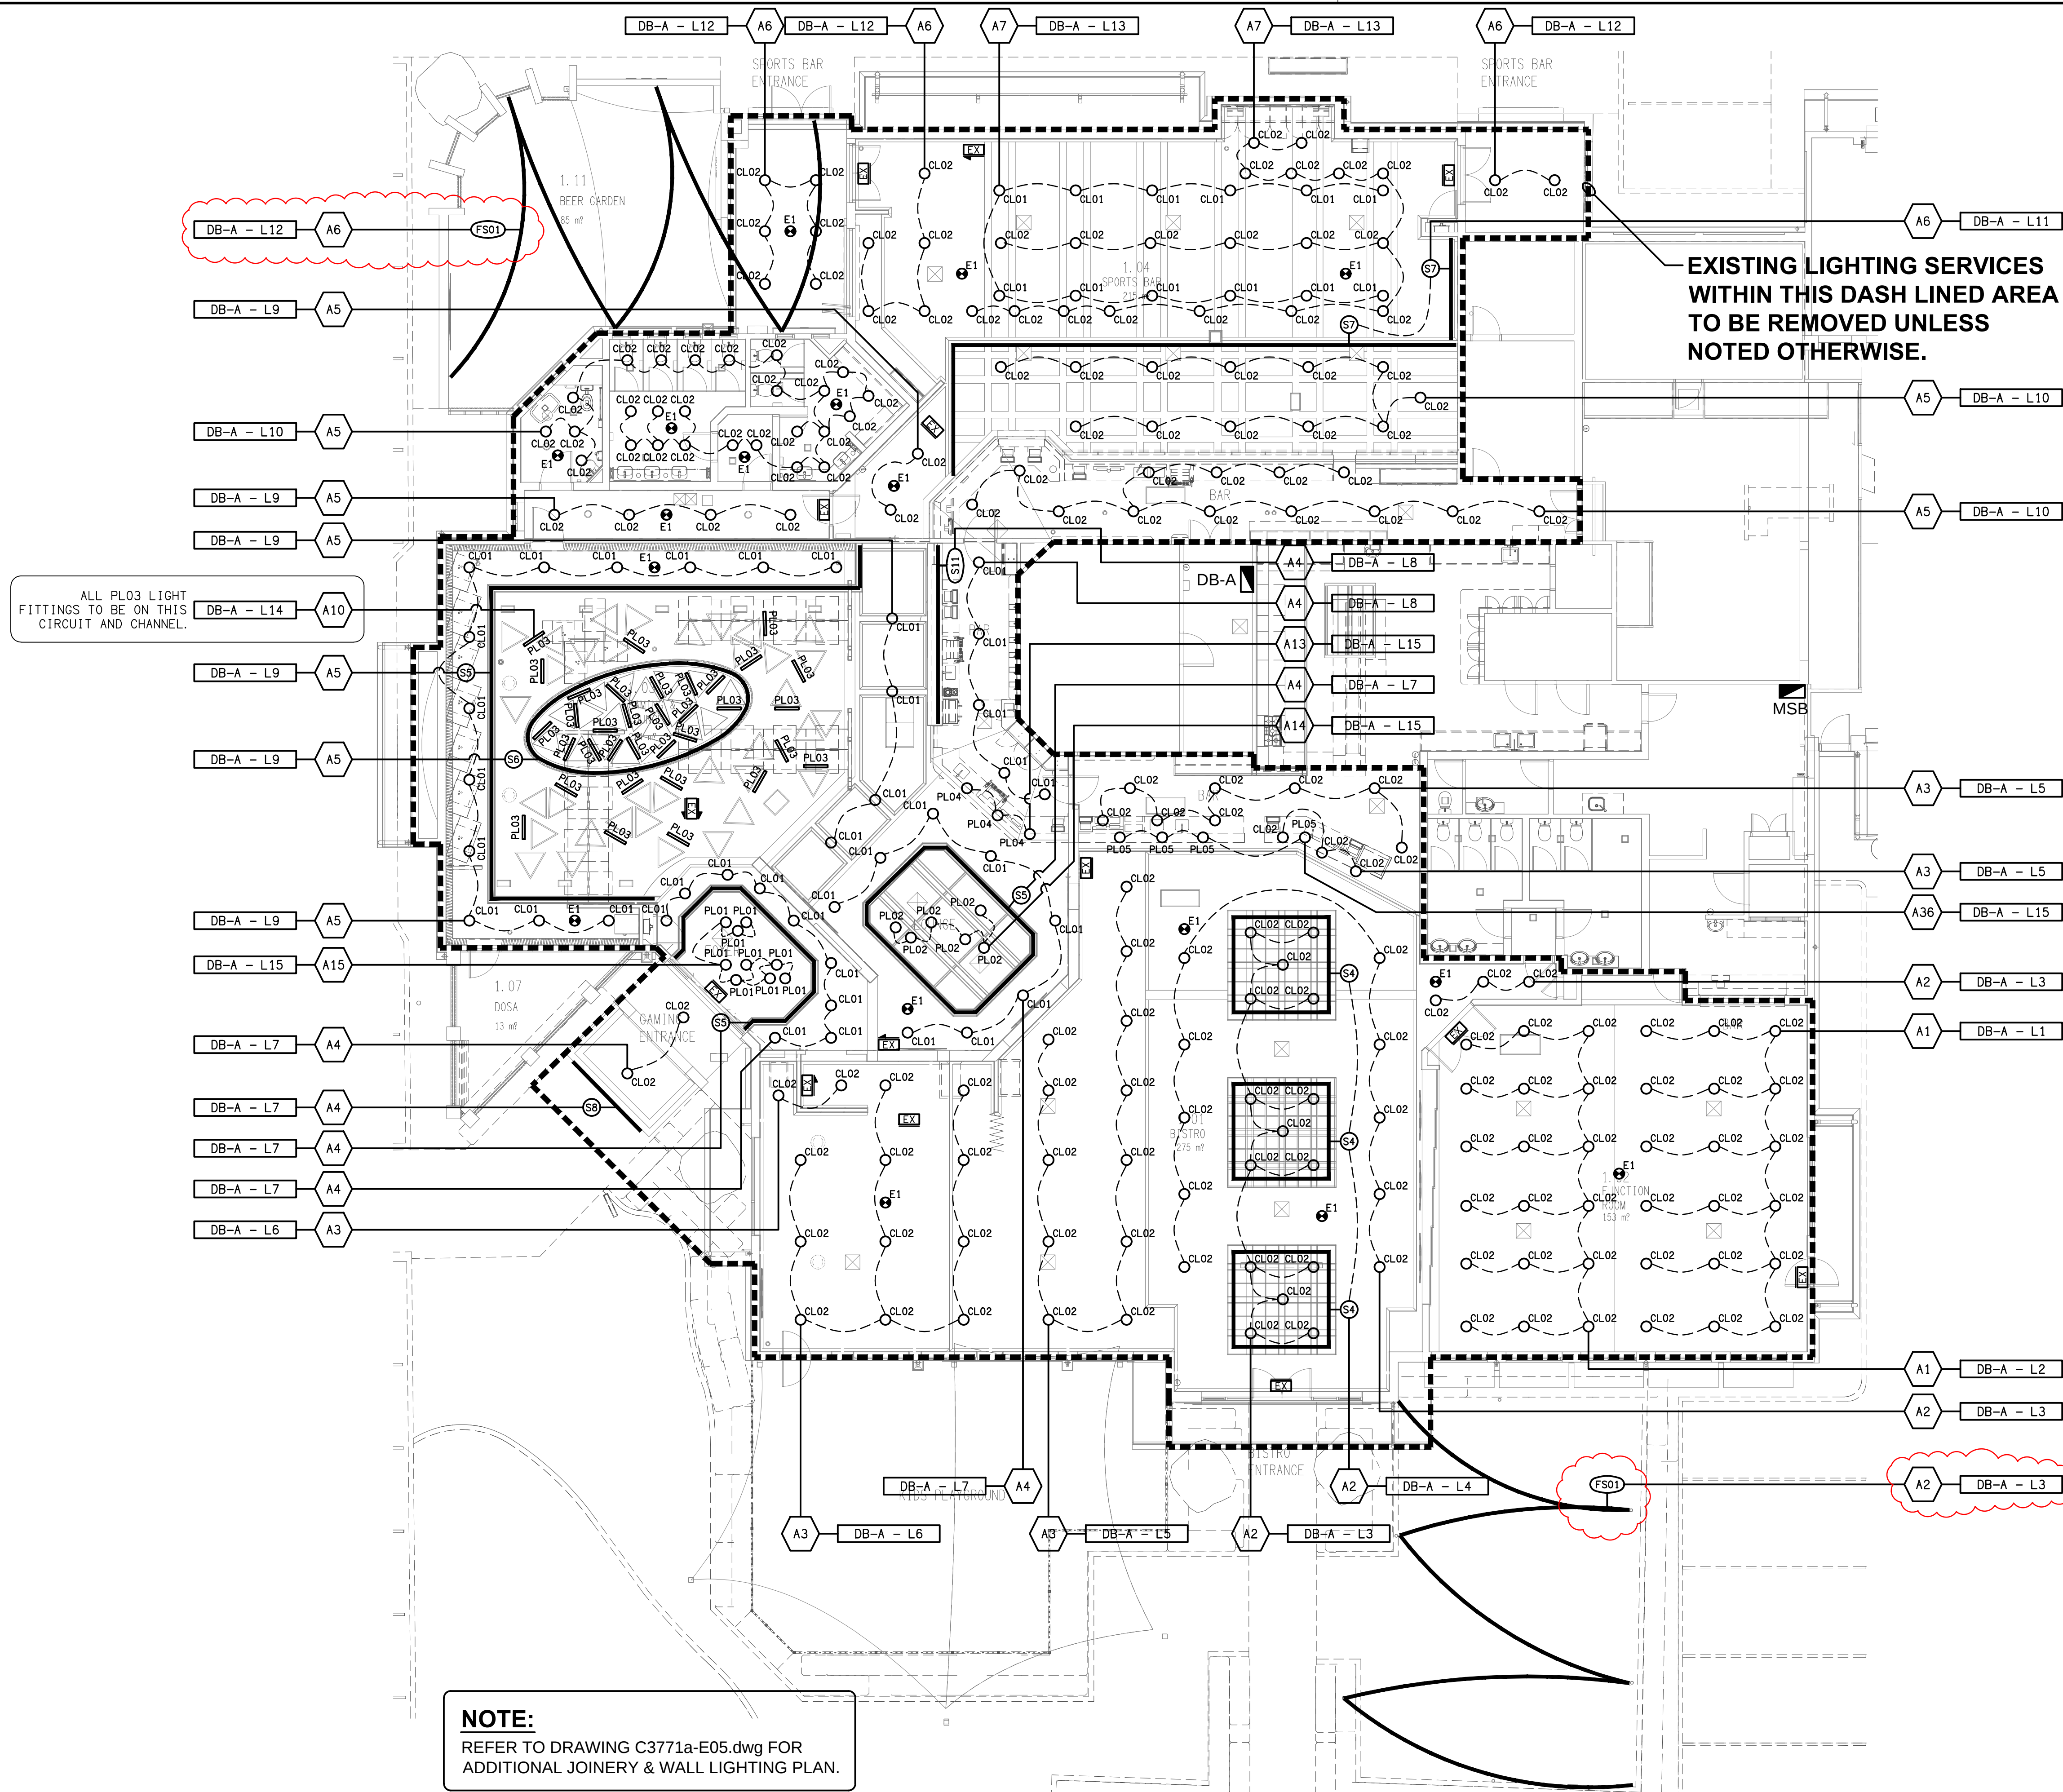


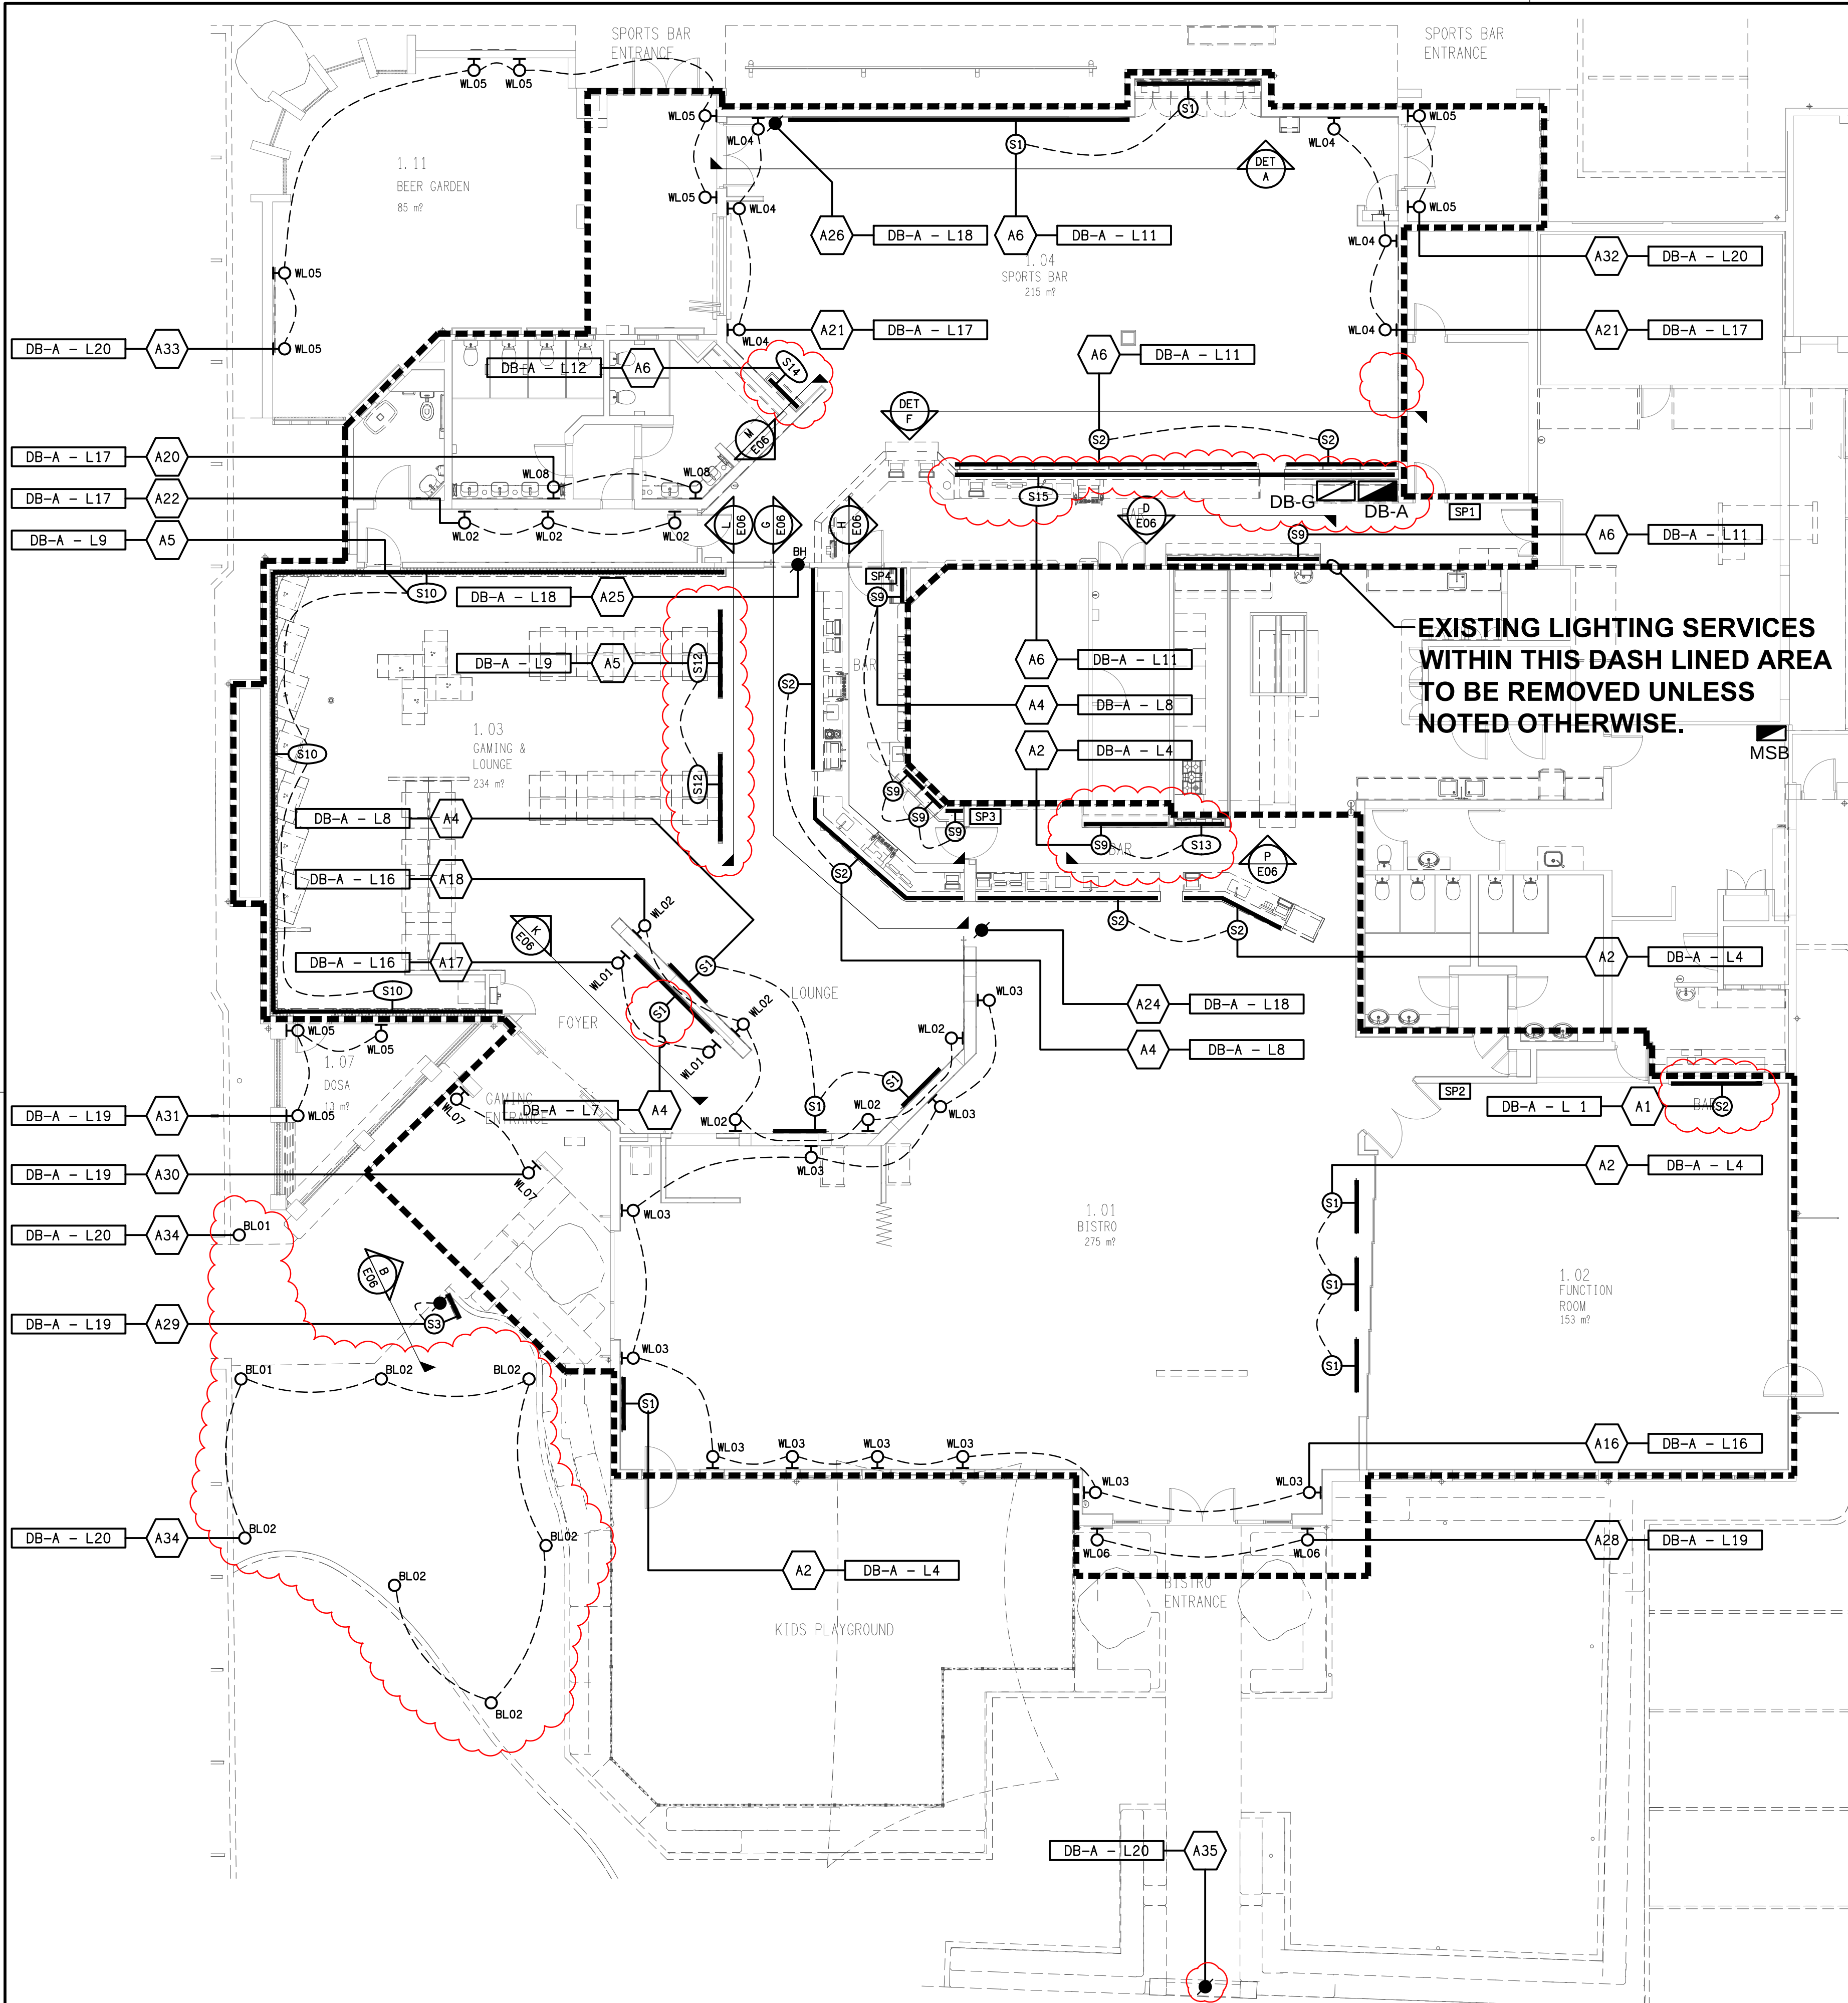


EXISTING LIGHTING SERVICES
WITHIN THIS DASH LINED AREA
TO BE REMOVED UNLESS
NOTED OTHERWISE.

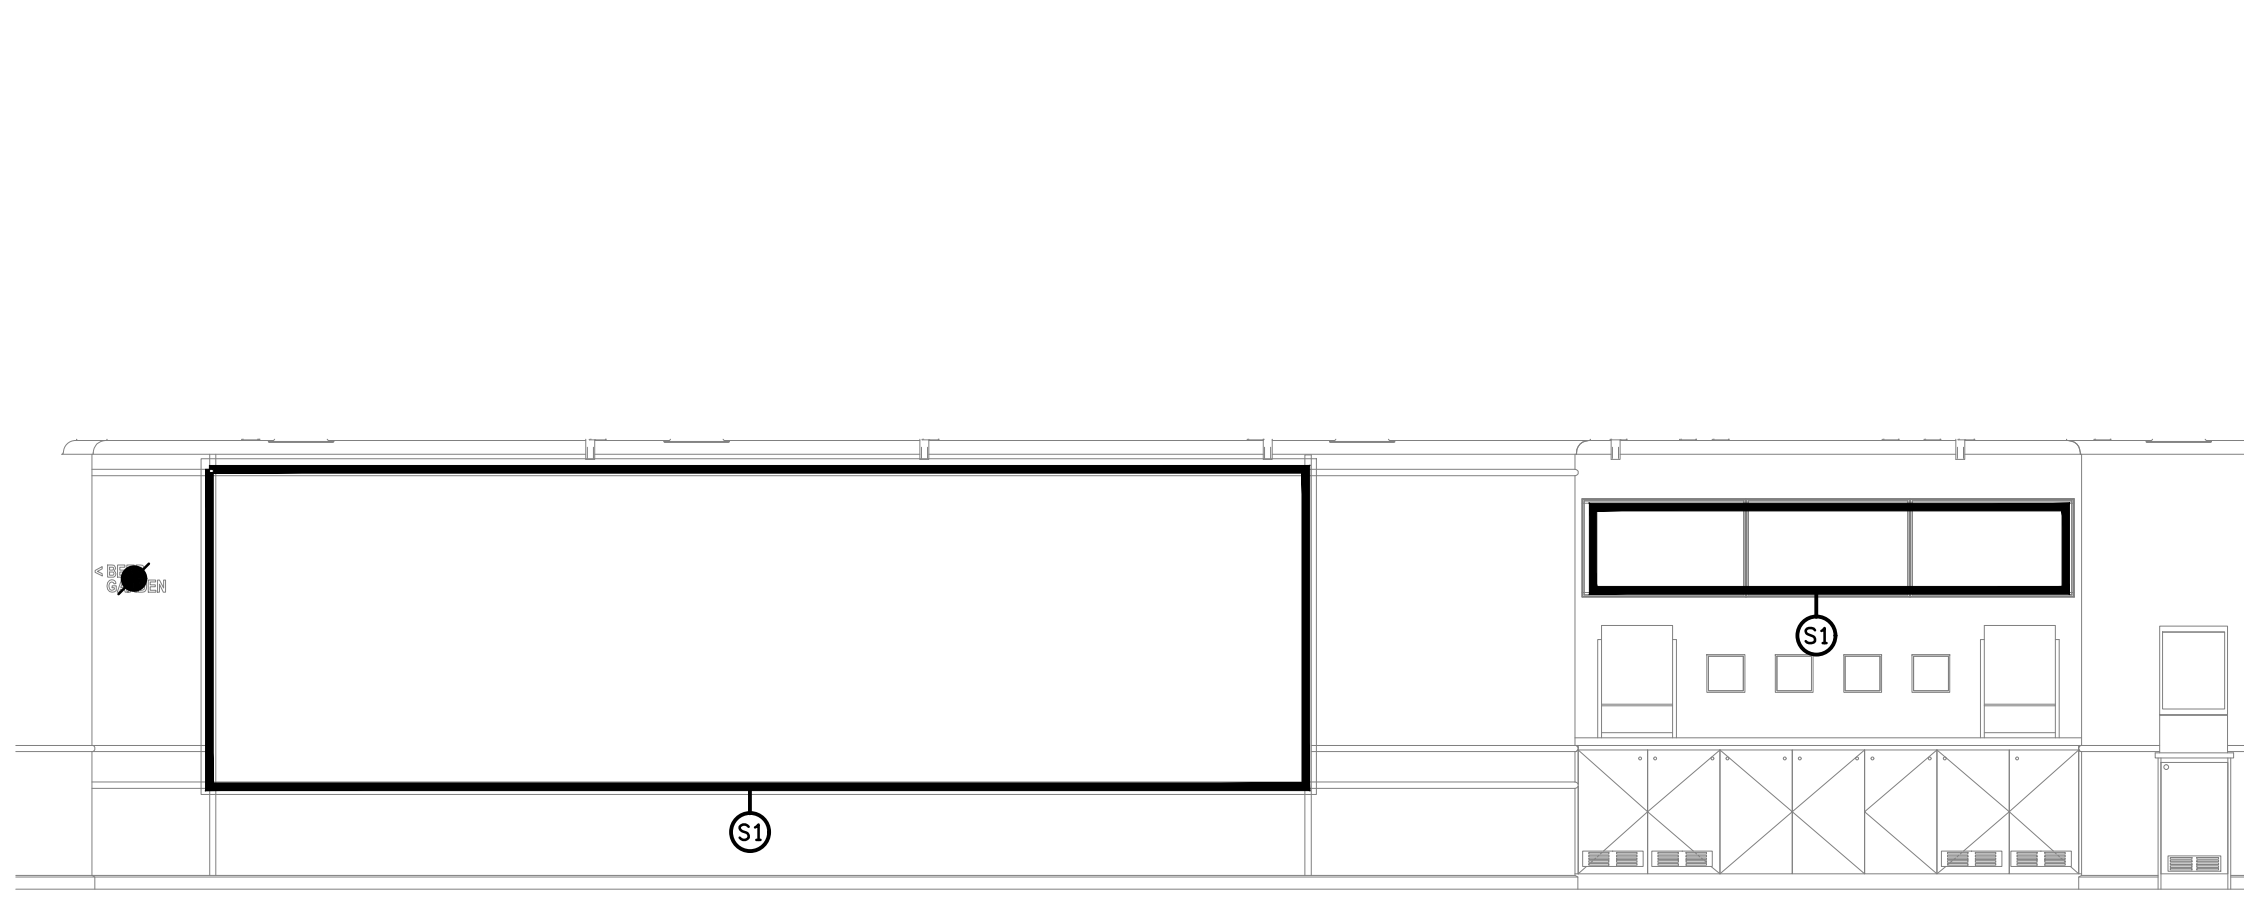


DETAIL A
SPORTS BAR TV WALL ELEVATION
SCALE 1: 50

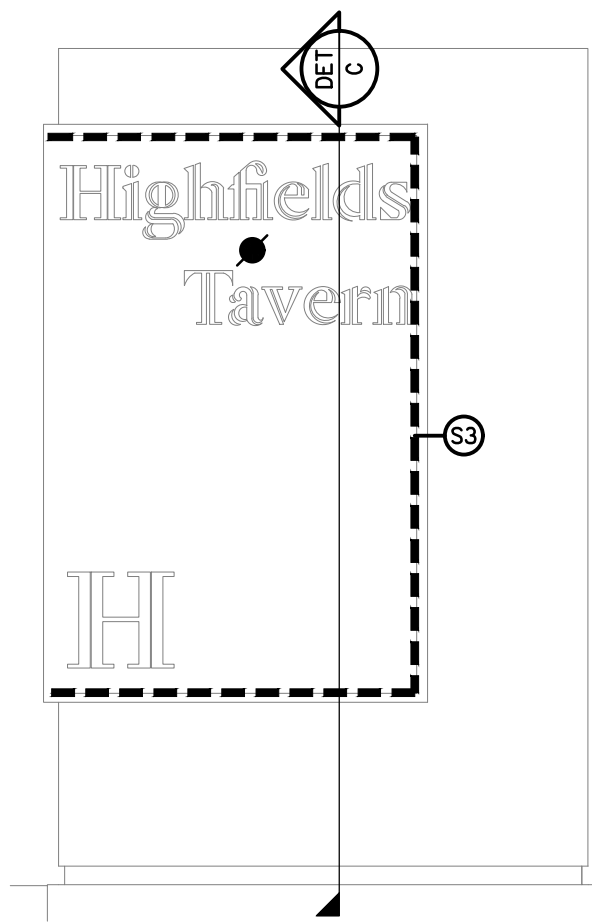


DETAIL B
ENTRY SIGN ELEVATION
SCALE 1: 10

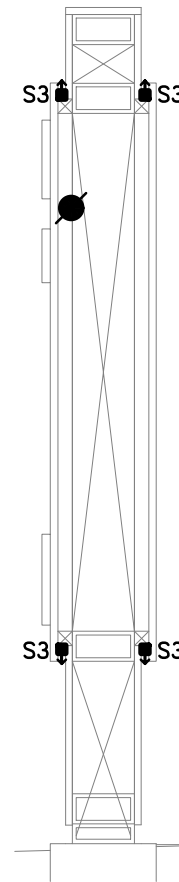


DETAIL C
ENTRY SIGN SECTION
SCALE 1: 10

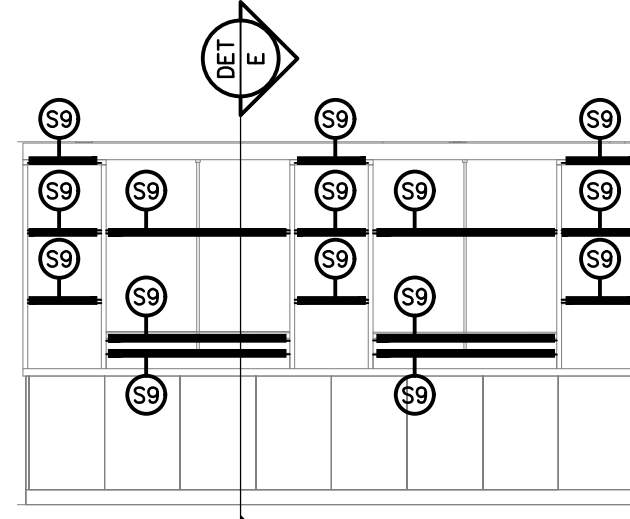


DETAIL D
SPORTS BAR REAR WALL ELEVATION 1
SCALE 1: 50

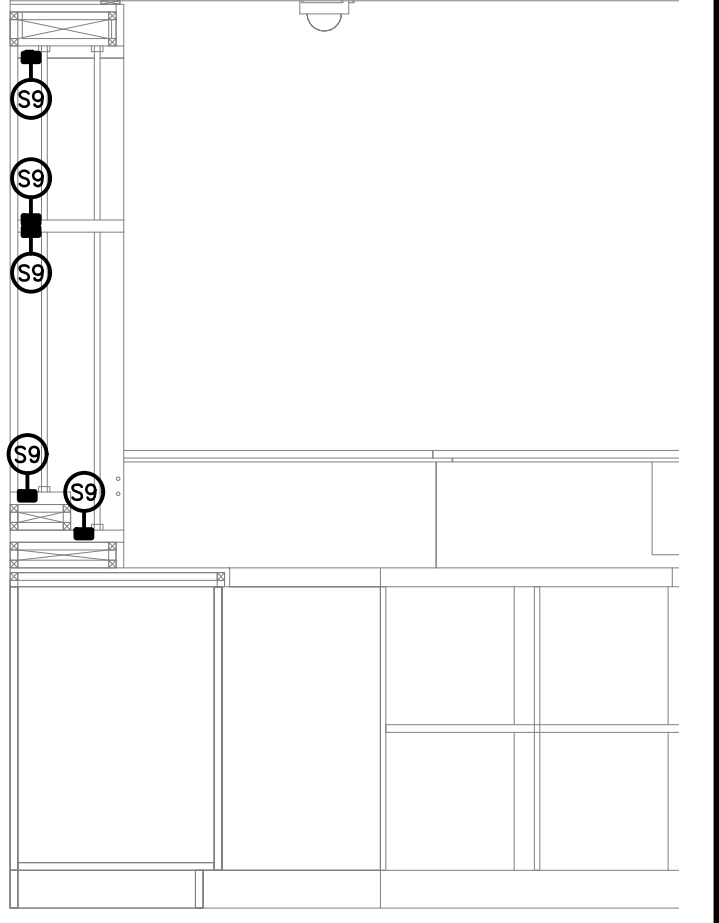


DETAIL E
SPORTS BAR SHELIVING SECTION 1
SCALE 1: 20

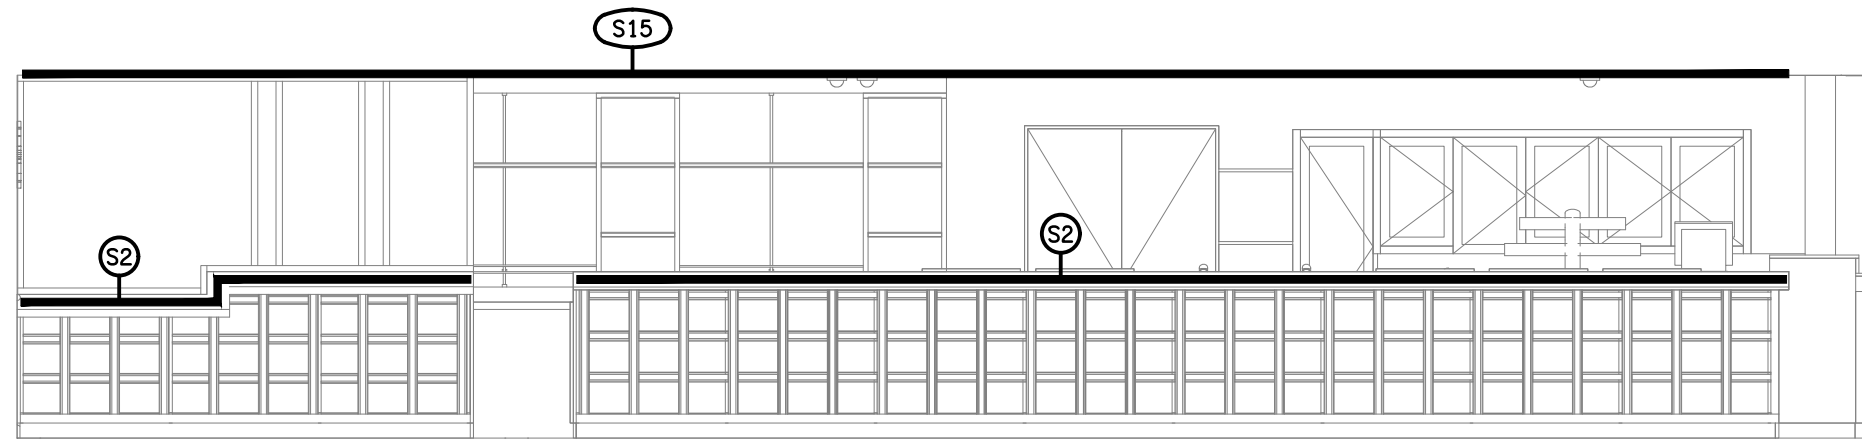


DETAIL F
SPORTS BAR COUNTER ELEVATION 1
SCALE 1: 50

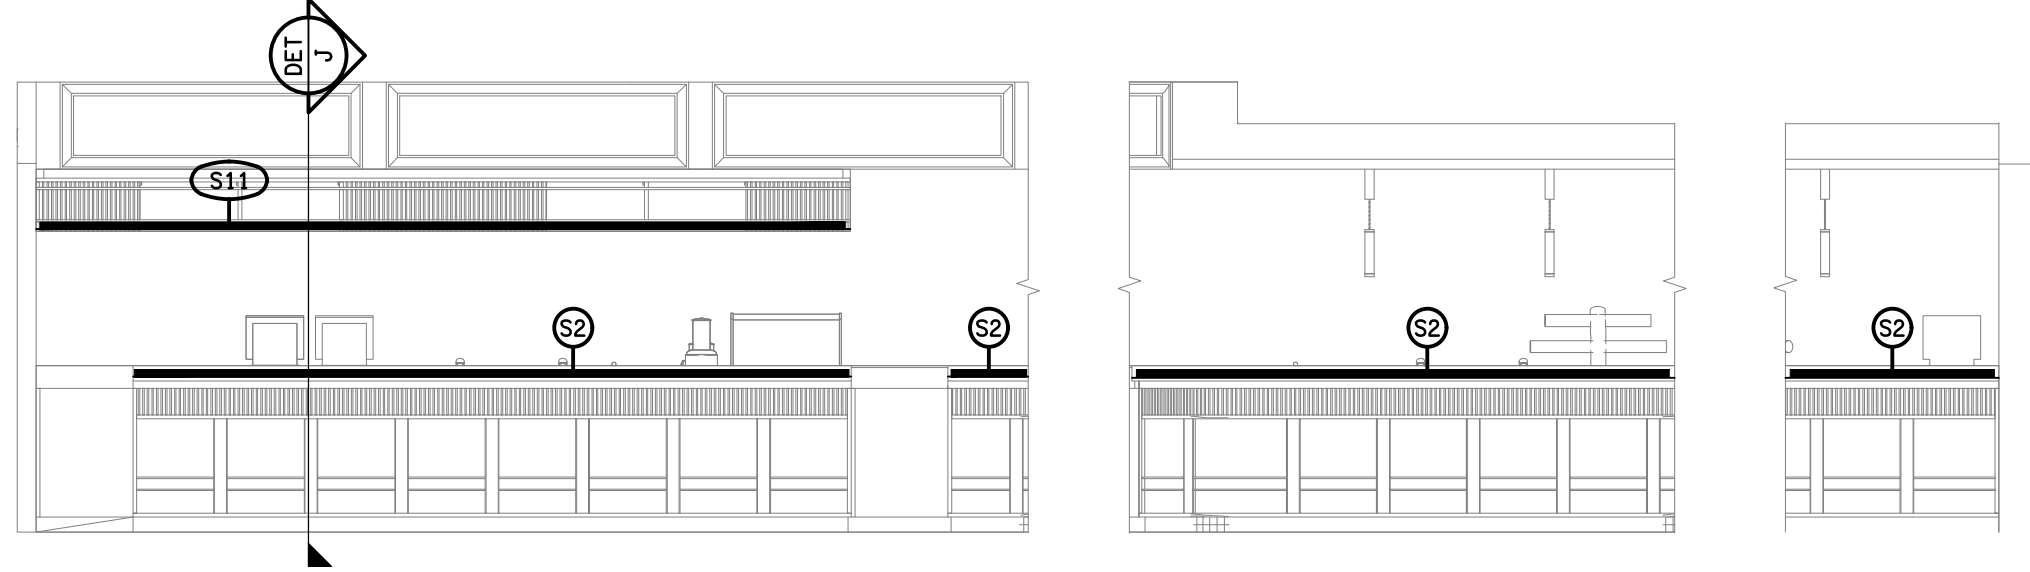


DETAIL G
SPORTS BAR COUNTER ELEVATION 2
SCALE 1: 50

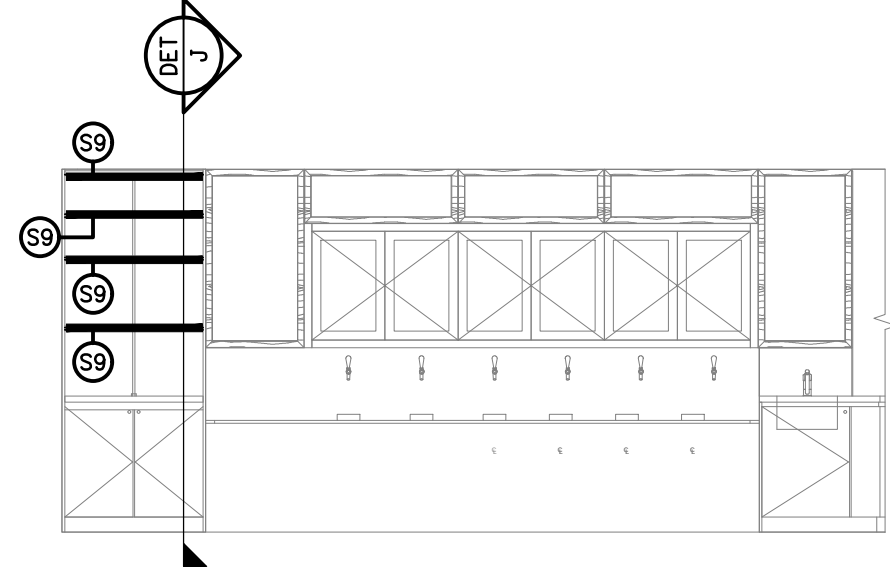


DETAIL H
SPORTS BAR REAR WALL ELEVATION
SCALE 1: 50

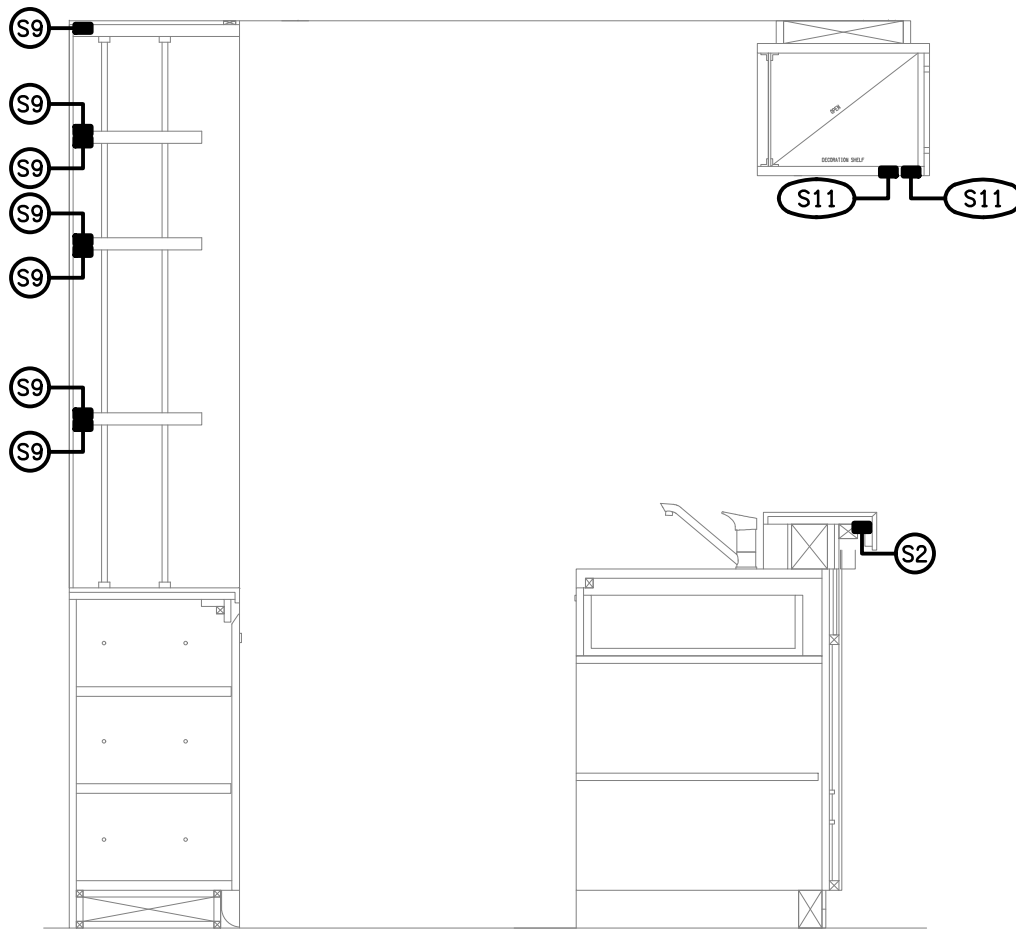


DETAIL J
SPORTS BAR SHELIVING SECTION 2
SCALE 1: 20

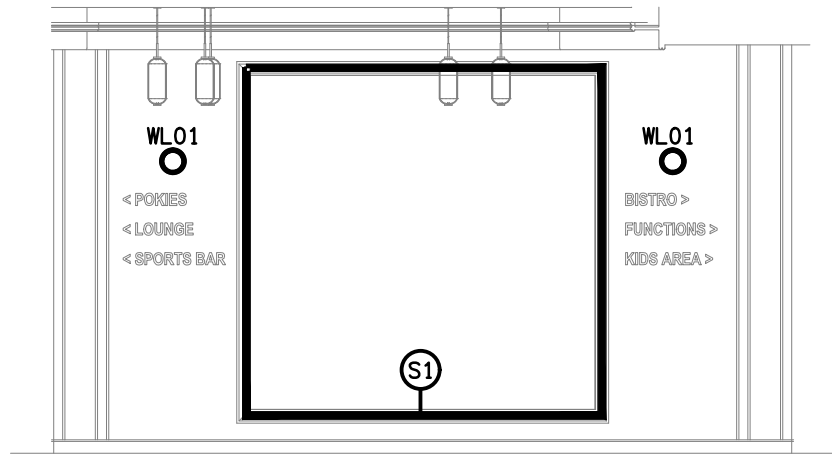


DETAIL K
GAMING ENTRY ELEVATION
SCALE 1: 50

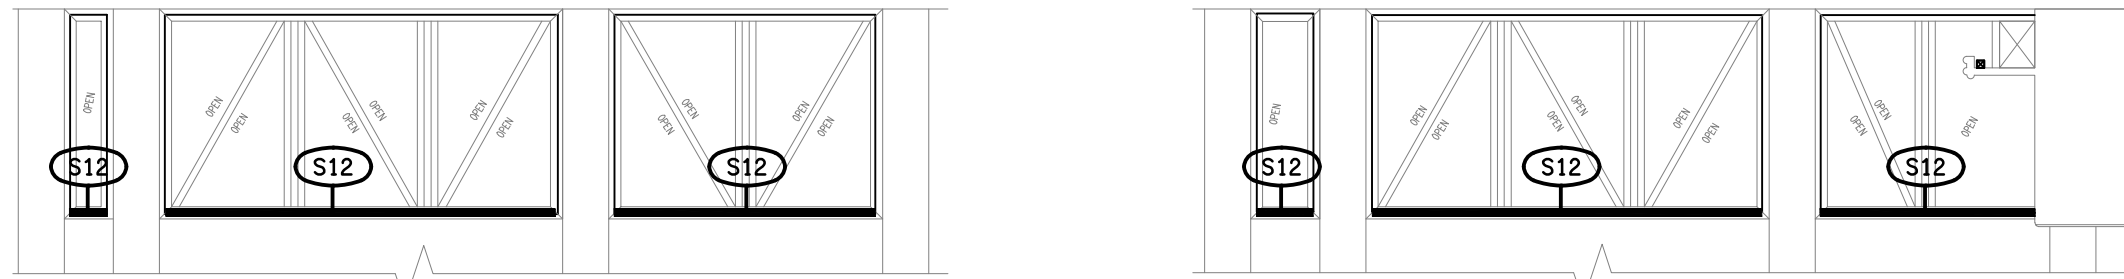


HIGH LEVEL GAMING SCREEN ELEVATION

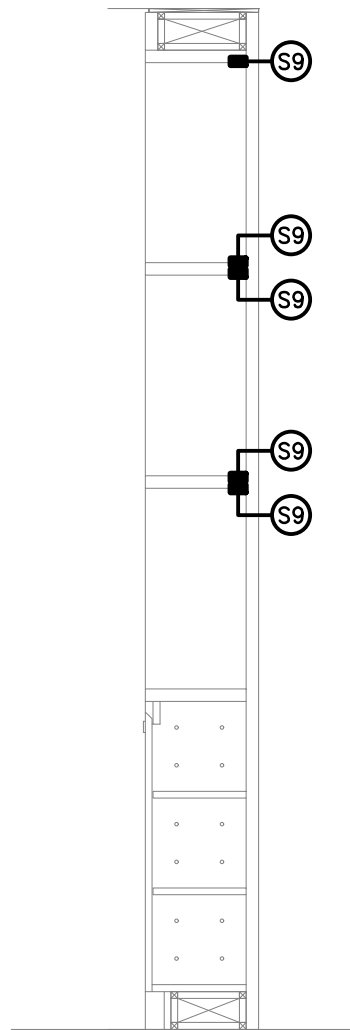


DETAIL M
TROPHY CABINET SECTION
SCALE 1: 20

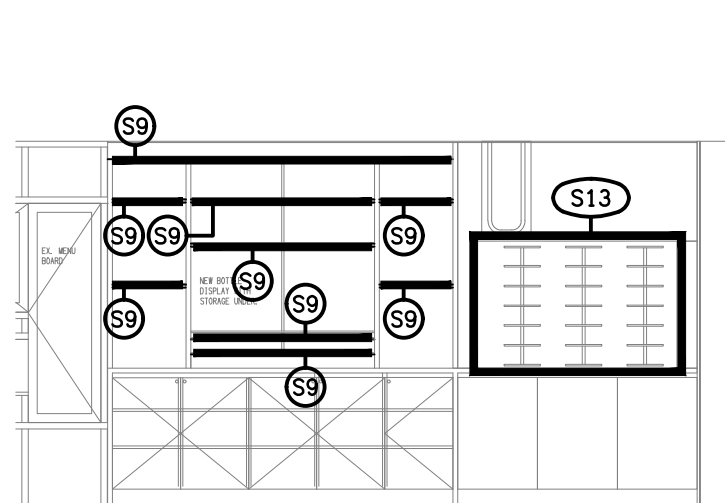

DETAIL P
BOTTLE DISPLAY ELEVATION
SCALE 1: 50

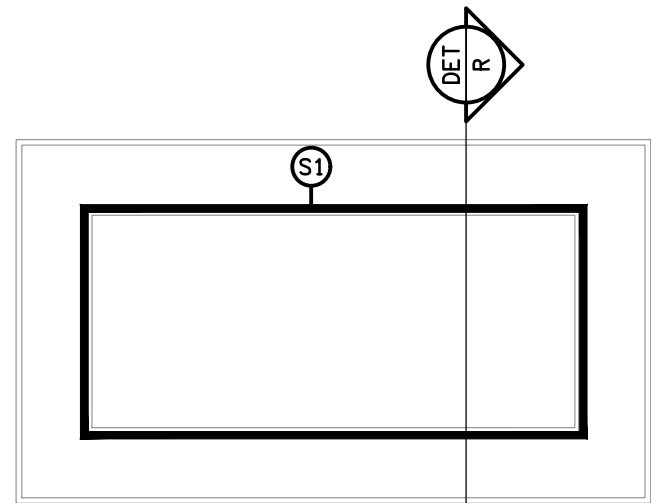

DETAIL Q
TYPICAL TV LED STRIP ELEVATION
NOT TO SCALE

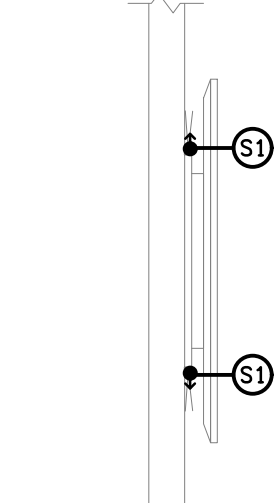

DETAIL R
TYPICAL TV LED STRIP SECTION
NOT TO SCALE

ELECTRICAL DESIGN GROUP BRISBANE
PTY LTD
ACN 092 710 793
TRADING AS:
ELECTRICAL DESIGN GROUP

THE COPYRIGHT OF THIS DRAWING
REMAINS THE PROPERTY OF THE
ELECTRICAL DESIGN GROUP.
USE FIGURED DIMENSIONS
IN PREFERENCE TO SCALE.
ALL DIMENSIONS TO BE
VERIFIED ONSITE.

ELECTRICAL DESIGN GROUP
ELECTRICAL BUILDING SERVICES CONSULTANTS
BRISBANE GOLD COAST

P.O. Box 15, Sherwood Q.4075
Phone: (07) 3278 4375
Email: brisbane@edg.net.au
Web: www.edg.net.au

PROJECT:
HIGHFIELDS TAVERN

CORNER O'BRIEN & 12 HIGHFIELDS ROAD, HIGHFIELDS QLD

A	TENDER	05/08/2026
REV:	DESCRIPTION:	DATE:

DRAWING:
ELECTRICAL SERVICES
JOINERY & WALL LIGHTING DETAILS

SCALE: AS SHOWN	AT A1	PROJECT NO: C3771a	DRAWING NO: E06	REVISION: A
--------------------	-------	------------------------------	---------------------------	-----------------------