LEGEND

SITE PLAN

- ELECTRICAL SERVICES SWITCHBOARD, TYPE AS NOTED.
- COMMUNICATIONS RACK, TYPE AS NOTED.
- PITx ELECTRICAL PIT, TYPE AS NOTED.
- CONDUIT ROUTE.
- C-x x DENOTES CONDUIT TYPE.

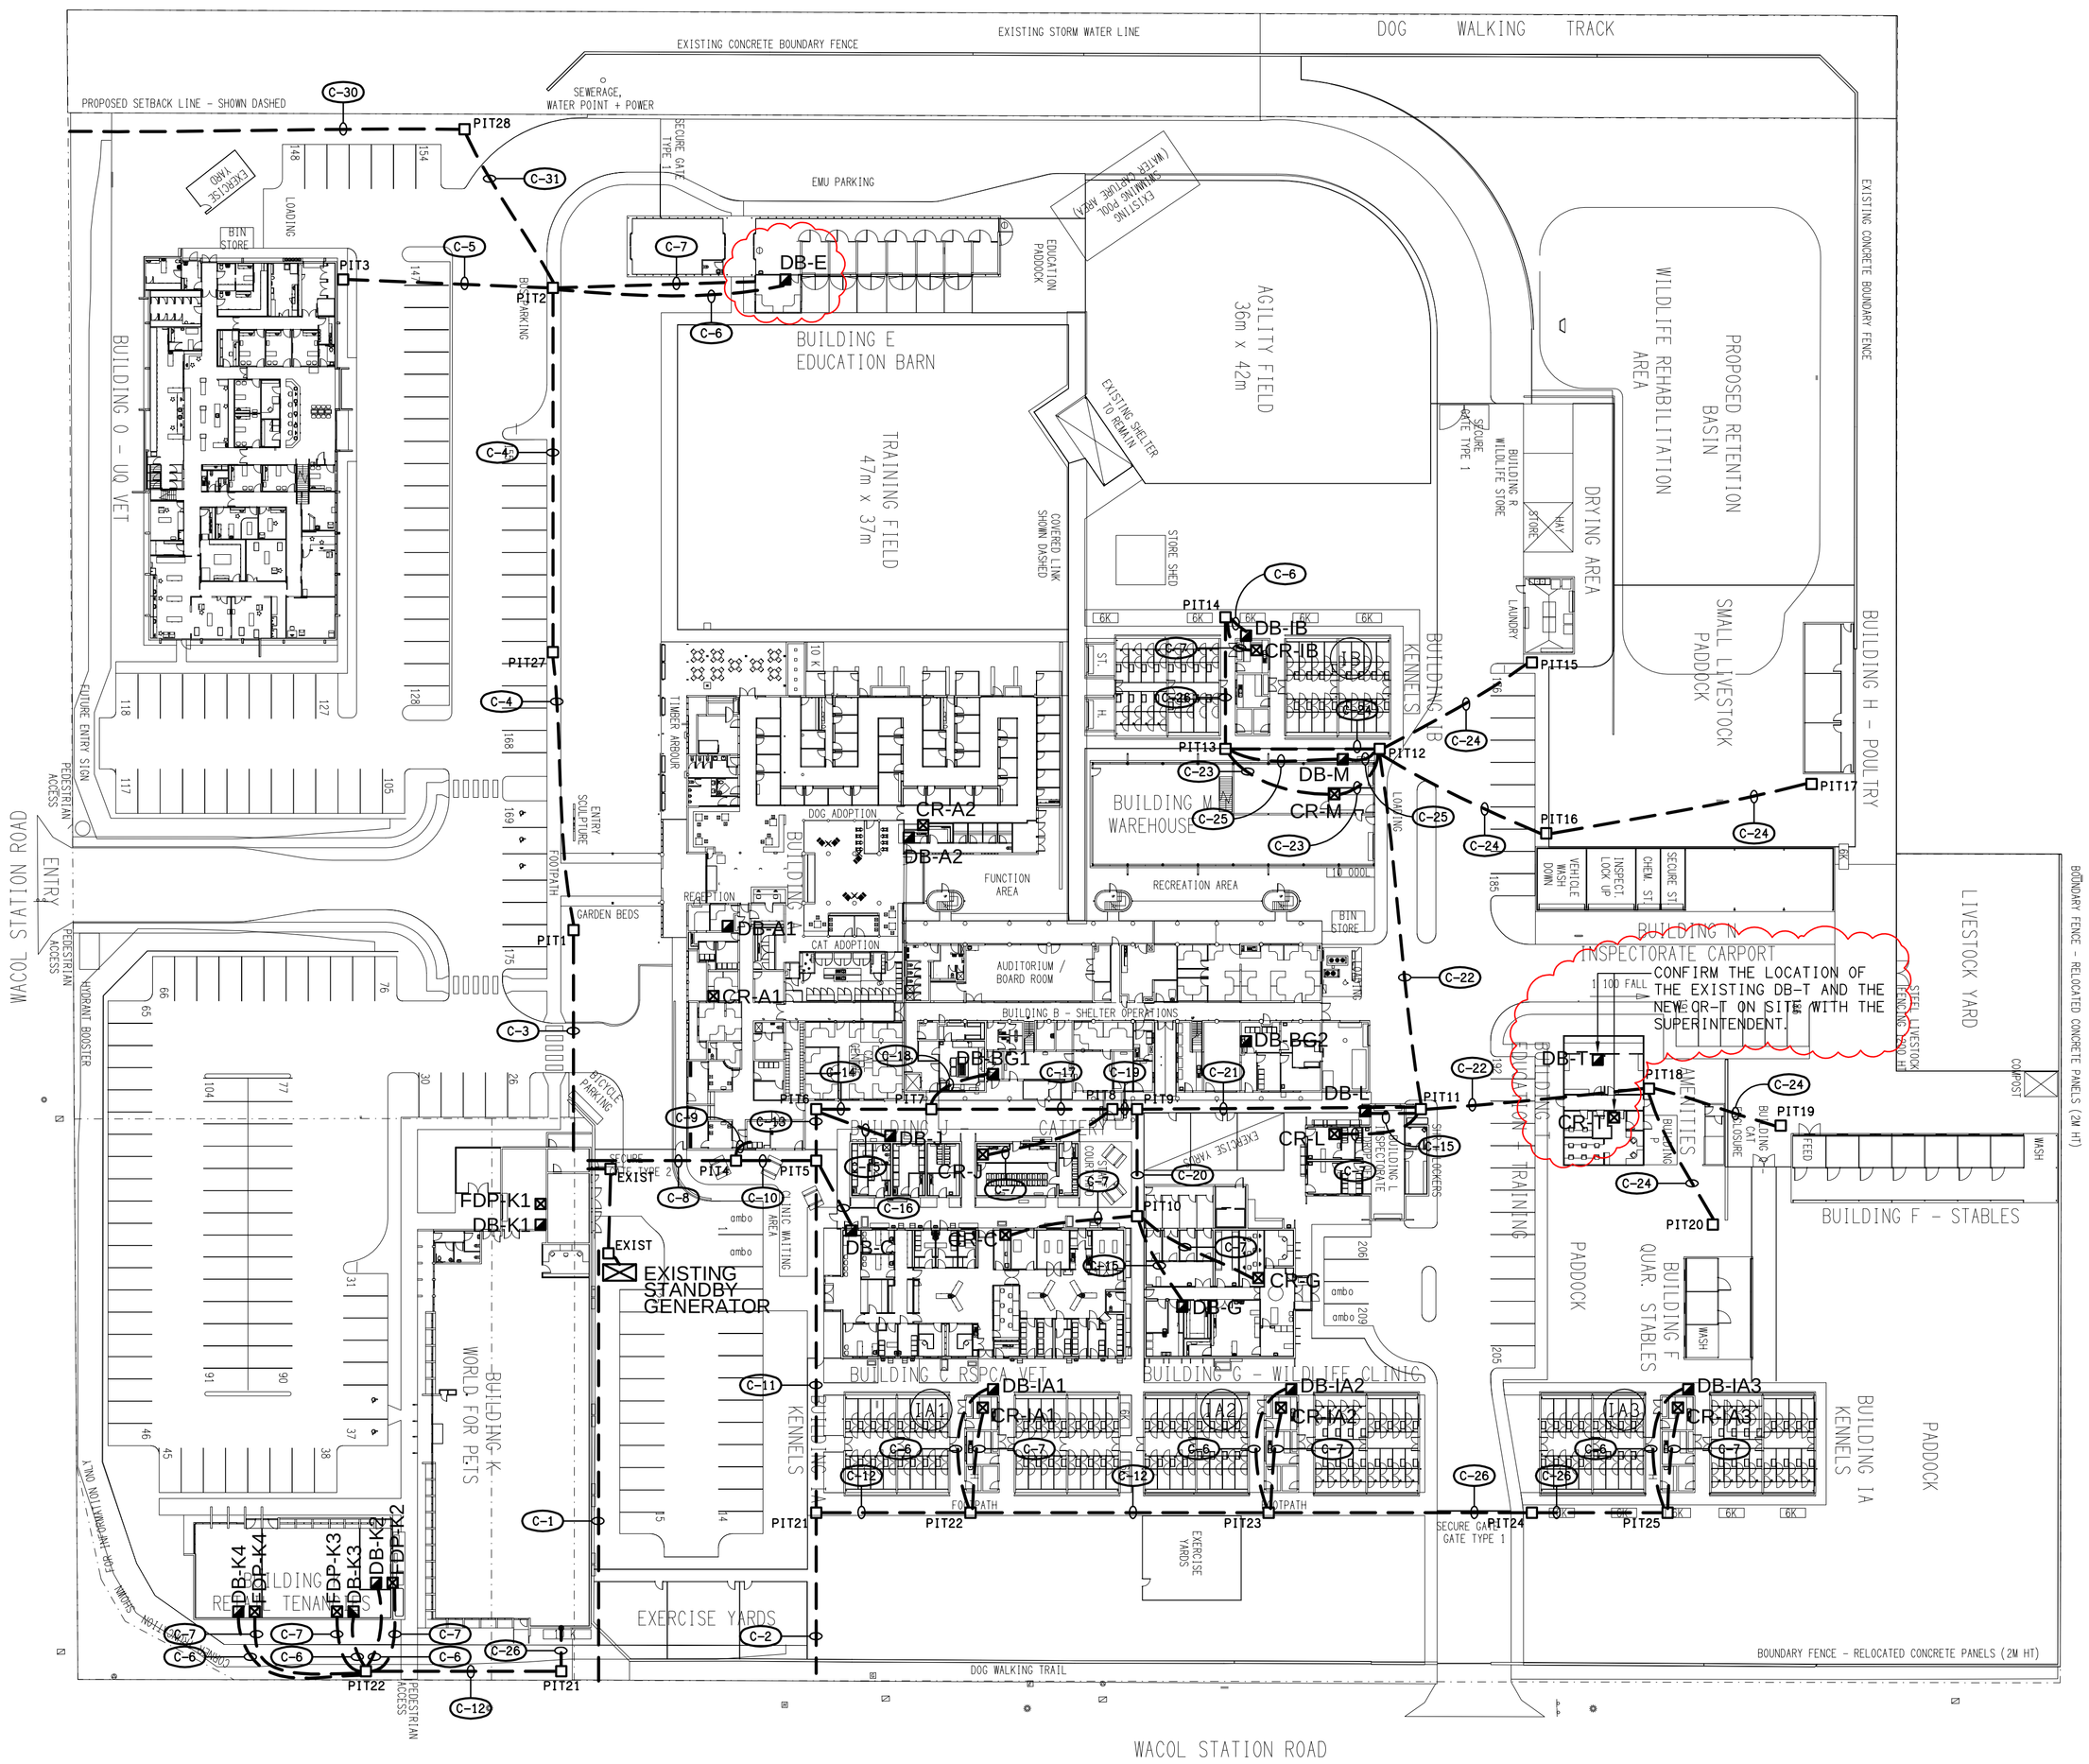

REV:	DESCRIPTION:	DATE:
G	CONSTRUCTION	24/08/2011

ELECTRICAL DESIGN GROUP BRISBANE
PTY LTD
ACN 092 710 793

TRADING AS:
ELECTRICAL DESIGN GROUP

THE COPYRIGHT OF THIS DRAWING REMAINS THE PROPERTY OF THE ELECTRICAL DESIGN GROUP.

USE FIGURED DIMENSIONS IN PREFERENCE TO SCALE.

ALL DIMENSIONS TO BE VERIFIED ONSITE.

ELECTRICAL DESIGN GROUP

ELECTRICAL BUILDING SERVICES CONSULTANTS

BRISBANE
P.O.Box 15, Sherwood Q.4075
Phone: (07) 3278 4375
Fax: (07) 3716 0222

GOLD COAST
P.O.Box 4249, Ashmore Q.4214
Phone: (07) 5597 7551
Fax: (07) 5597 7552

PROJECT:
RSPCA - WACOL

WACOL STATION ROAD, WACOL

DRAWING:
ELECTRICAL SERVICES
SITE PLAN
CONDUIT LAYOUT

SCALE:	PROJECT NO:	DRAWING NO:	REVISION:
1:500 AT A1	C0677a	E02	G

OFFICE USE ONLY:
DRAFT:
CHECK:
MARKUP: