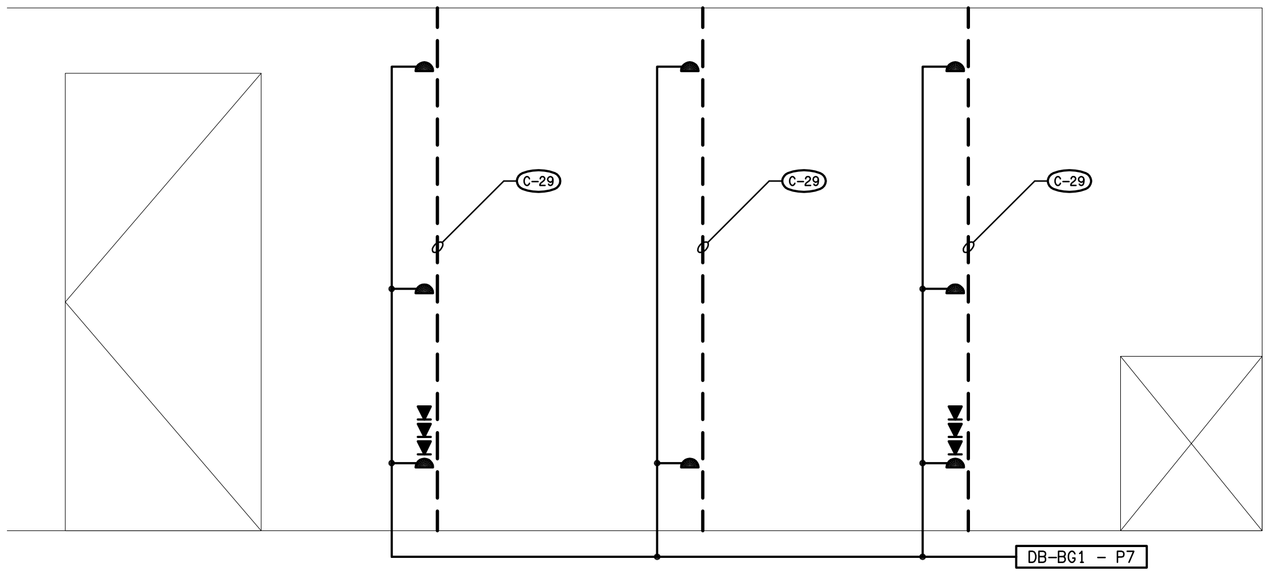

DETAIL A

BOARDROOM WALL ELEVATION

SCALE 1:20

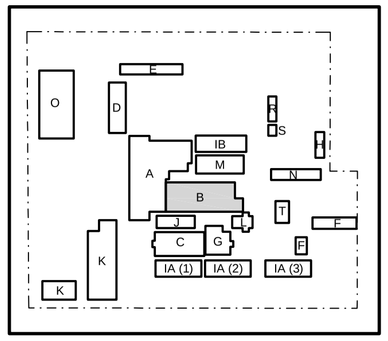

KEY PLAN

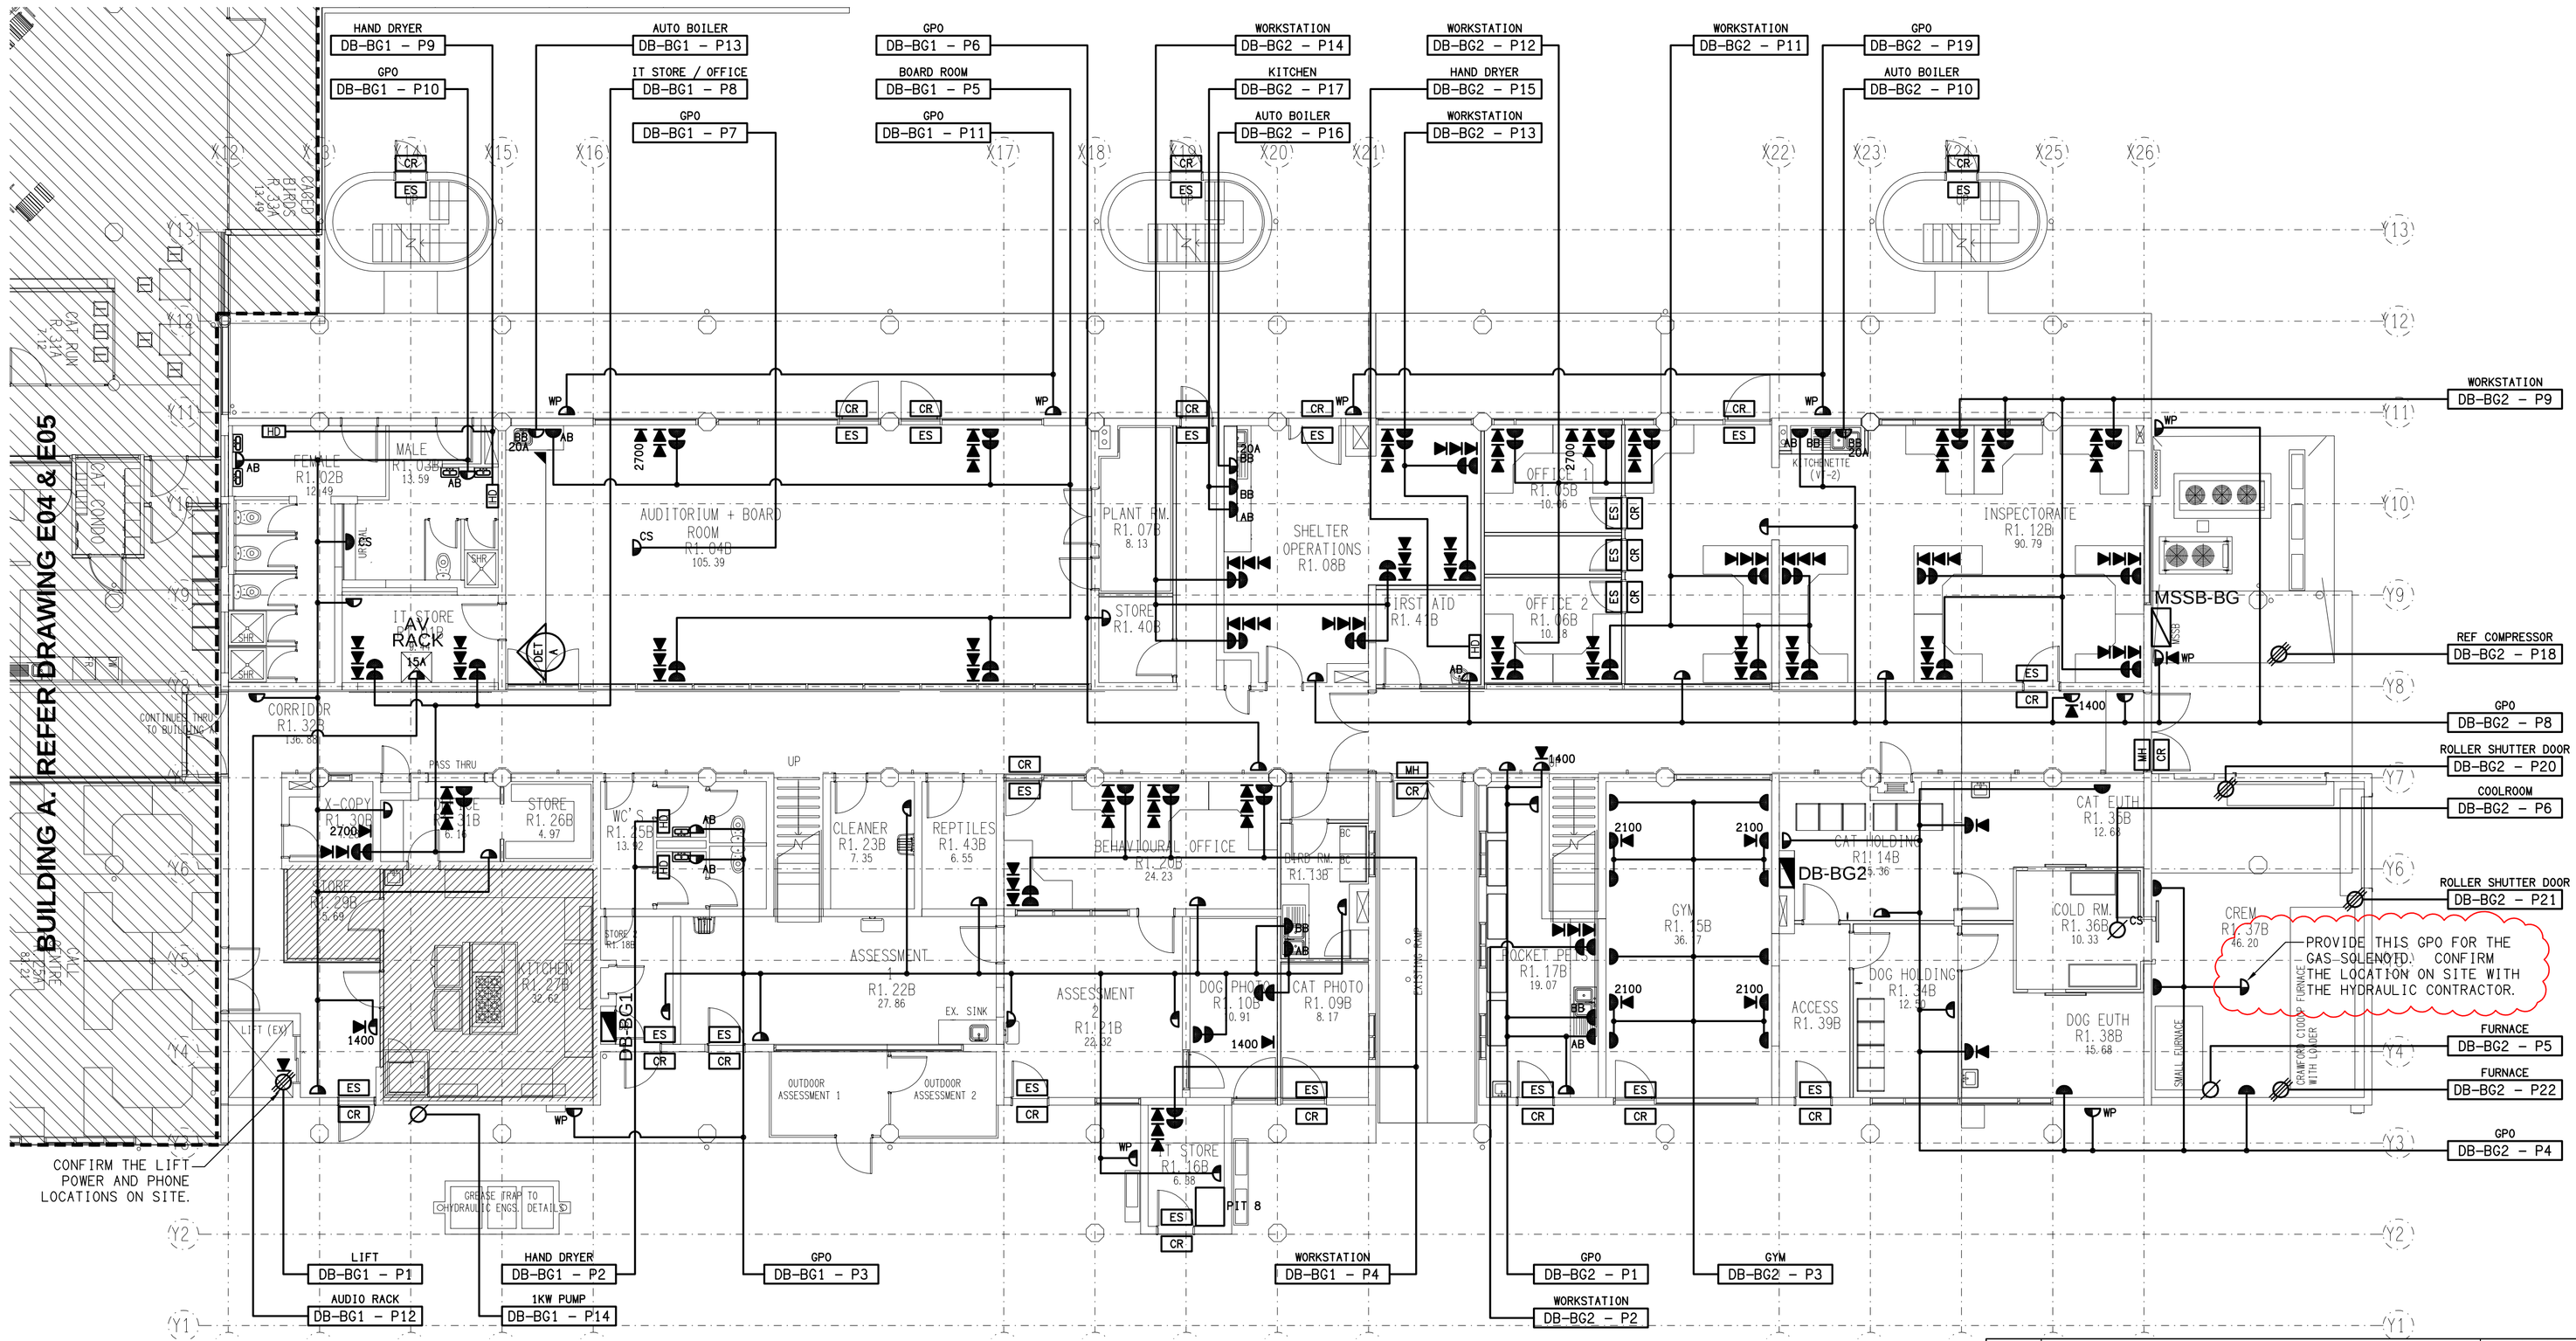

REV:	DESCRIPTION:	DATE:
H	CONSTRUCTION	02/11/2011

OFFICE USE ONLY: DRAFT: CHECK: MARKUP:

ELECTRICAL DESIGN GROUP BRISBANE PTY LTD
ACN 092 710 793

TRADING AS:
ELECTRICAL DESIGN GROUP

THE COPYRIGHT OF THIS DRAWING REMAINS THE PROPERTY OF THE ELECTRICAL DESIGN GROUP.

USE FIGURED DIMENSIONS IN PREFERENCE TO SCALE.

ALL DIMENSIONS TO BE VERIFIED ONSITE.

ELECTRICAL DESIGN GROUP
ELECTRICAL BUILDING SERVICES CONSULTANTS

BRISBANE
P.O.Box 15, Sherwood Q.4075
Phone: (07) 3278 4375
Fax: (07) 3716 0222

GOLD COAST
P.O.Box 4249, Ashmore Q.4214
Phone: (07) 5597 7551
Fax: (07) 5597 7552

PROJECT:
RSPCA - WACOL

WACOL STATION ROAD, WACOL

DRAWING:
ELECTRICAL SERVICES
BUILDING B
GROUND LEVEL FLOOR PLAN

SCALE:	PROJECT NO:	DRAWING NO:	REVISION:
1:100 AT A1	C0677a	E06	H