


## BUILDING G

REFLECTED CEILING PLAN

SCALE 1:100

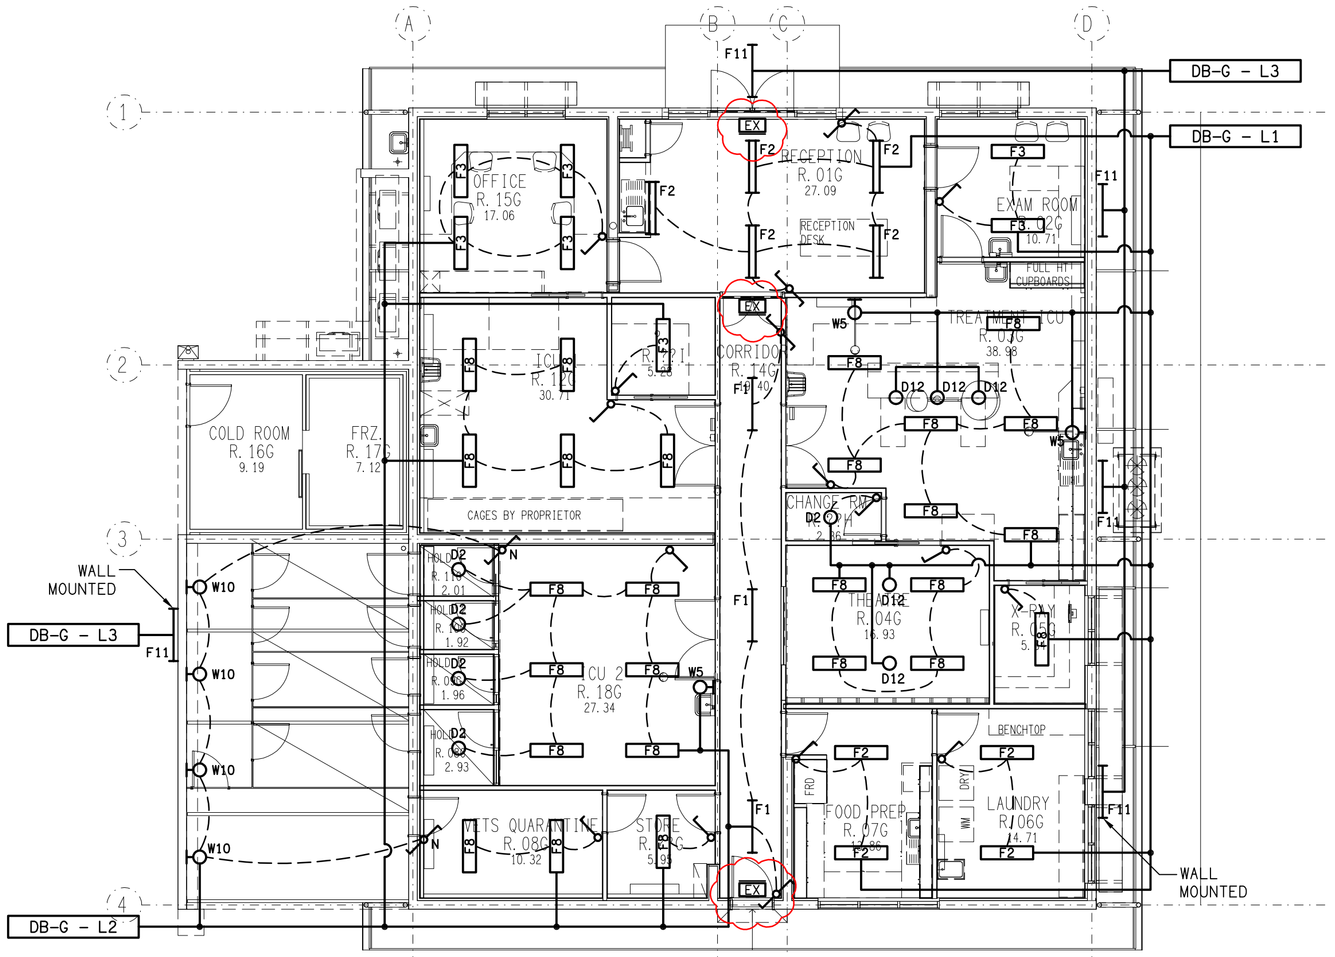


## DETAIL A

THEATRE FLOOR PLAN

SCALE 1:100

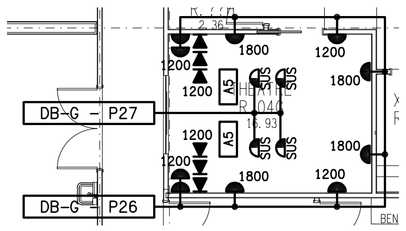


## BUILDING G

FLOOR PLAN

SCALE 1:100



KEY PLAN
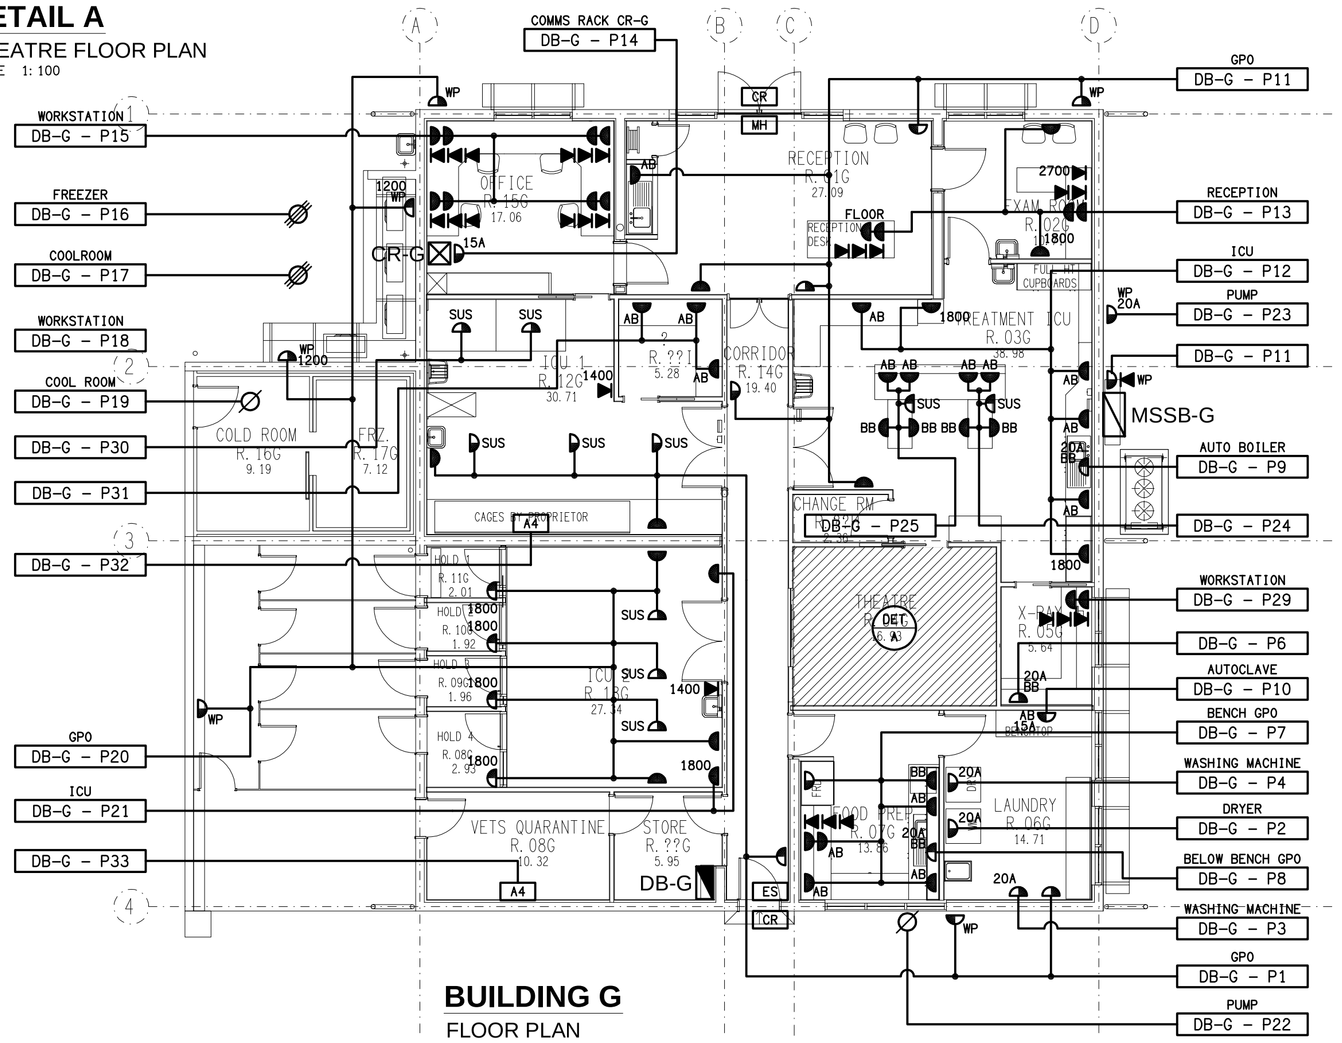
| REV: | DESCRIPTION: | DATE: |
|---|---|---|
| N | CONSTRUCTION | 01/11/2011 |

OFFICE USE ONLY: DRAFT: CHECK: MARKUP:


ELECTRICAL DESIGN GROUP BRISBANE PTY LTD
ACN 092 710 793

TRADING AS:
ELECTRICAL DESIGN GROUP

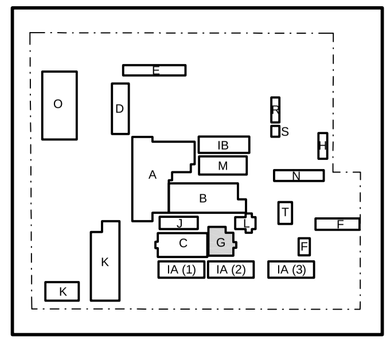

THE COPYRIGHT OF THIS DRAWING REMAINS THE PROPERTY OF THE ELECTRICAL DESIGN GROUP.


USE FIGURED DIMENSIONS IN PREFERENCE TO SCALE.

ALL DIMENSIONS TO BE VERIFIED ONSITE.


ELECTRICAL DESIGN GROUP
ELECTRICAL BUILDING SERVICES CONSULTANTS

BRISBANE
P.O.Box 15, Sherwood Q.4075
Phone: (07) 3278 4375
Fax: (07) 3716 0222

GOLD COAST
P.O.Box 4249, Ashmore Q.4214
Phone: (07) 5597 7551
Fax: (07) 5597 7552


PROJECT:
RSPCA - WACOL

WACOL STATION ROAD, WACOL

DRAWING:
**ELECTRICAL SERVICES**
BUILDINGS G
FLOOR PLAN & REFLECTED CEILING PLAN

| SCALE: | | PROJECT NO: | DRAWING NO: | REVISION: |
|---|---|---|---|---|
| 1:100 | AT A1 | C0677a | E11 | N |