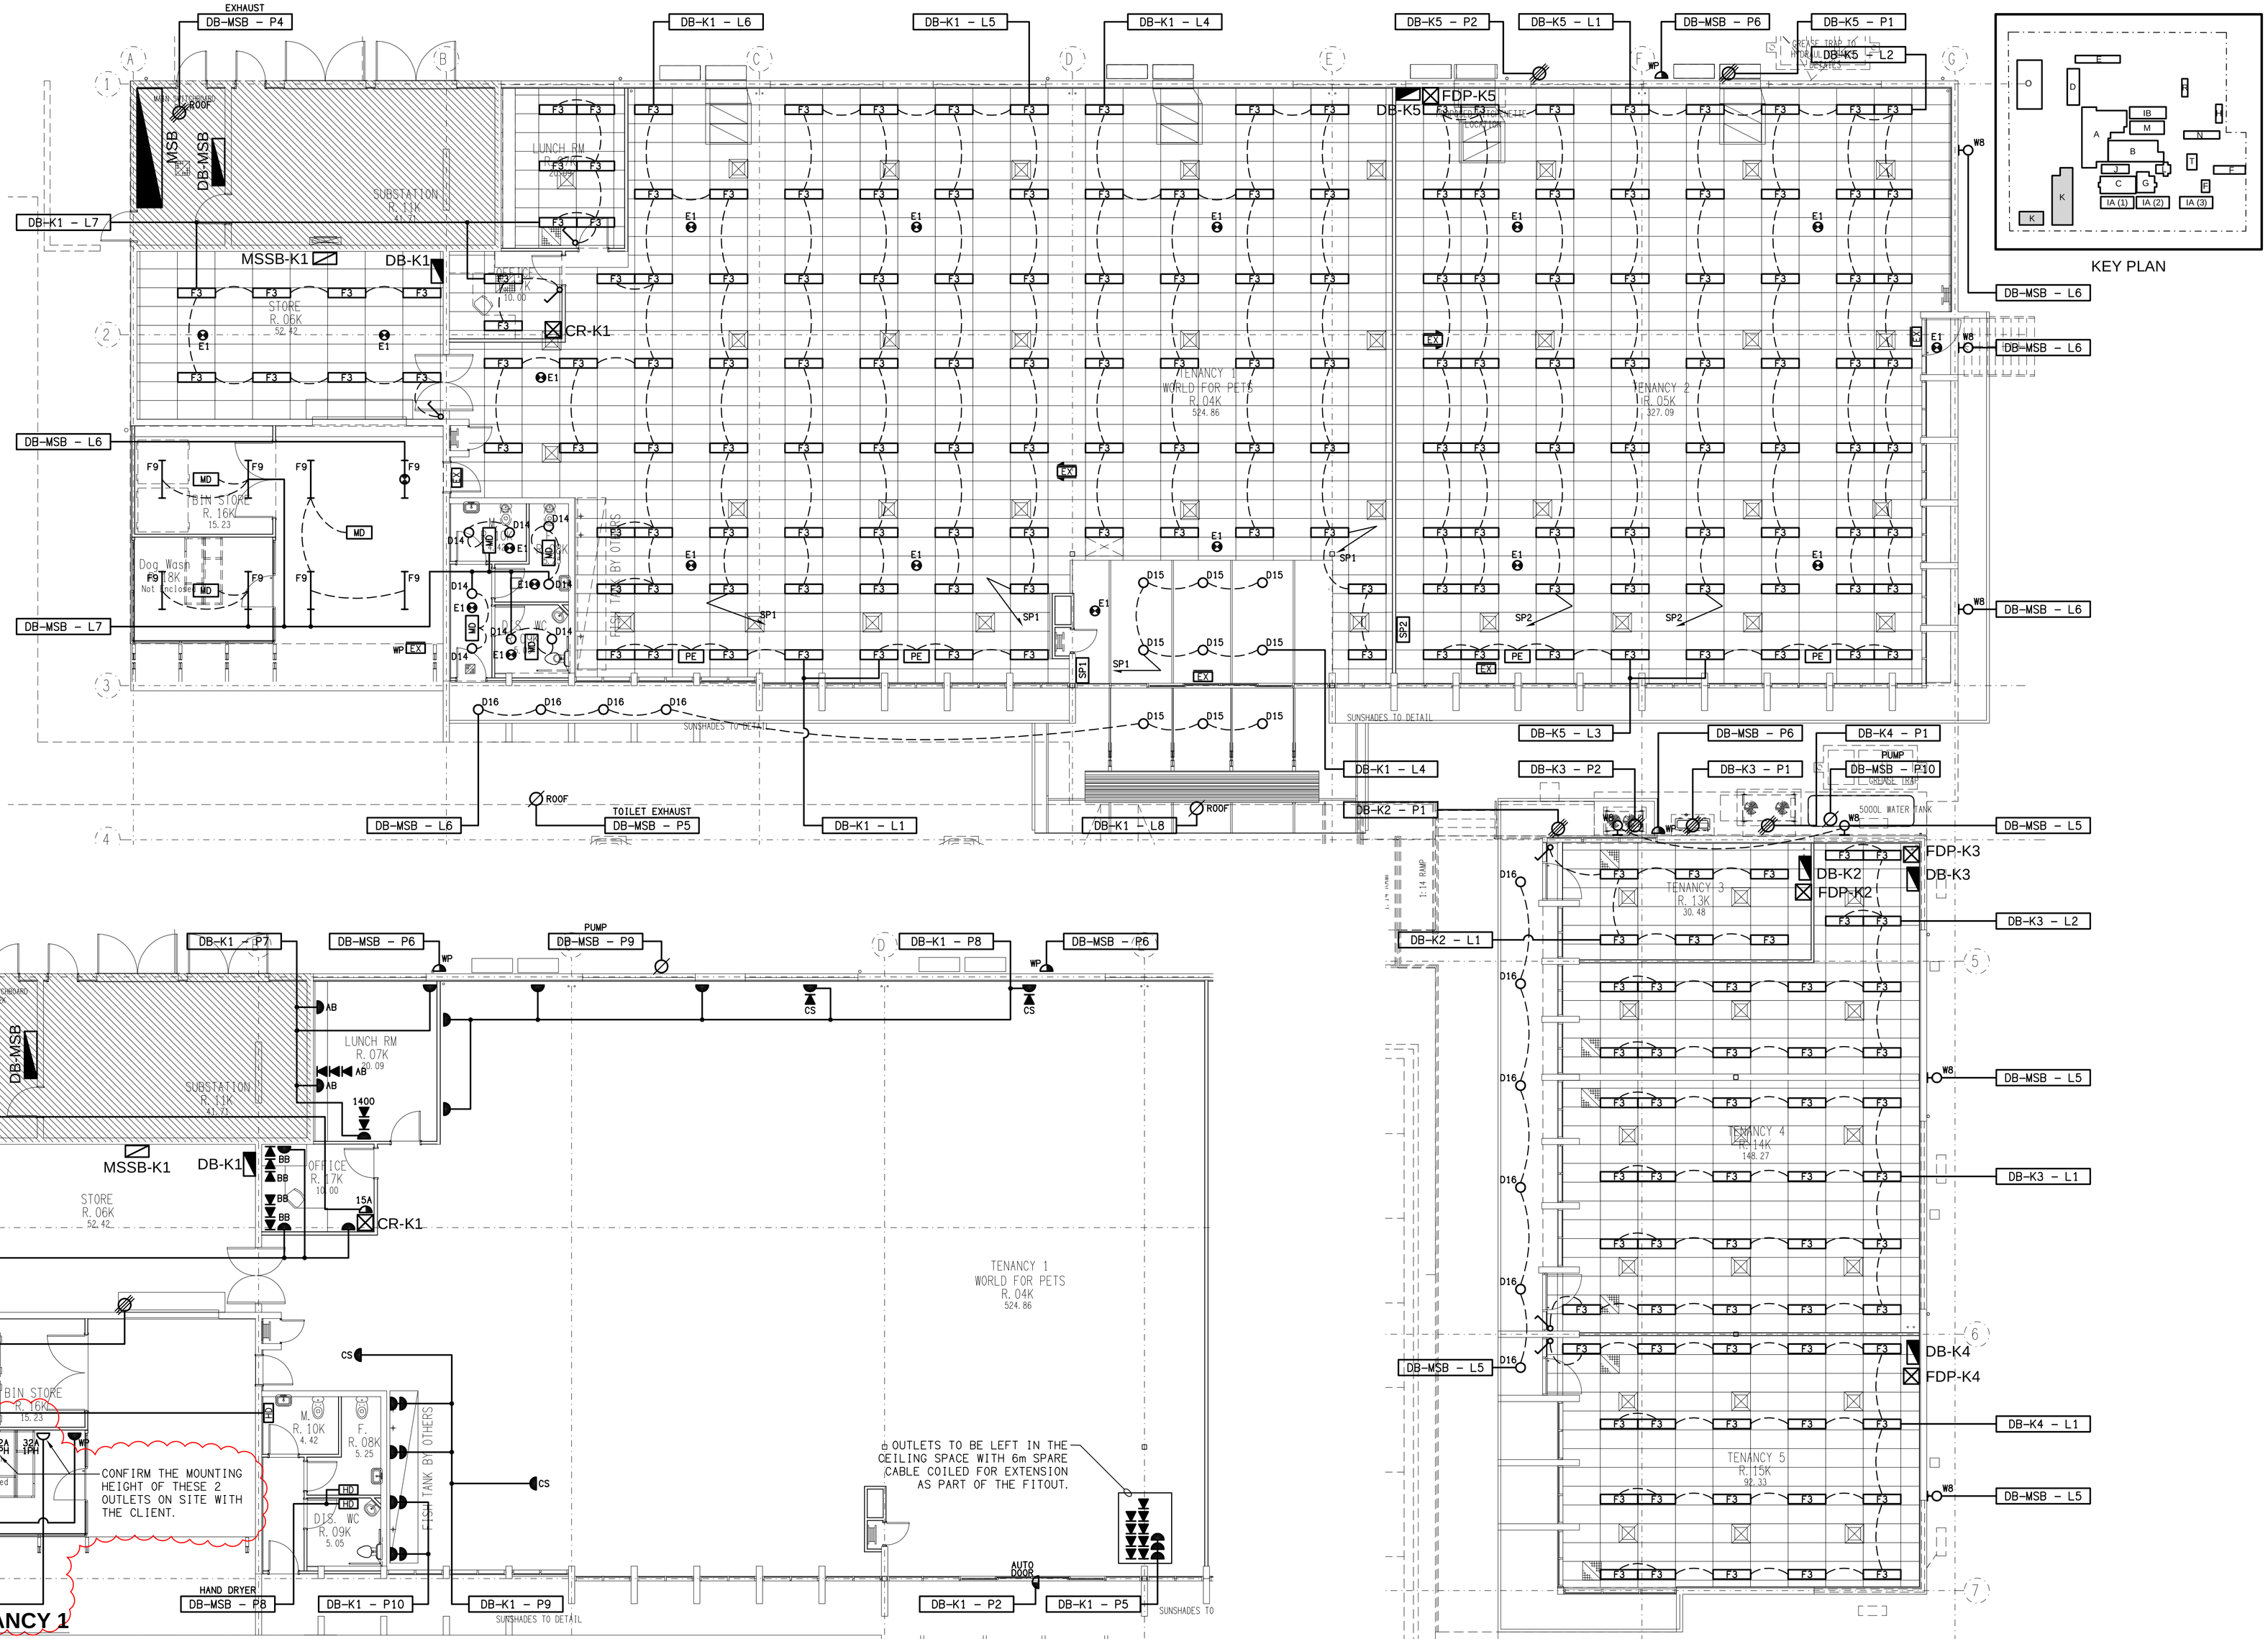

TENANCY 1
FLOOR PLAN (SHOWN SEPARATELY FOR CLARITY)
SCALE 1: 100

REV:	DESCRIPTION:	DATE:
K	CONSTRUCTION	27/09/2011

OFFICE USE ONLY: CHECK: DRAFT: MARKUP:

ELECTRICAL DESIGN GROUP BRISBANE PTY LTD
ACN 092 710 793

TRADING AS:
ELECTRICAL DESIGN GROUP

THE COPYRIGHT OF THIS DRAWING REMAINS THE PROPERTY OF THE ELECTRICAL DESIGN GROUP.

USE FIGURED DIMENSIONS IN PREFERENCE TO SCALE.

ALL DIMENSIONS TO BE VERIFIED ONSITE.

ELECTRICAL DESIGN GROUP
ELECTRICAL BUILDING SERVICES CONSULTANTS

BRISBANE
P.O.Box 15, Sherwood Q.4075
Phone: (07) 3278 4375
Fax: (07) 3716 0222

GOLD COAST
P.O.Box 4249, Ashmore Q.4214
Phone: (07) 5597 7551
Fax: (07) 5597 7552

PROJECT:
RSPCA - WACOL

WACOL STATION ROAD, WACOL

DRAWING:
ELECTRICAL SERVICES
BUILDING K GROUND LEVEL
FLOOR PLAN / REFLECTED CEILING PLAN

SCALE: 1:100 AT A1

PROJECT NO:	DRAWING NO:	REVISION:
C0677a	E14	K