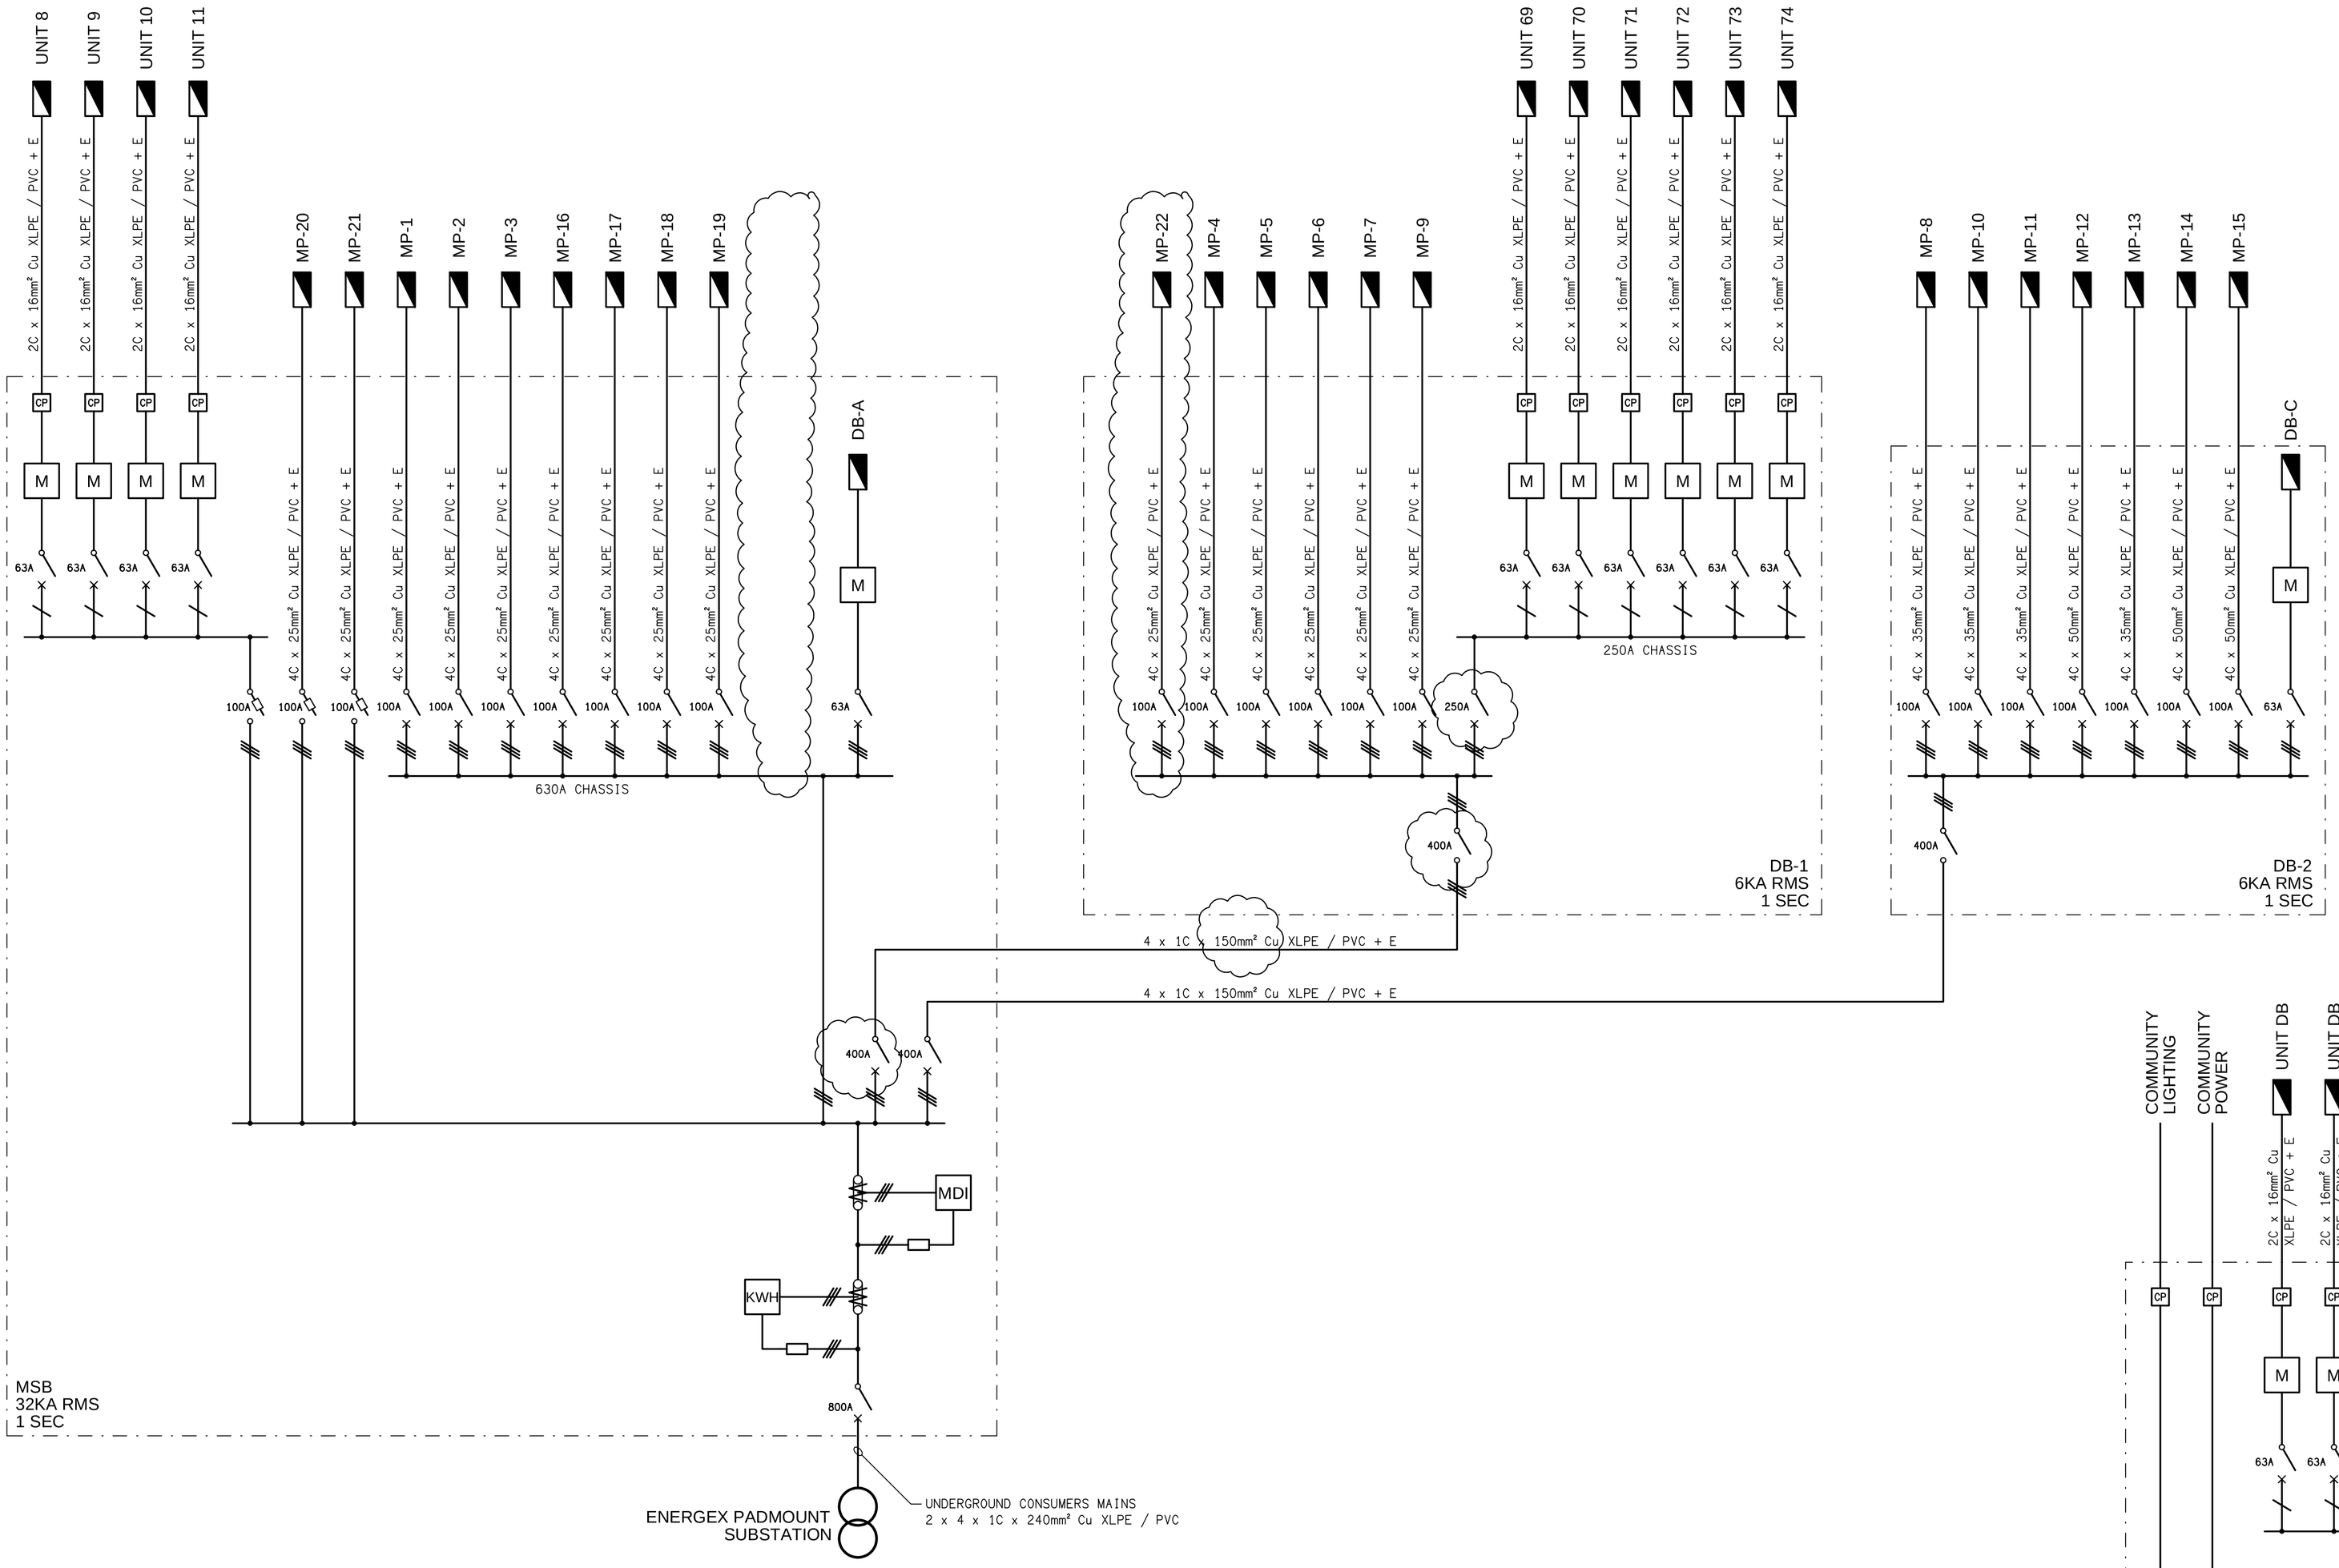

SCHEMATIC

MAIN SWITCHBOARD & DISTRIBUTION BOARDS

NOT TO SCALE

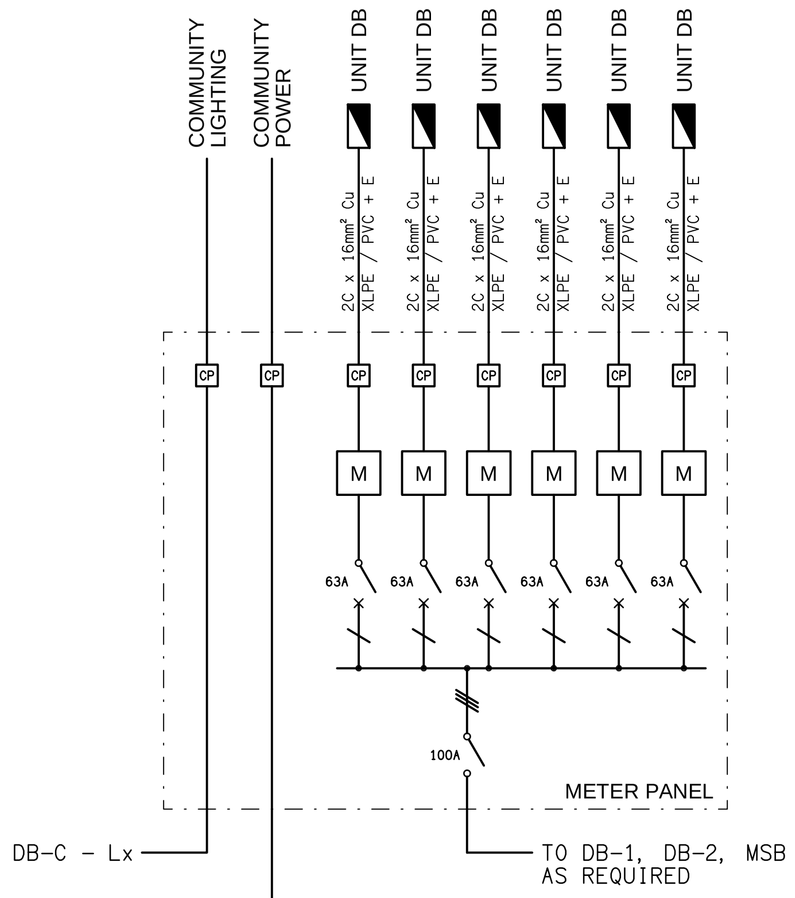

SCHEMATIC

TYPICAL METER PANEL ARRANGEMENT

NOT TO SCALE

REV:	DESCRIPTION:	DATE:
B	CONSTRUCTION	23/03/2010

OFFICE USE ONLY: MARKUP: DRAFT: CHECK:

ELECTRICAL DESIGN GROUP BRISBANE
PTY LTD
ACN 092 710 793

TRADING AS:
ELECTRICAL DESIGN GROUP

THE COPYRIGHT OF THIS DRAWING
REMAINS THE PROPERTY OF THE
ELECTRICAL DESIGN GROUP.

USE FIGURED DIMENSIONS
IN PREFERENCE TO SCALE.

ALL DIMENSIONS TO BE
VERIFIED ONSITE.

ELECTRICAL DESIGN GROUP
ELECTRICAL COMMUNICATIONS FIRE SYSTEMS DESIGNERS

BRISBANE
P.O.Box 15, Sherwood Q.4075
Phone: (07) 3278 4375
Fax: (07) 3716 0222

GOLD COAST
P.O.Box 4249, Ashmore Q.4214
Phone: (07) 5597 7551
Fax: (07) 5597 7552

PROJECT:
129 BARRACK ROAD

MURRARIE

DRAWING:
ELECTRICAL SERVICES
POWER SCHEMATICS

SCALE: NOT TO SCALE AT A1

PROJECT NO:	DRAWING NO:	REVISION:
C0757a	E02	B